

RECONSTRUCT EXIST. ASPHALT PAVEMENT AS REQUIRED TO CONNECT TO PROPOSED CONCRETE STREET PAVEMENT

INSTALL 5" H.M.A.C. PAVEMENT AS SHOWN

20' ES-BEAM CONCRETE PAVEMENT

REMOVE & DISPOSE OF EXIST. ASPHALT PAVEMENT

CONSTRUCT 10' WIDE PARALLEL PARKING

INSTALL 5" H.M.A.C. AS SHOWN

NOTE:
CONTRACTOR IS TO CONFORM TO THE S.D.H. & P.T. TRAFFIC CONTROL PLAN SHEET 151-TCP(1-15) BEFORE N. ALAMO STREET CAN BE CONNECTED TO S.H. 66. (SEE CITY ENGINEER FOR TRAFFIC CONTROL SHEET)

Install: 33 L.F. of 1 1/2" P.V.C. Conduit for Lighting (2.5' below Prop. TC Grade)

Install: 51 L.F. of 1 1/2" P.V.C. Conduit for Lighting (2.5' below Prop. TC Grade)

CONSTRUCT 5' WIDE CHICAGO ANTIQUE BRICK / LITICHRONE FINISHED SIDEWALK

EXISTING CURB TO BE REMOVED

Install: 42 L.F. of 1 1/2" P.V.C. Conduit for Lighting (2.5' below Prop. TC)

DETAIL "A"
Scale: 1" = 5.0'

5" THK. 3000 P.S.I. Reinf. Concrete Sidewalk
Sand Cushion
#3 Re-Bars @ 24" Ctrs. Each Way

SECTION "A-A"
No Scale

Chicago Antique Brick
Mortar



SECTION "B-B"
No Scale

NOTES:

1. Chicago Antique Brick to be supplied by City of Rockwall & installed by Contractor
2. Litichrome to be supplied by City of Rockwall & installed by Contractor.
3. City will provide Electrical Conduit & Post for Lighting. Contractor will install.

LEGEND:

- POWER POLE
- TELEPHONE BOX
- TELEPHONE M.H.
- GAS METER
- FIRE HYDRANT
- WATER METER
- WATER VALVE
- SEWER M.H.

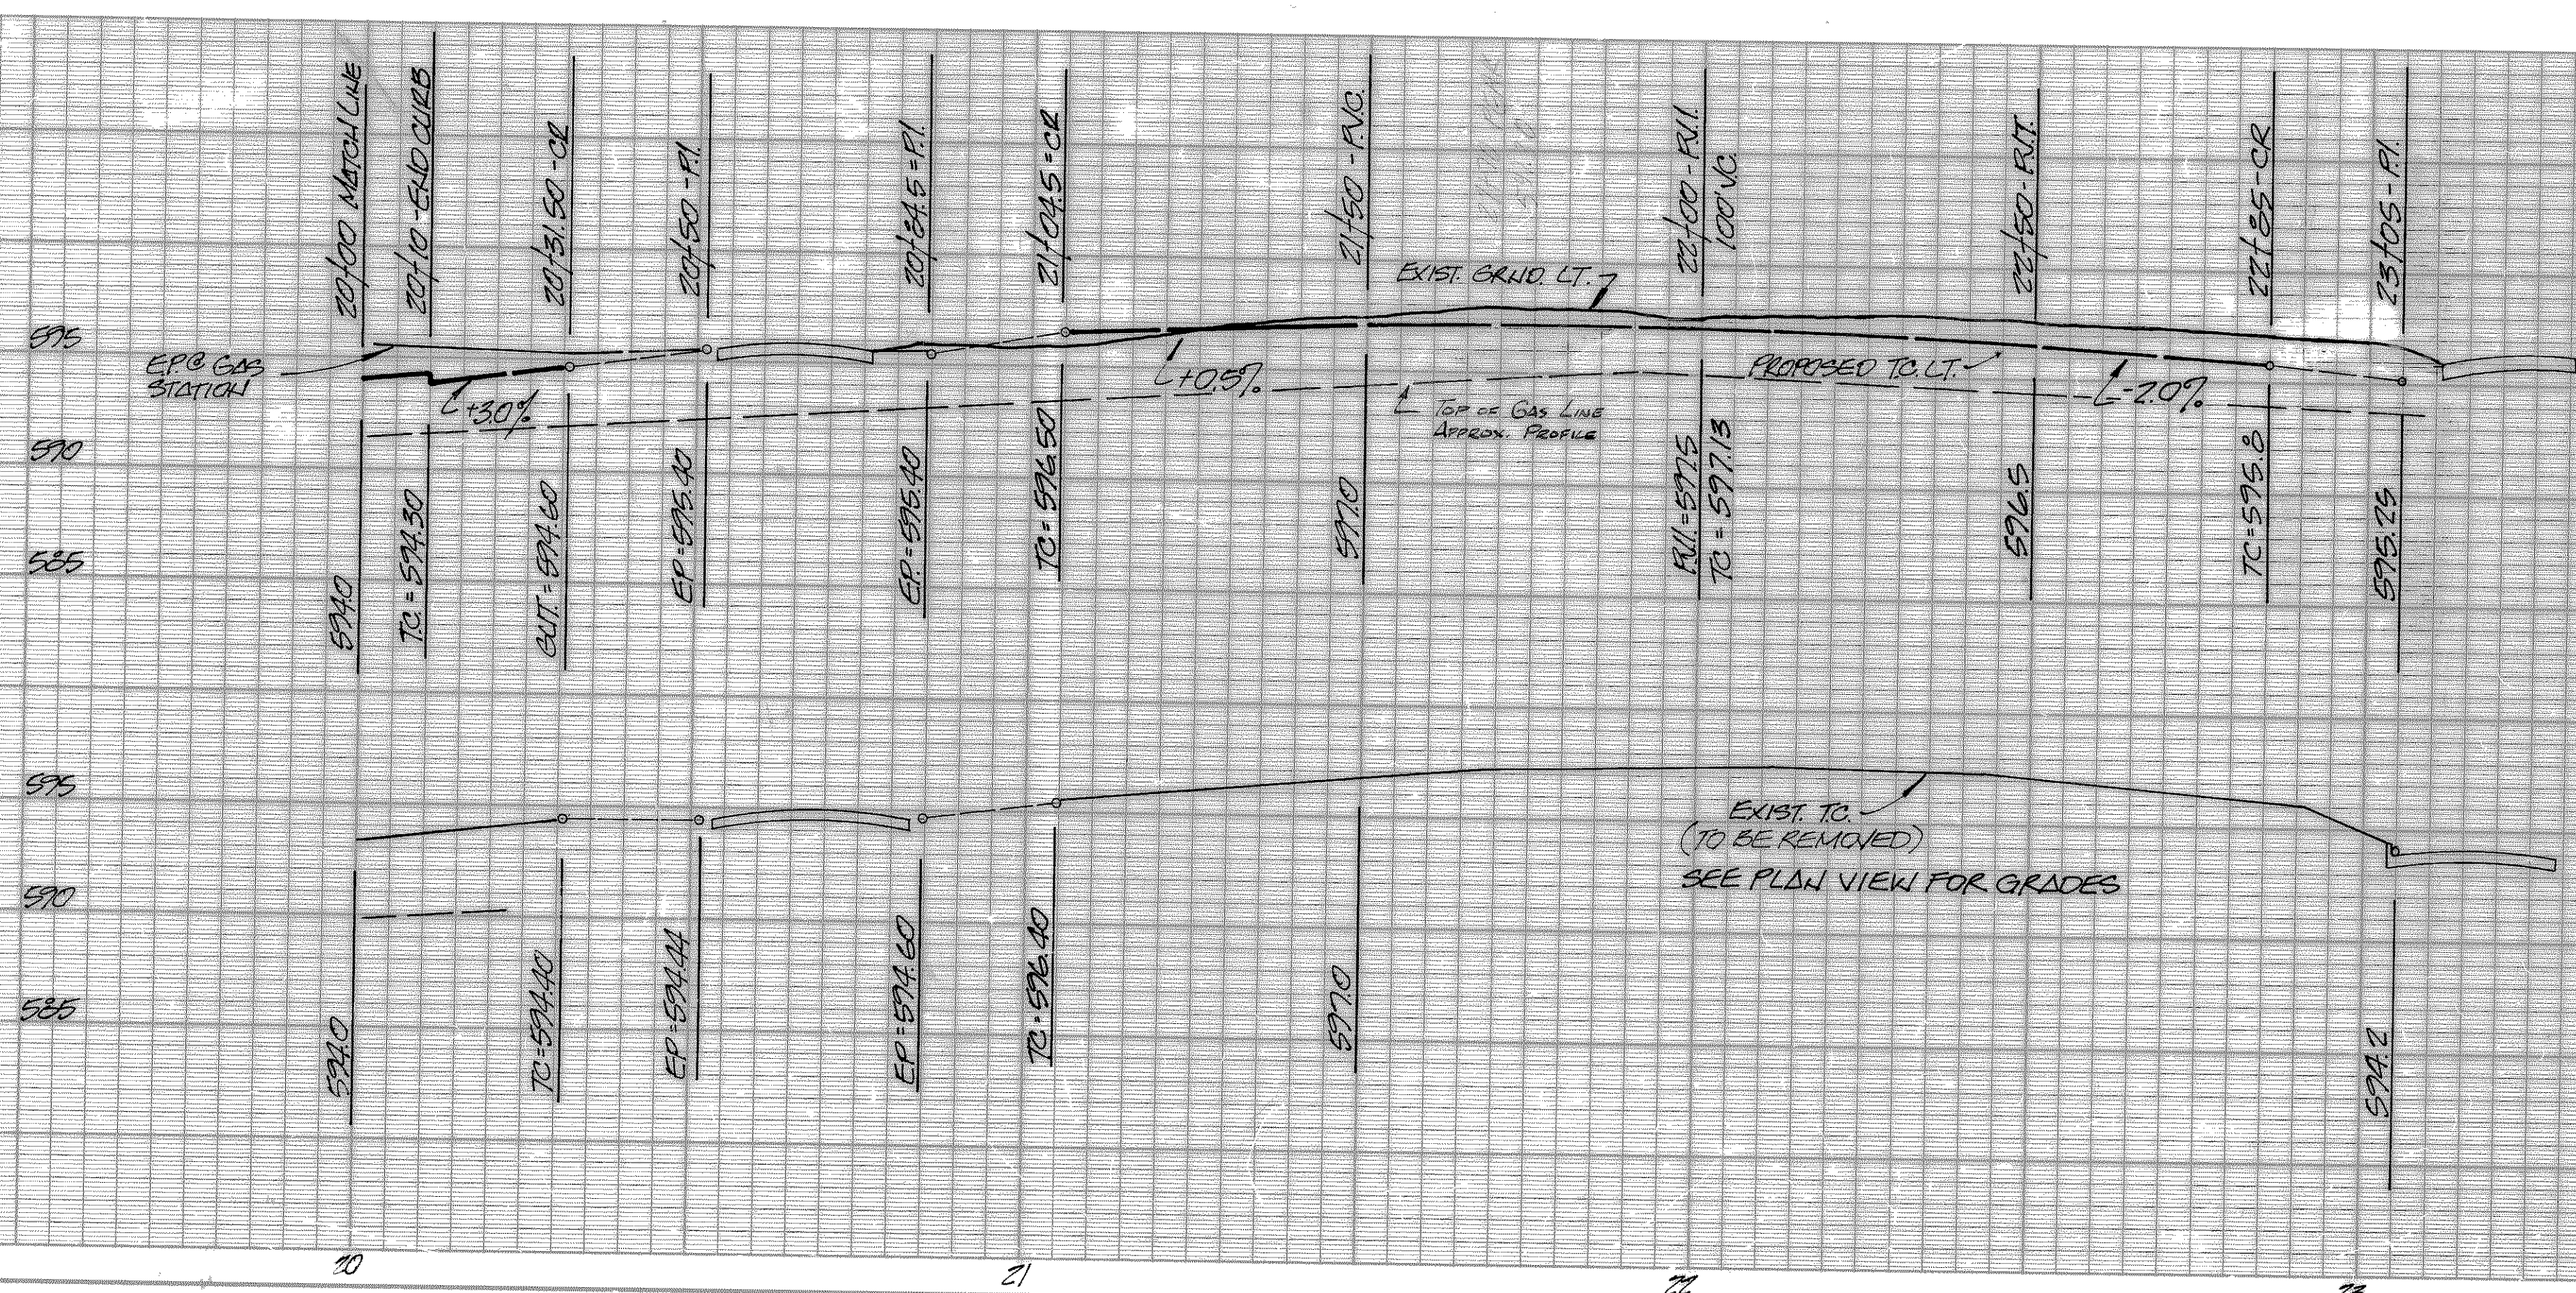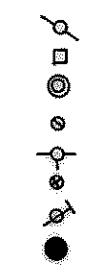

B.M. BOLT ON FIRE HYD. @ S.W. CORNER OF HEATH ST. & N. ALAMO ST.
ELEV. = 570.77

Added 1 1/2" P.V.C. Conduit for Lighting w/ Construction notes 8/21/89

REVISION NO.	REMARKS	DATE
1	Changed Parking on West side of N. Alamo from Head-in to Parallel Parking. Added to Sidewalk & Details	8/10/89
PAVING IMPROVEMENTS NORTH ALAMO STREET		
CITY OF ROCKWALL, TEXAS 205 W. RUSK STREET 214-722-1111		
DESIGNED: W.L.D.	SCALE: NOTED	
DRAWN: W.L.D.	APPROVED: <i>W.L. Dwyer</i>	
JOB NO. 87008	DATE: 7-87	SHEET NO. 12



SCALE: 1" = 20'-4"
1" = 6'-6"