

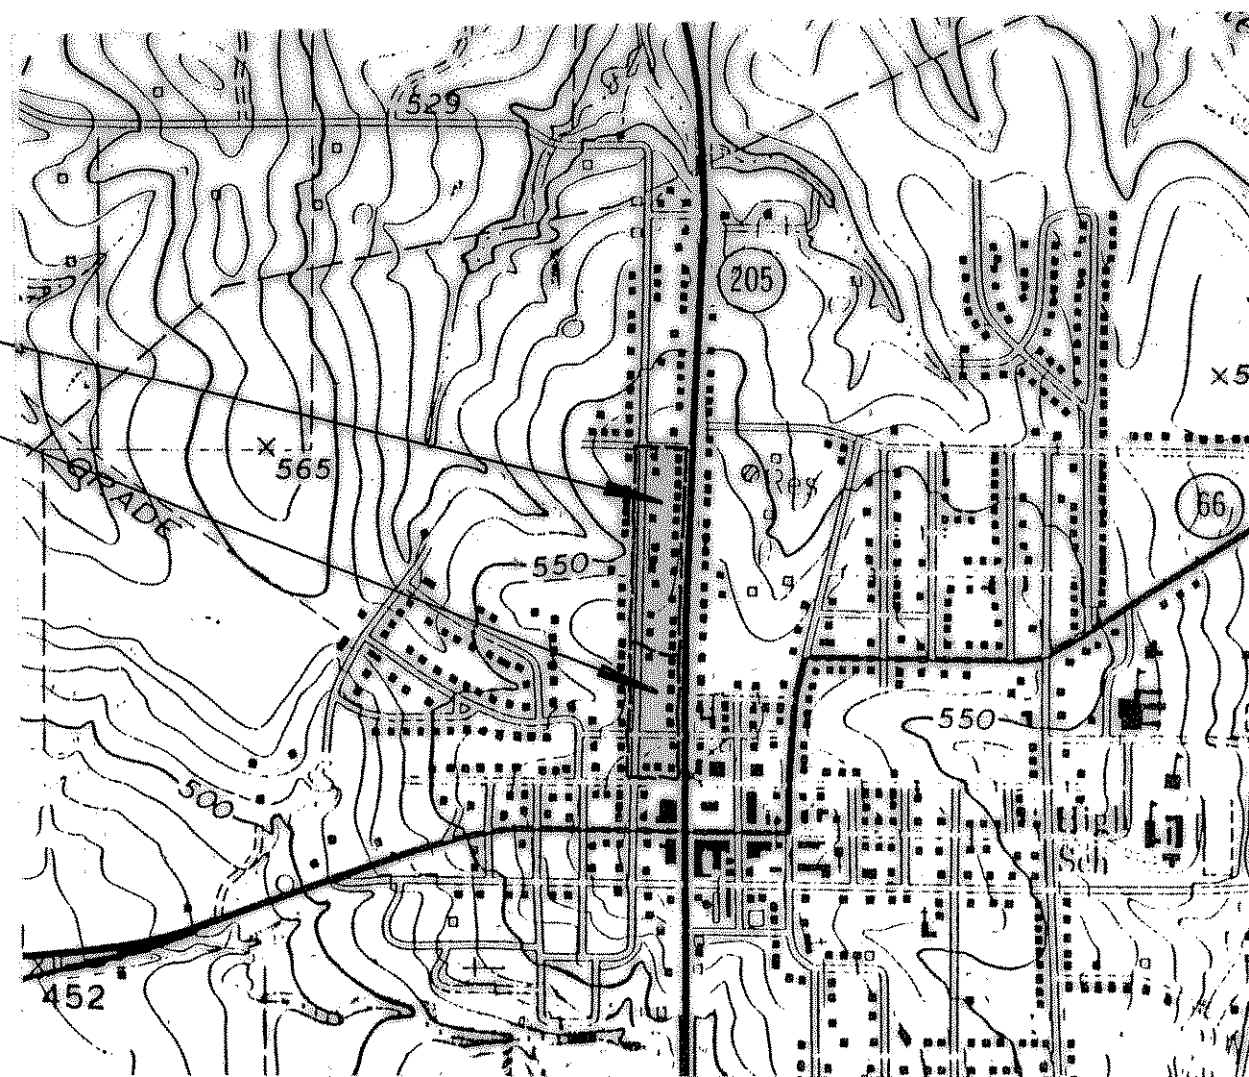
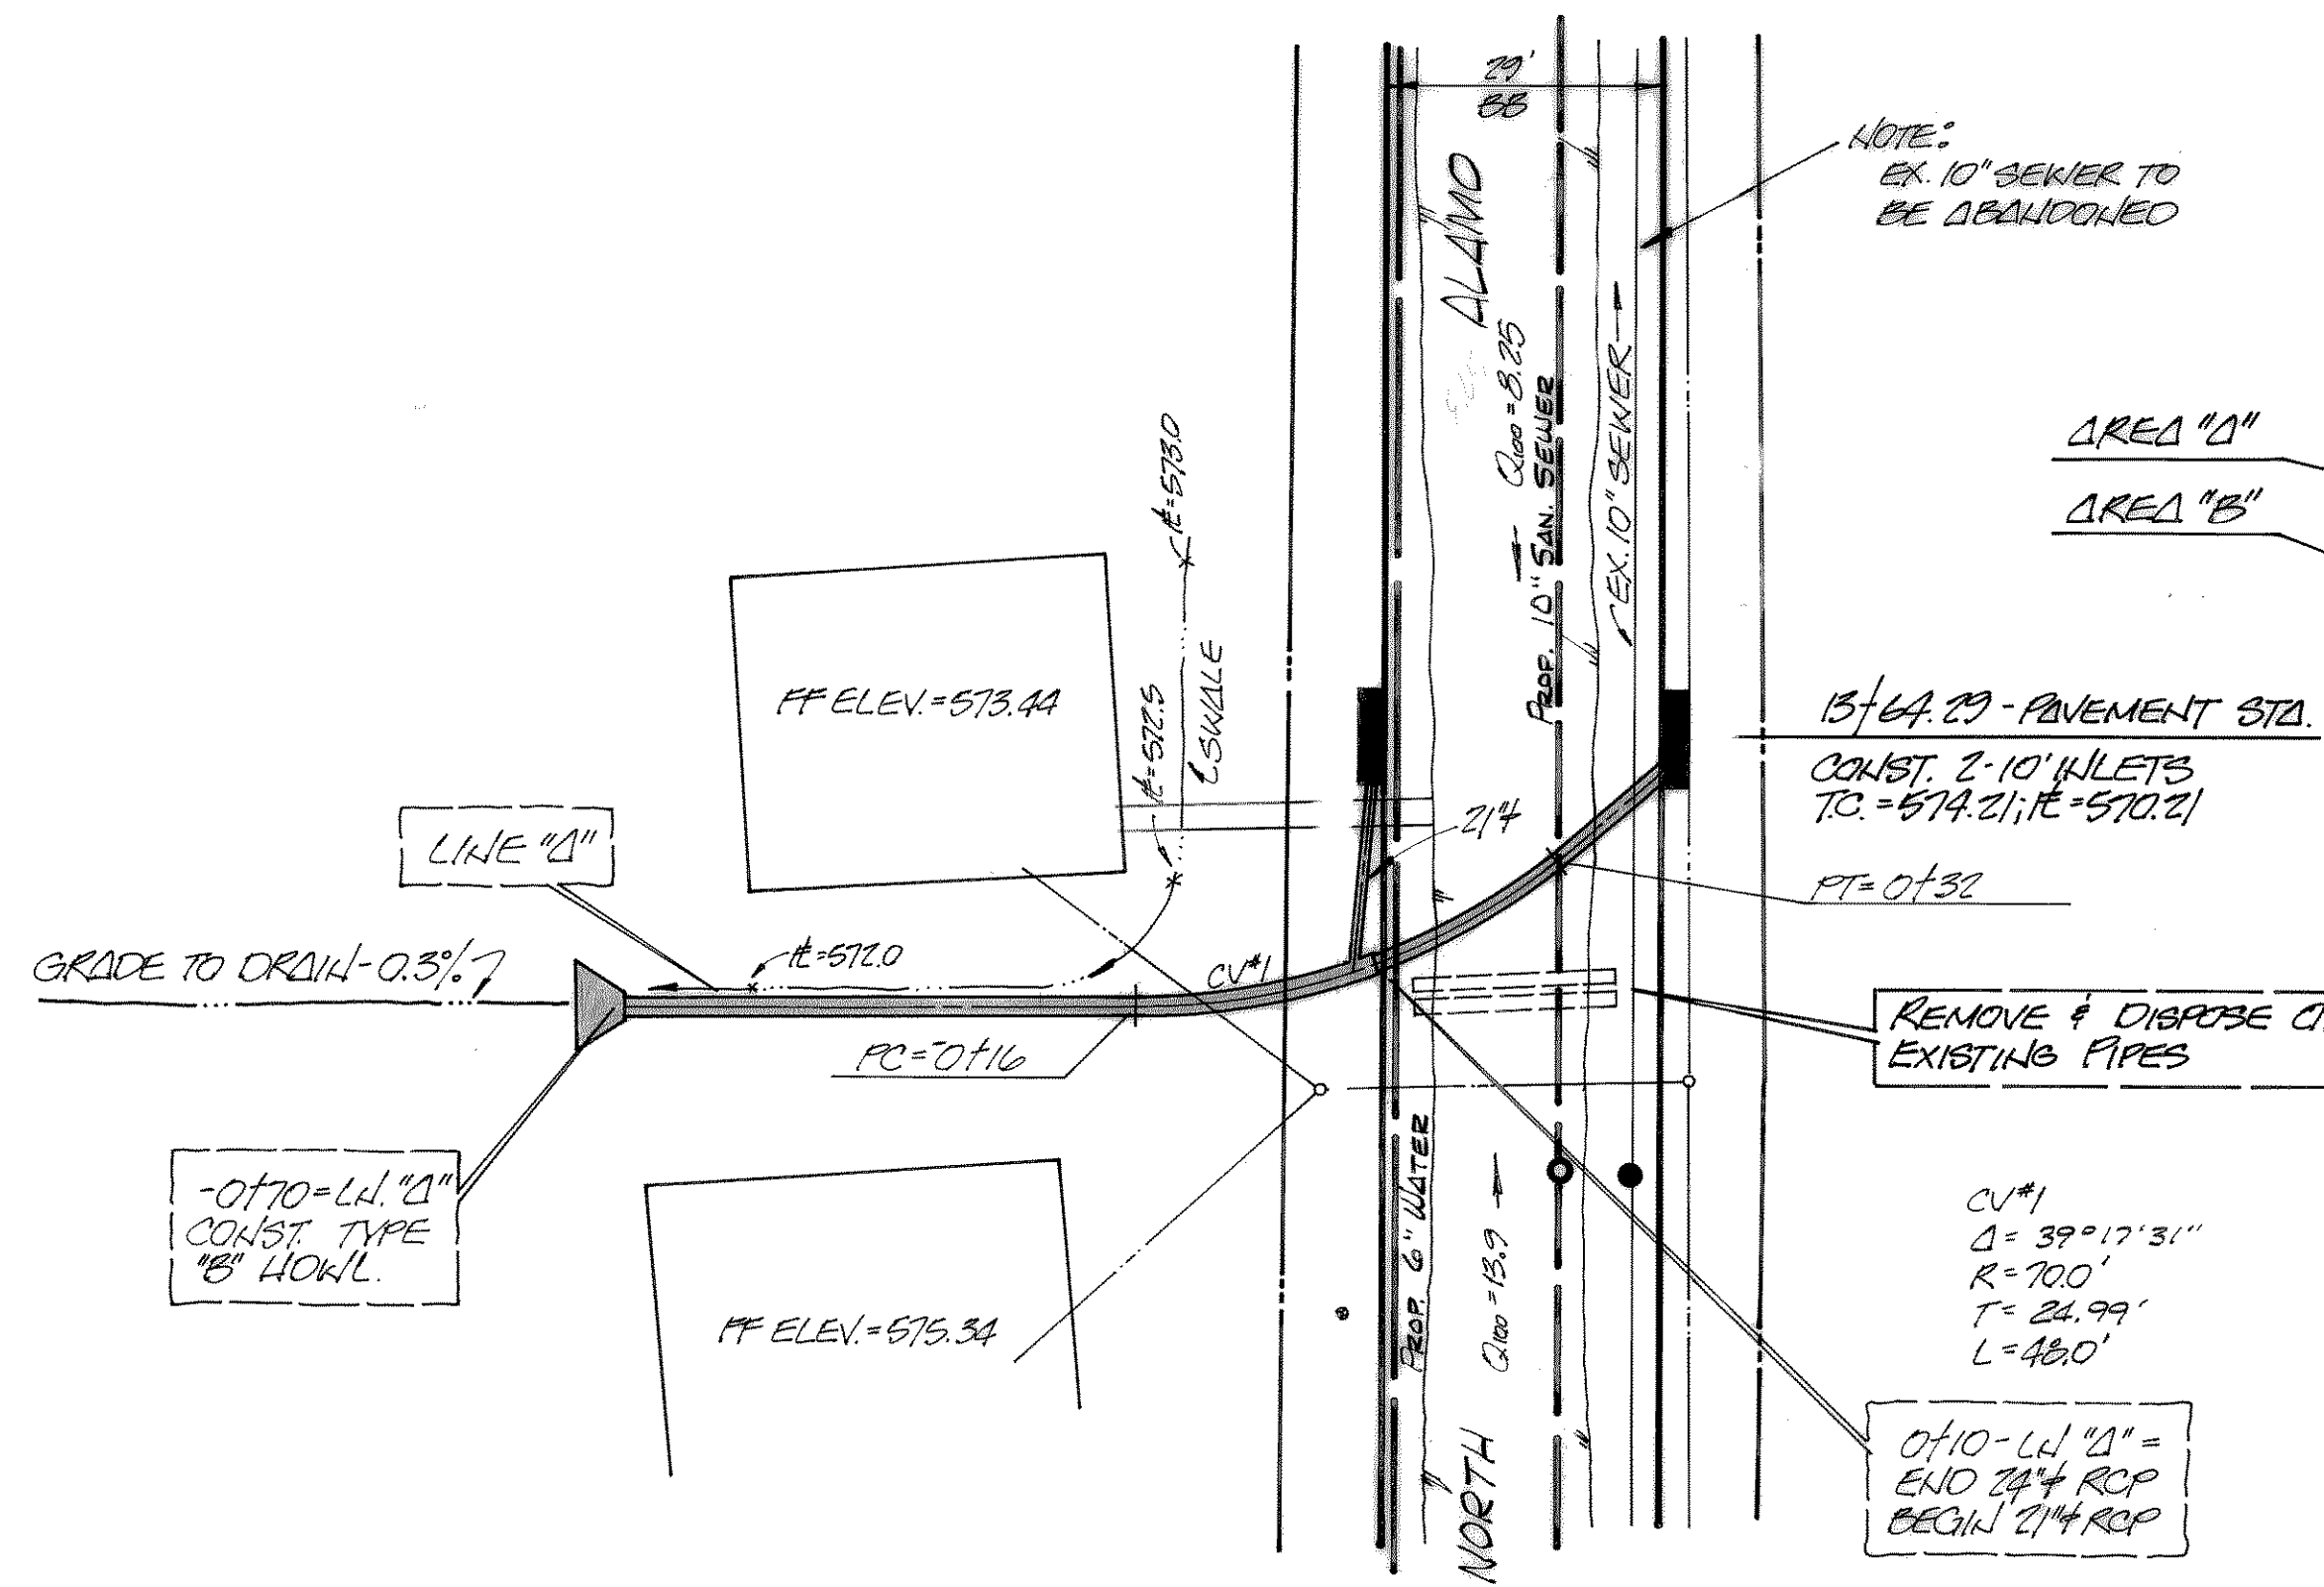


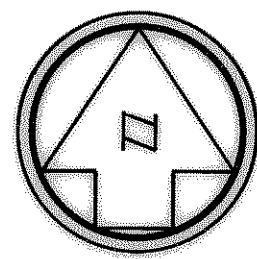


AREA "A"	AREA "B"
TC=12.3 MIN.	TC=12.8 MIN.
SCORE= 6.0	SCORE= 4.3
C=0.5	C=0.5
I ₁₀₀ =8.6	I ₁₀₀ =8.4
Q ₁₀₀ =18.6	Q ₁₀₀ =25.2
I ₁₀₀ =10.7	I ₁₀₀ =10.3
Q ₁₀₀ =32.10	Q ₁₀₀ =22.15

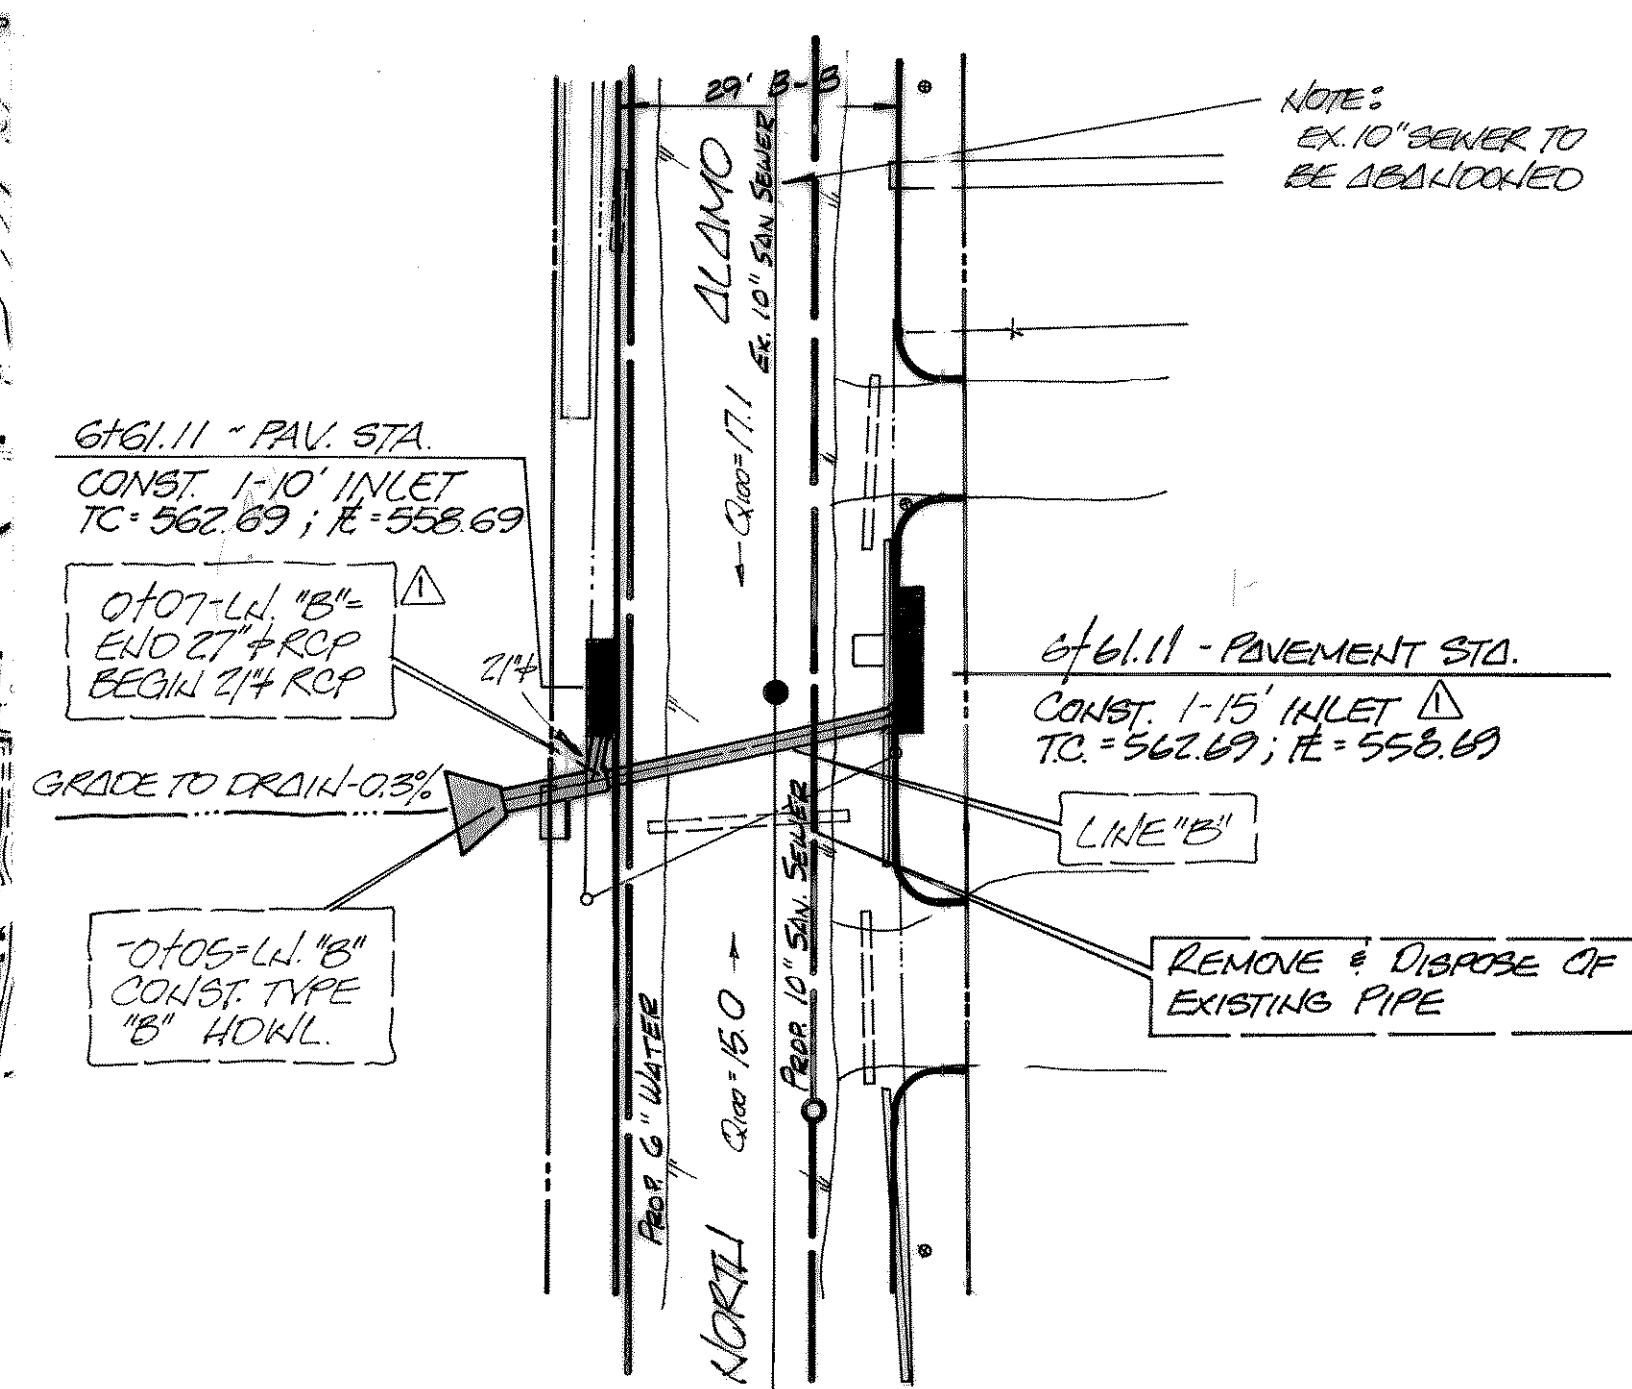

- NOTE: ALL EXISTING DRAINAGE SYSTEMS TO BE REMOVED & DISPOSED FROM CONSTRUCTION SITE.
- NOTE: INSTALL PROPOSED WATER MAIN AS REQUIRED TO CLEAR PROPOSED STORM SEWER MAIN.
- NOTE: ALL STORM SEWER PIPE SHALL BE CLASS III REINFORCED CONCRETE PIPE AS PER THE STD'S
- NOTE: CONTRACTOR SHALL HAVE ONE LANE OF N. ALAMO STREET TO REMAIN OPEN FOR TRAFFIC AT ALL TIMES.

NOTE: CONTRACTOR TO INSTALL PROP WATER & SEWER AS REQUIRED TO CLEAR PROP STORM SEWER INLETS.

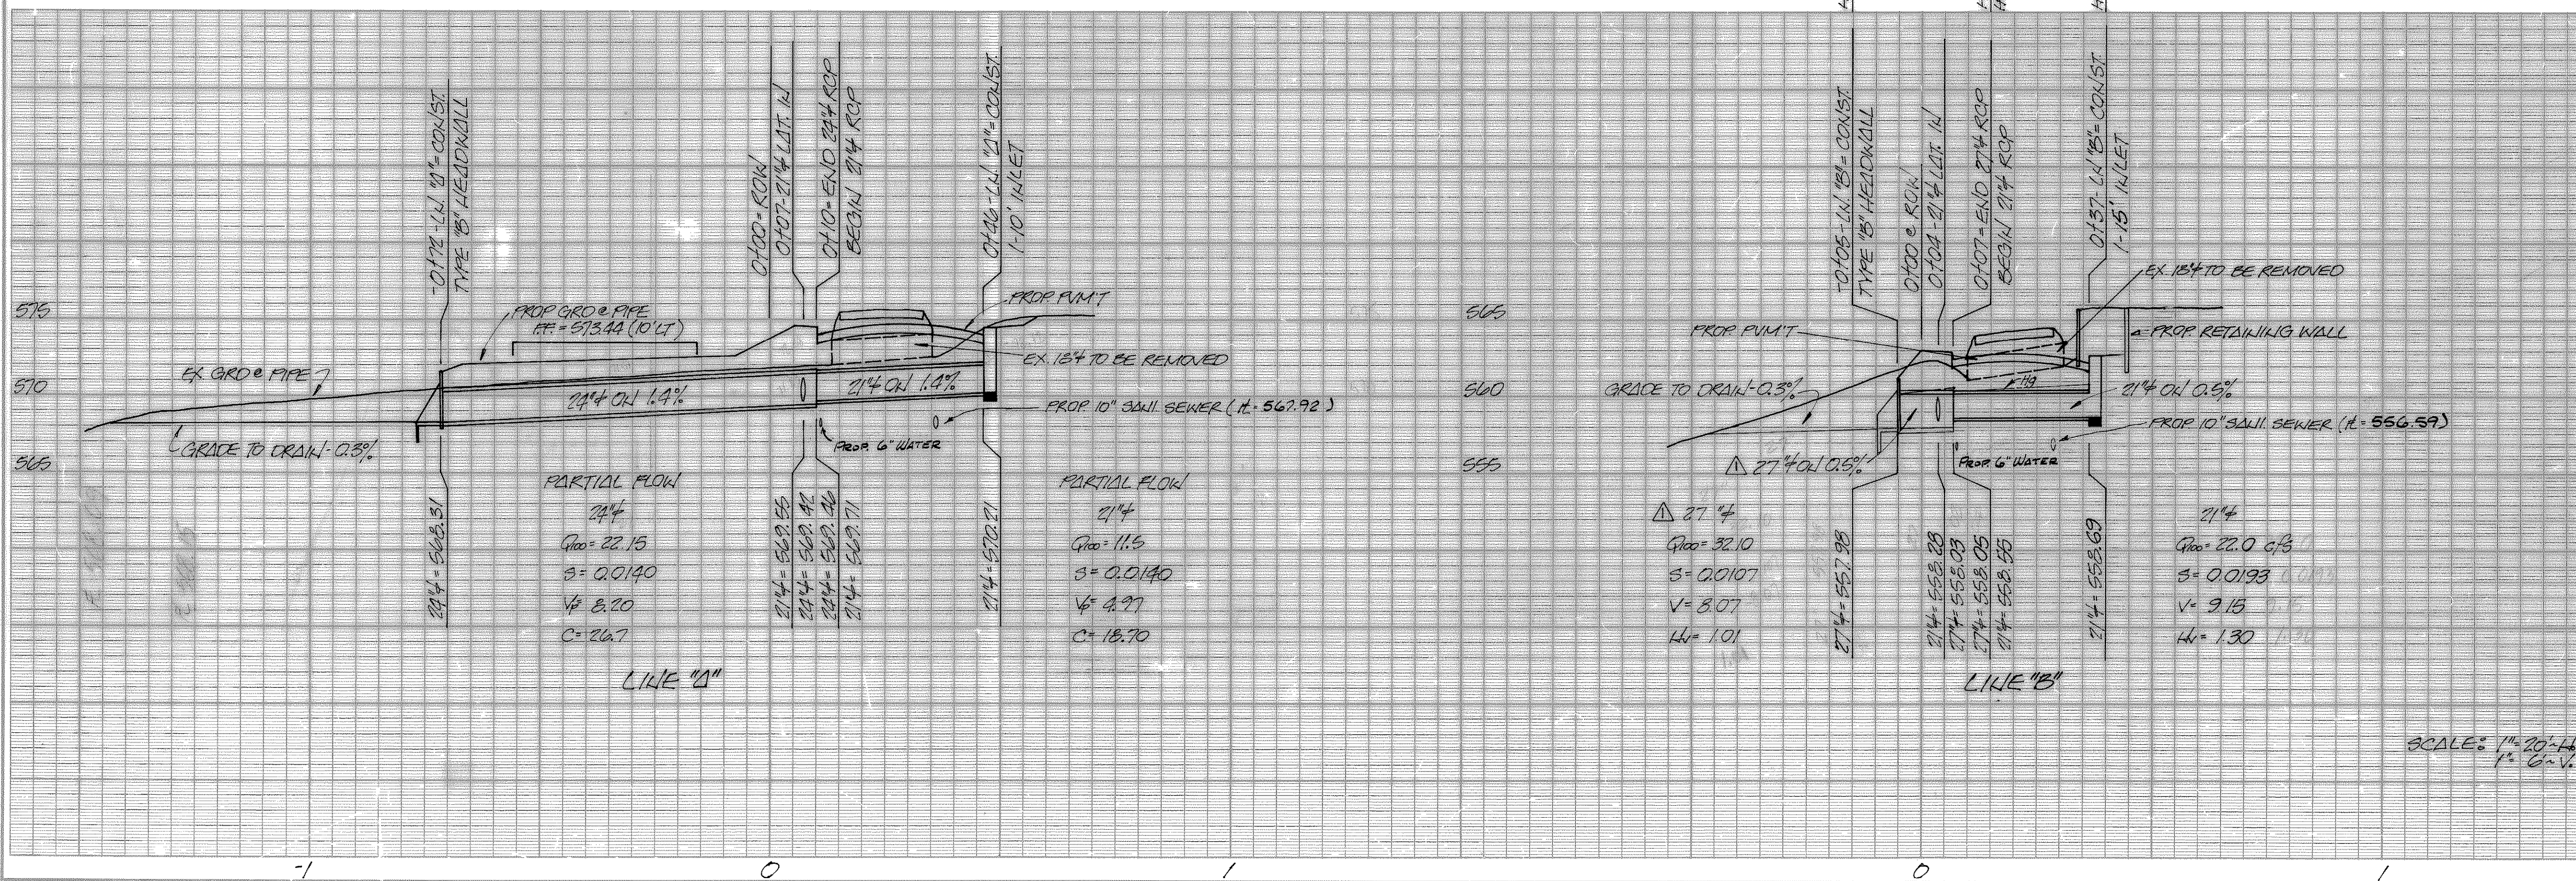

BENCH MARK:
BOLT ON EUL & S.W. CORNER
OF HEATH ST. & N. ALAMO ST.
ELEV=570.77

REVISION	NO.	REMARKS	DATE
	1	Changed Ln. 'B' from 20' to 27' ROP & changed 10' to 15' inlet	7/5/89
STORM SEWER IMPROVEMENT NORTH ALAMO STREET			
CITY OF ROCKWALL, TEXAS 205 W. RUSK STREET 214-722-1111		DESIGNED: W.L.D. SCALE: NOTED	
DRAWN: W.L.D.		APPROVED: [Signature]	
JOB NO. 87008		DATE: 7-87 SHEET NO. 27	

