


"no ref logical", "no ref name", "no ref levels"
 "no ref logical", "no ref name", "no ref levels"

BORDER, 335401GBDR1.DGN, 1-4,5,7,21-30,32,34-45,47-59,61,62
 01, 335401TBU01.DGN, 1-63
 "no ref logical", "no ref name", "no ref levels"
 "no ref logical", "no ref name", "no ref levels"
 "no ref logical", "no ref name", "no ref levels"
 "no ref logical", "no ref name", "no ref levels"

theressa
 SCALE=9.998000
 PRF ROTATION=90.000000
 f:\ib\142\FULL.TBL

h:\proj\01335401\dgn\335401TBU03.DGN
 DATE: 1/10/2006
 TIME: 09:37:20

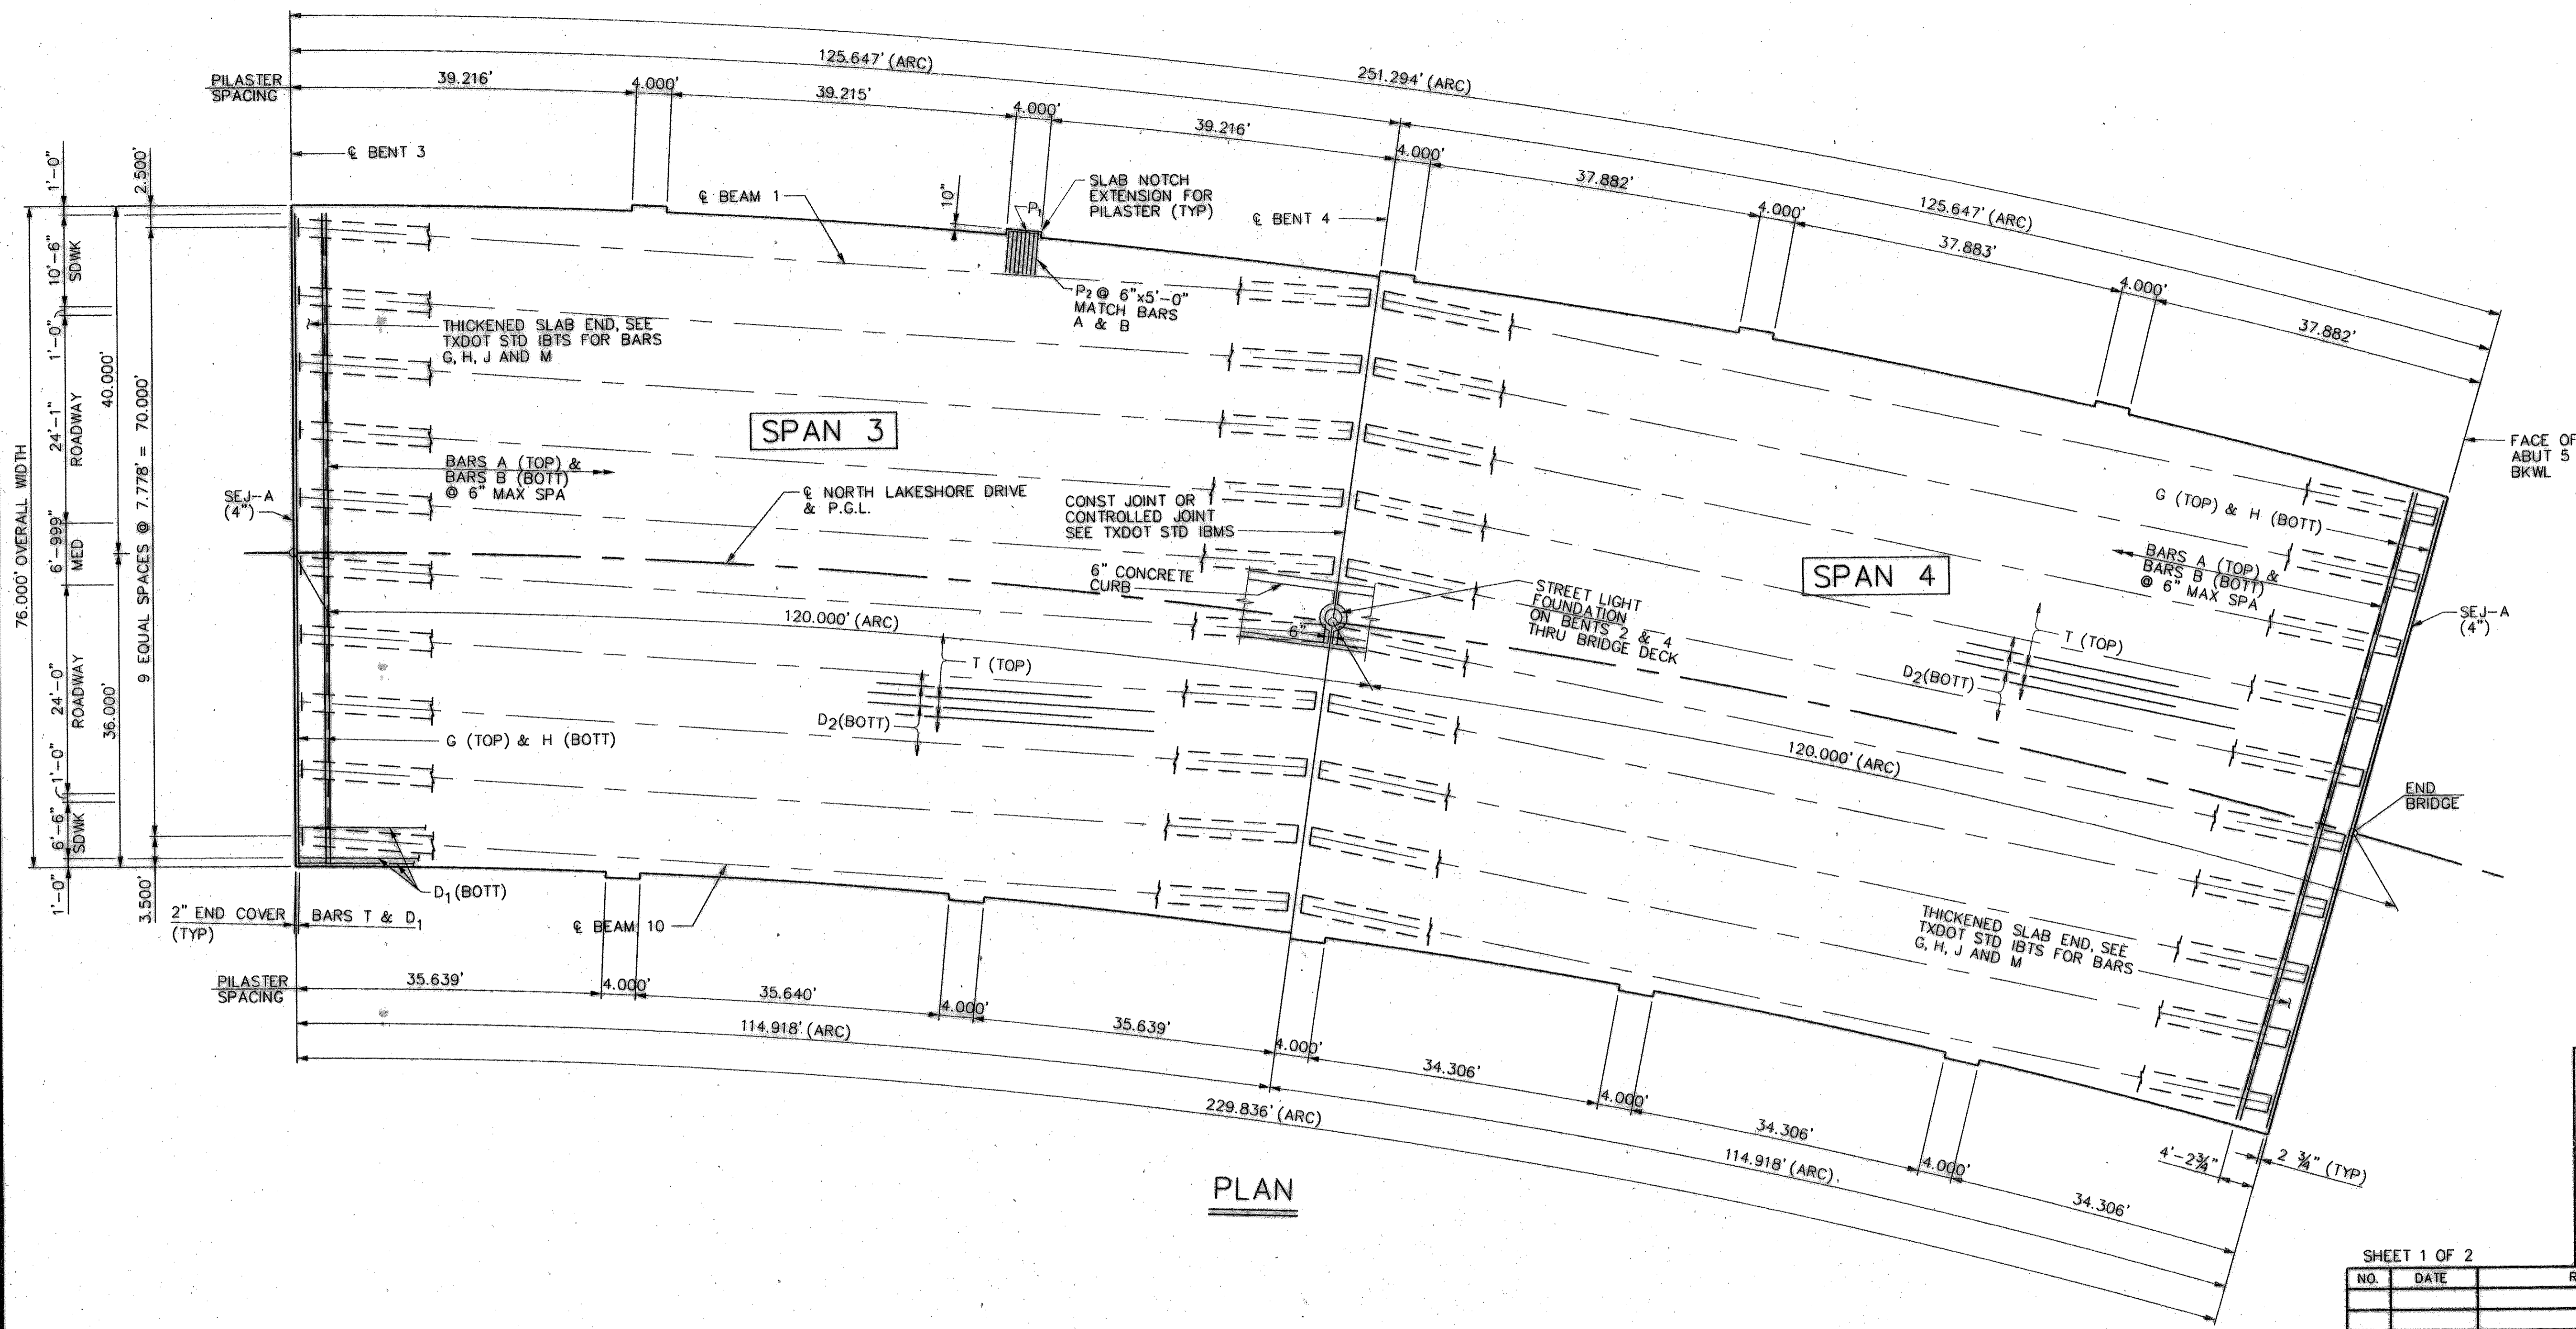

PLAN

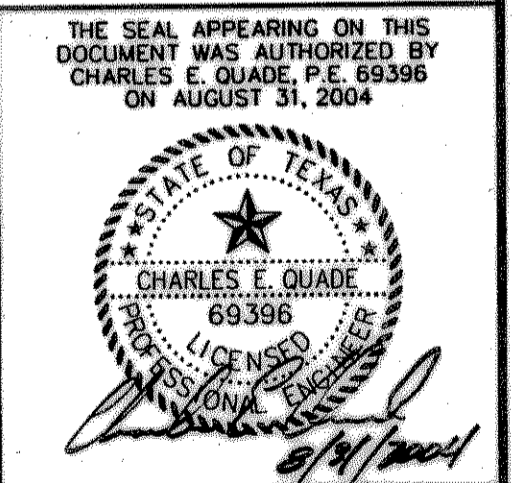

SHEET 1 OF 2

NO.	DATE	REVISIONS	APPROVED
240.00' PRESTRESSED CONC. BEAM UNIT 2			
NORTH LAKESHORE DRIVE			
NAPA DRIVE TO S.H. 205			
HUITT-ZOLLARS			
CITY OF ROCKWALL, TEXAS			
DESIGN	DRAWN	APPR.	SCALE
HZI	HZI	CEQ	1"=10'
DATE	PROJECT NO.	NO.	
AUGUST 2004	01-3354-01	B-13	

RECORD DRAWINGS JANUARY 12, 2006
 THIS RECORD DOCUMENT HAS BEEN PREPARED BASED ON INFORMATION PROVIDED BY OTHERS. THE CONSULTANT HAS NOT VERIFIED THE ACCURACY AND/OR COMPLETENESS OF THIS INFORMATION AND SHALL NOT BE RESPONSIBLE FOR ANY ERRORS OR OMISSIONS THAT MAY BE INCORPORATED AS A RESULT OF ERRONEOUS INFORMATION PROVIDED BY OTHERS.