


"no ref logical", "no ref name", "no ref levels"  
 "no ref logical", "no ref name", "no ref levels"  

BORDER: 335401GBDR1.DGN, 1-4.6.7.20-30.32.34-45.47-59.61.62  
 "no ref logical", "no ref name", "no ref levels"  
 "no ref logical", "no ref name", "no ref levels"  
theressa  
 SCALE=8.000021  
 PRF ROTATION=90.000000  
 f:\h\h\2\FULL.TBL

h:\pro\01335401\dgn\335401TAB01.DGN  
 DATE: 1/10/2006  
 TIME: 09:36:08





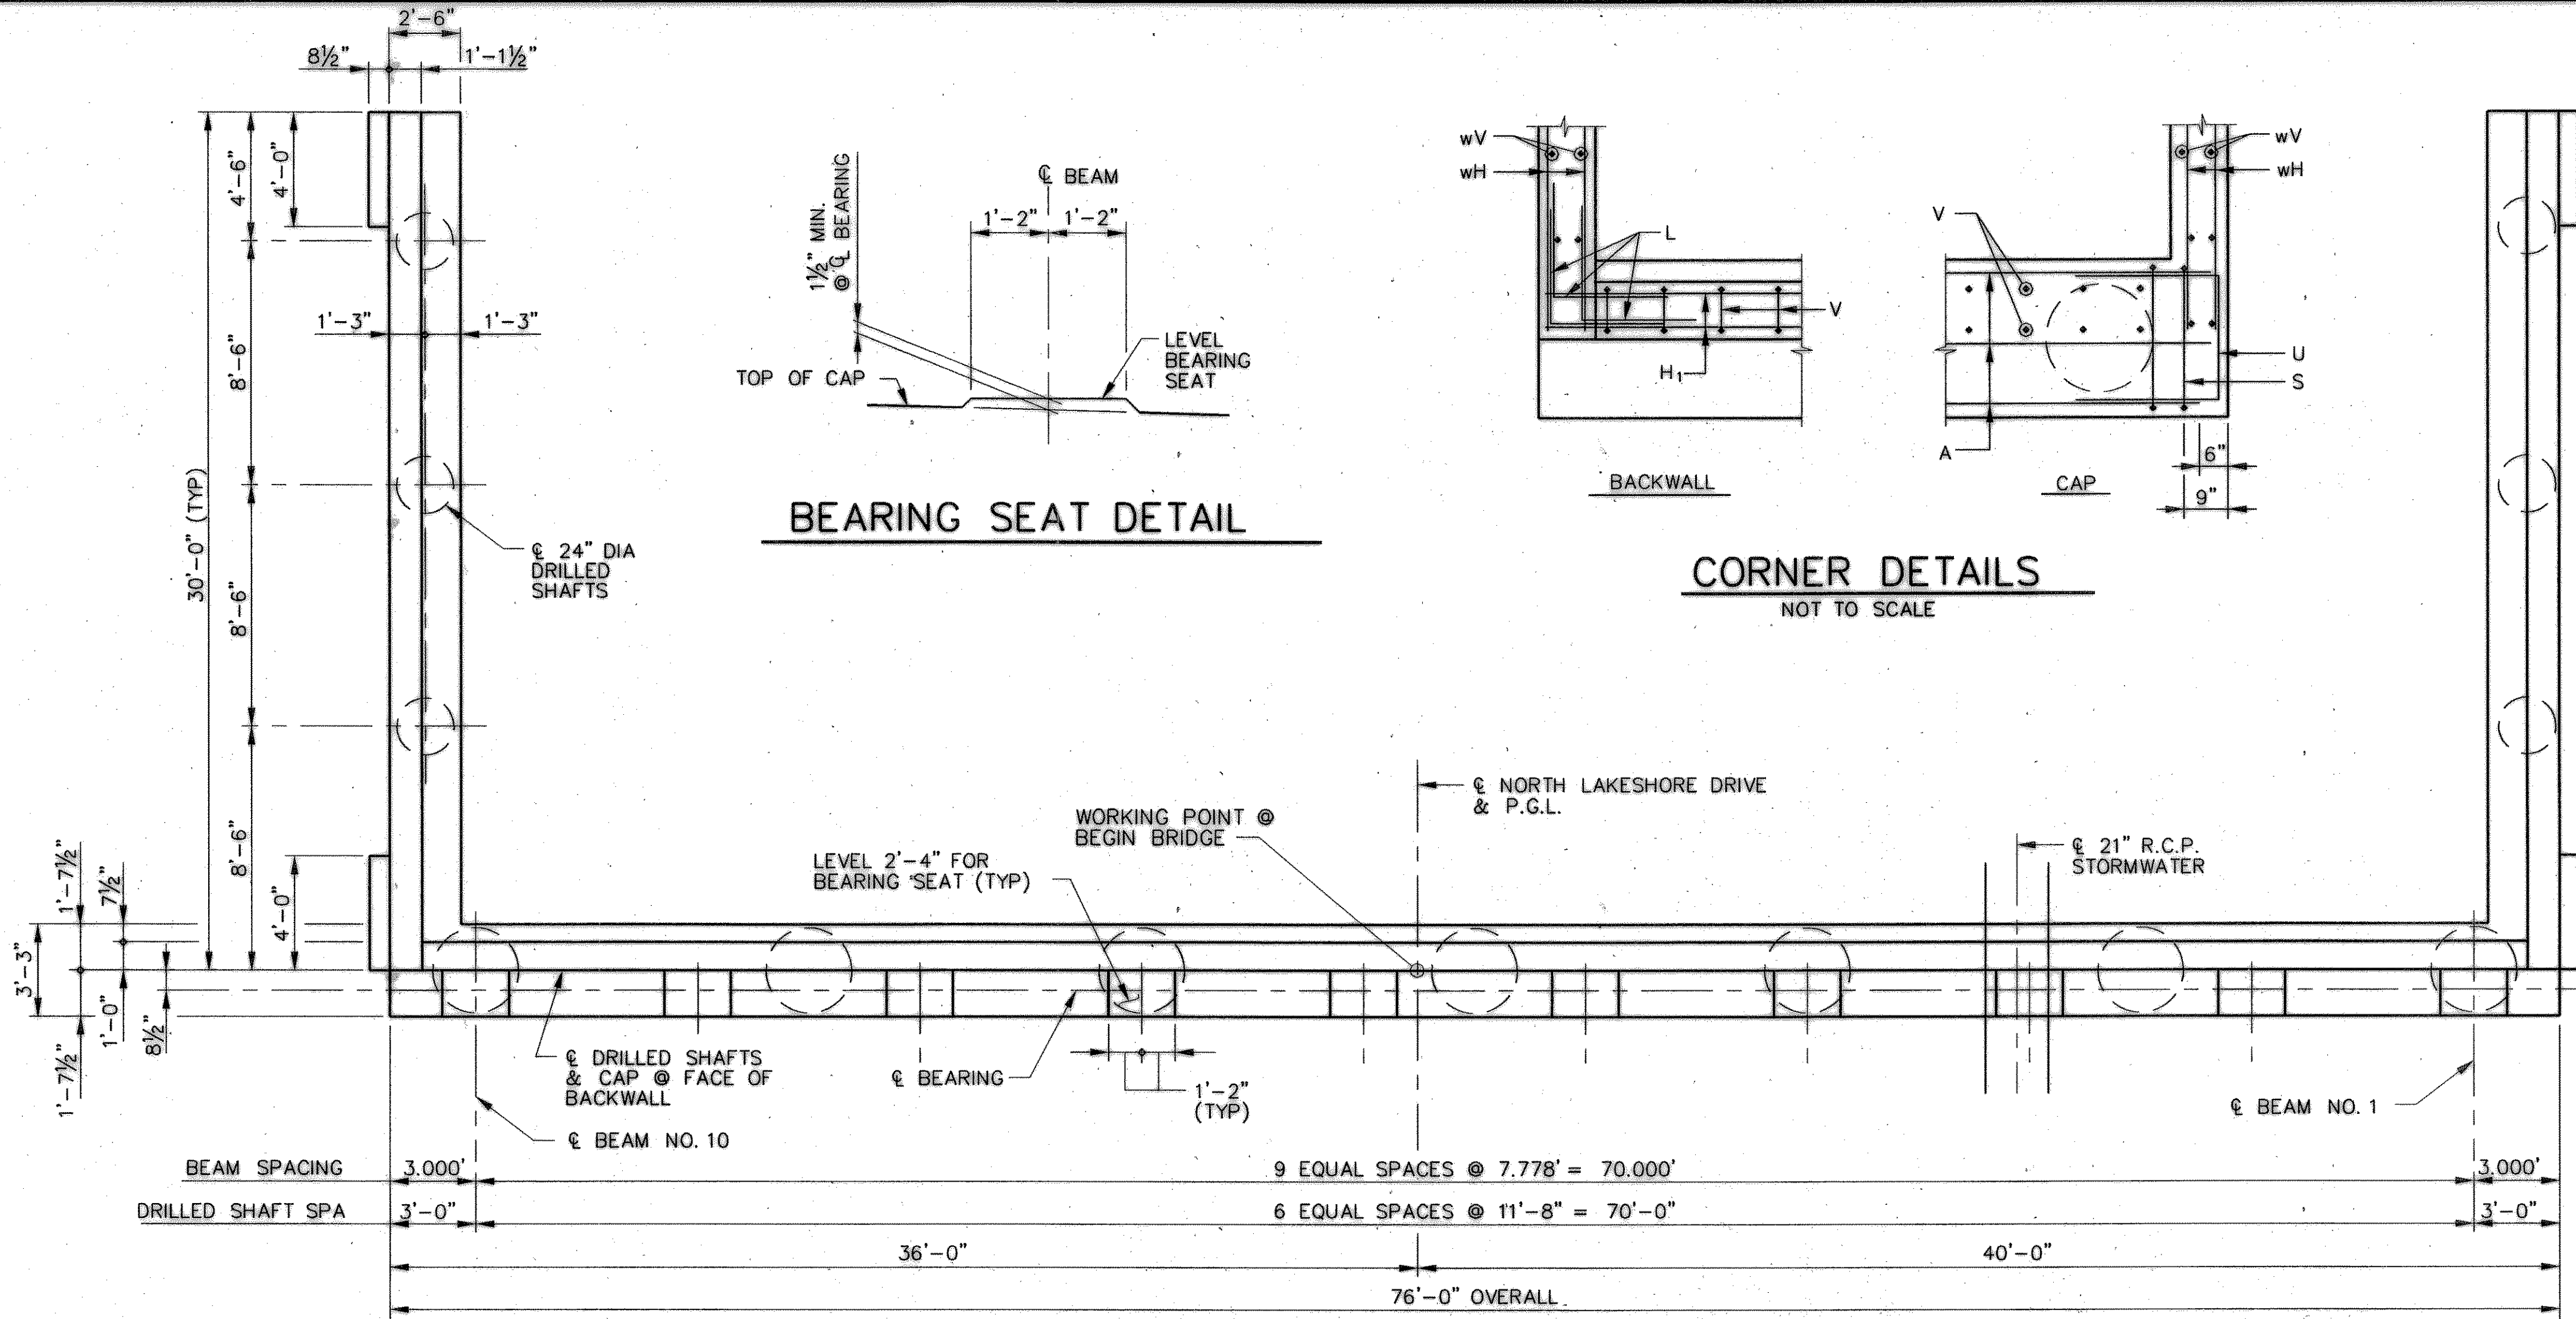


**PLAN**  
 SCALE: 1/4" = 1'-0"

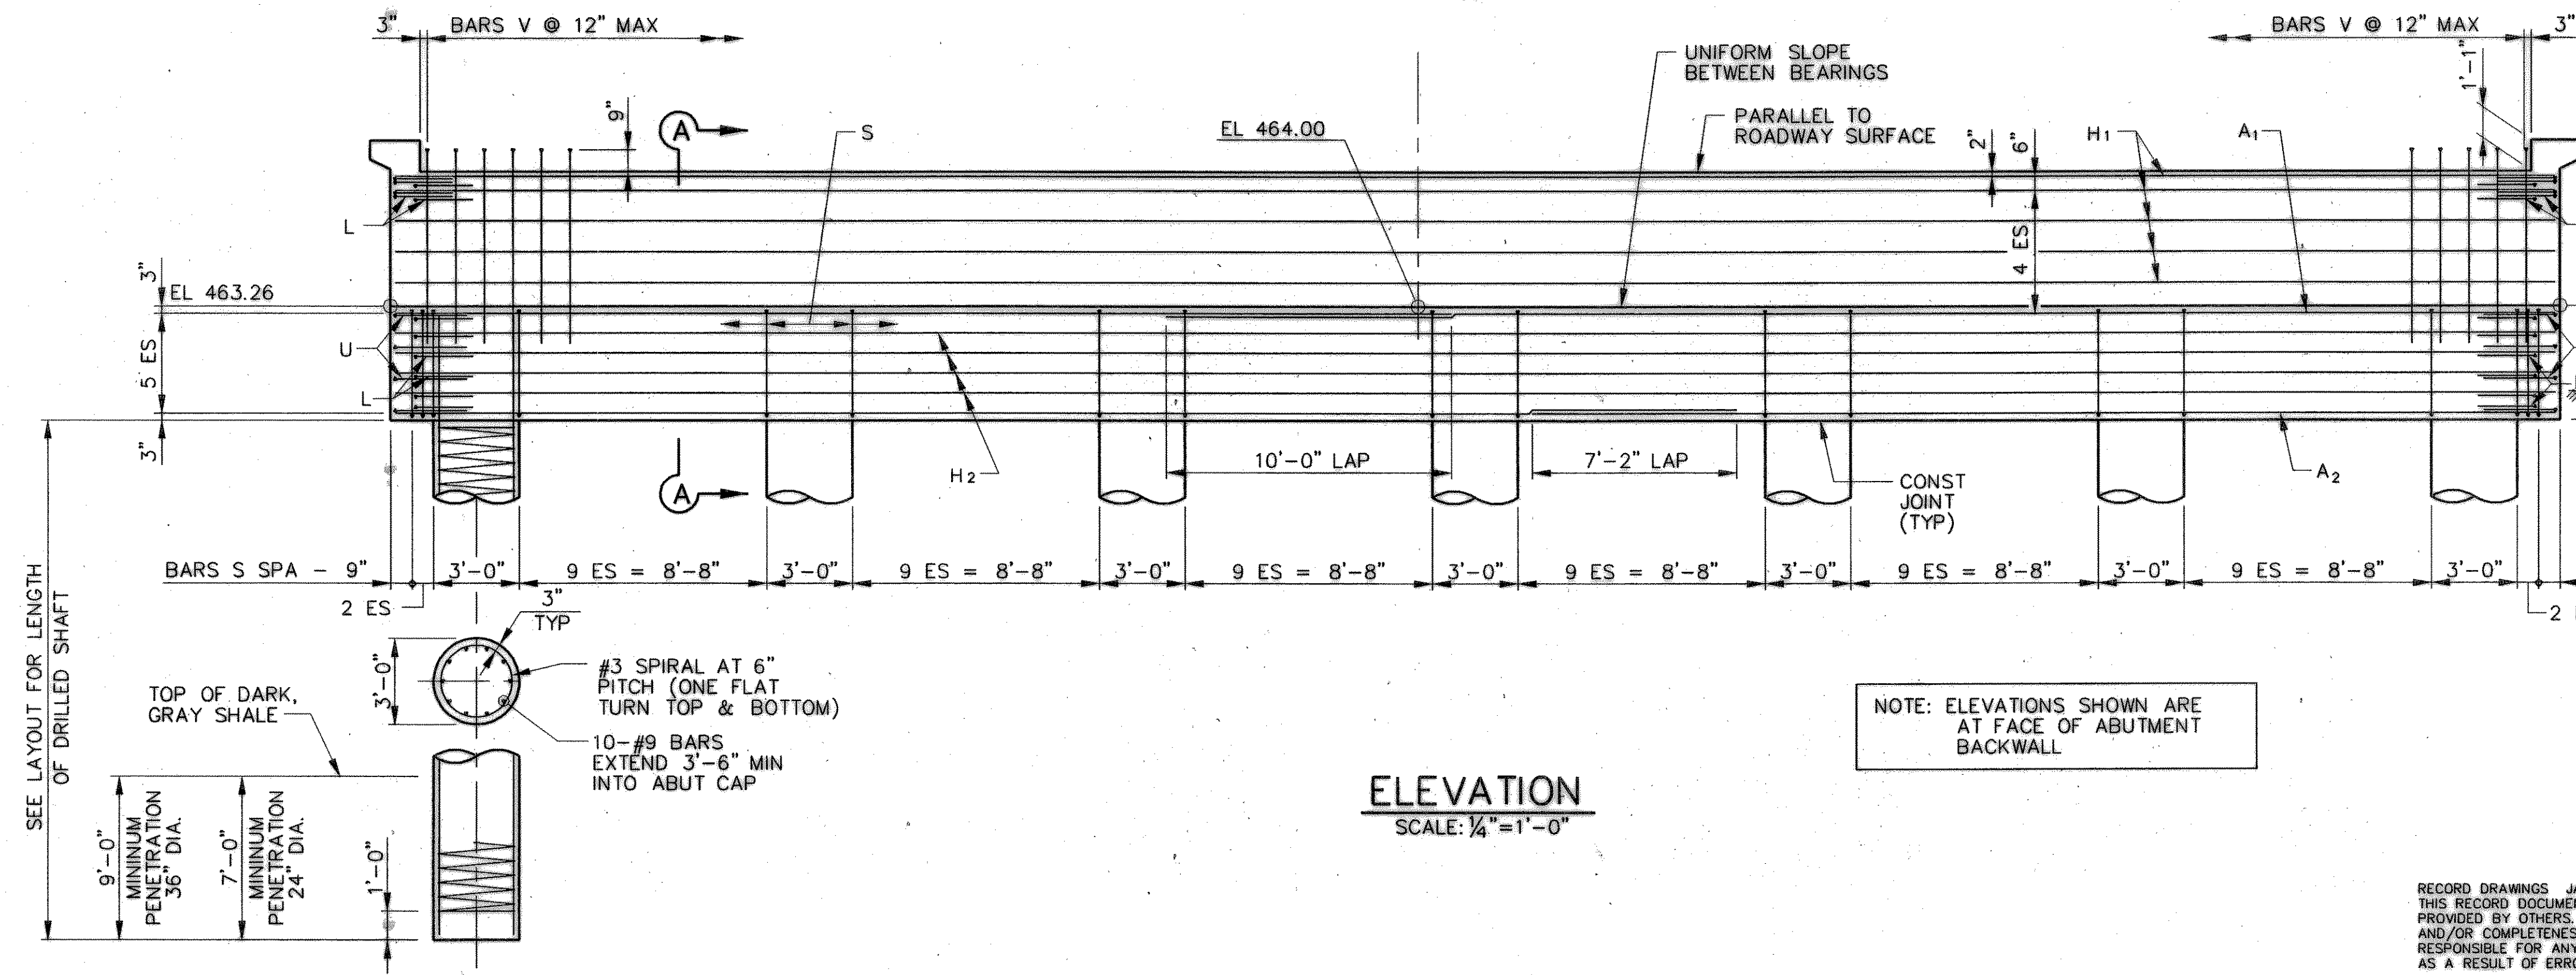

**ELEVATION**  
 SCALE: 1/4" = 1'-0"

NOTE: ELEVATIONS SHOWN ARE AT FACE OF ABUTMENT BACKWALL

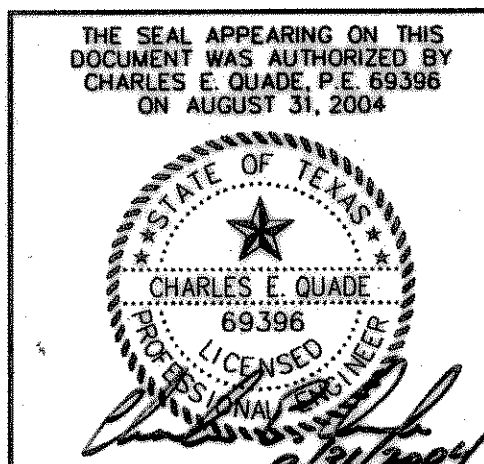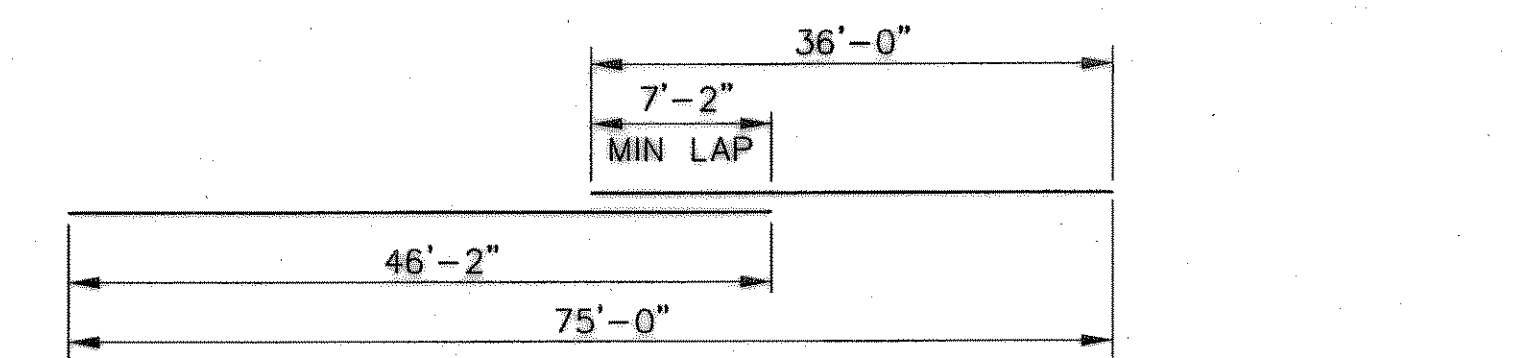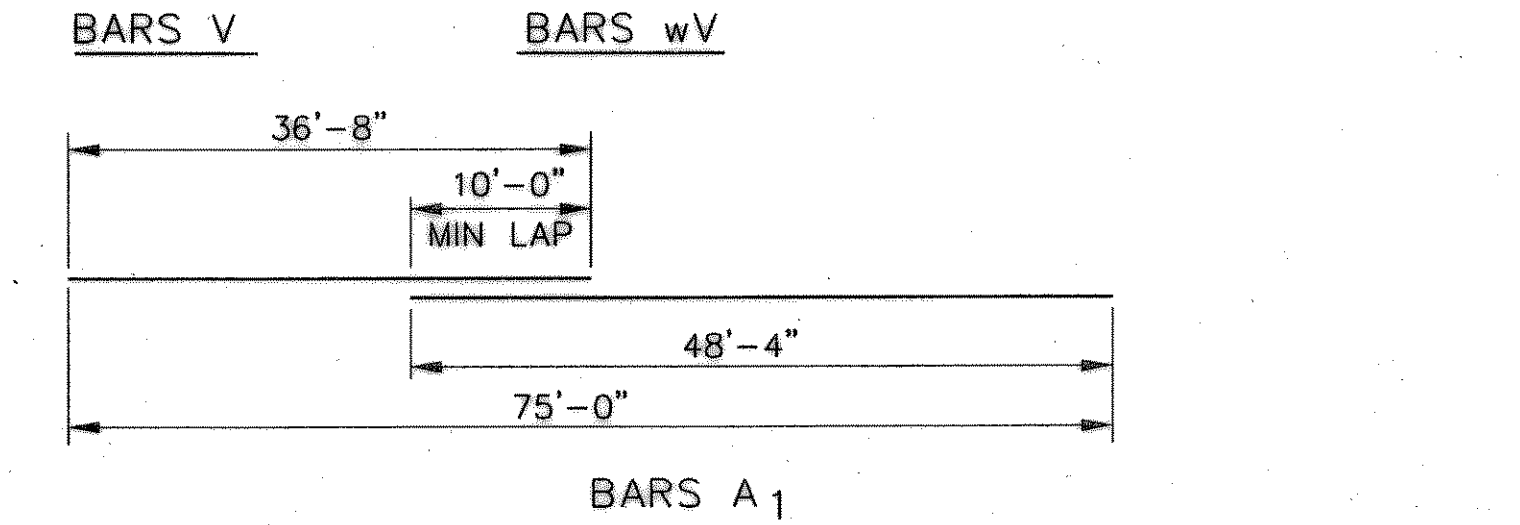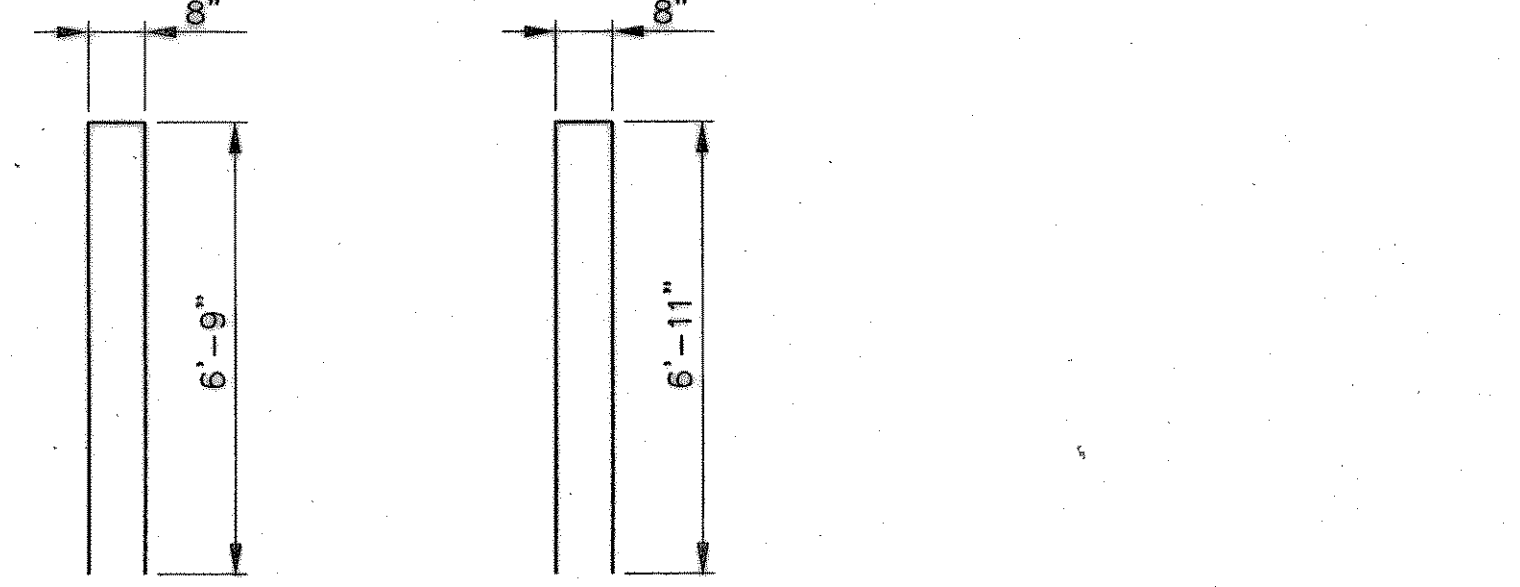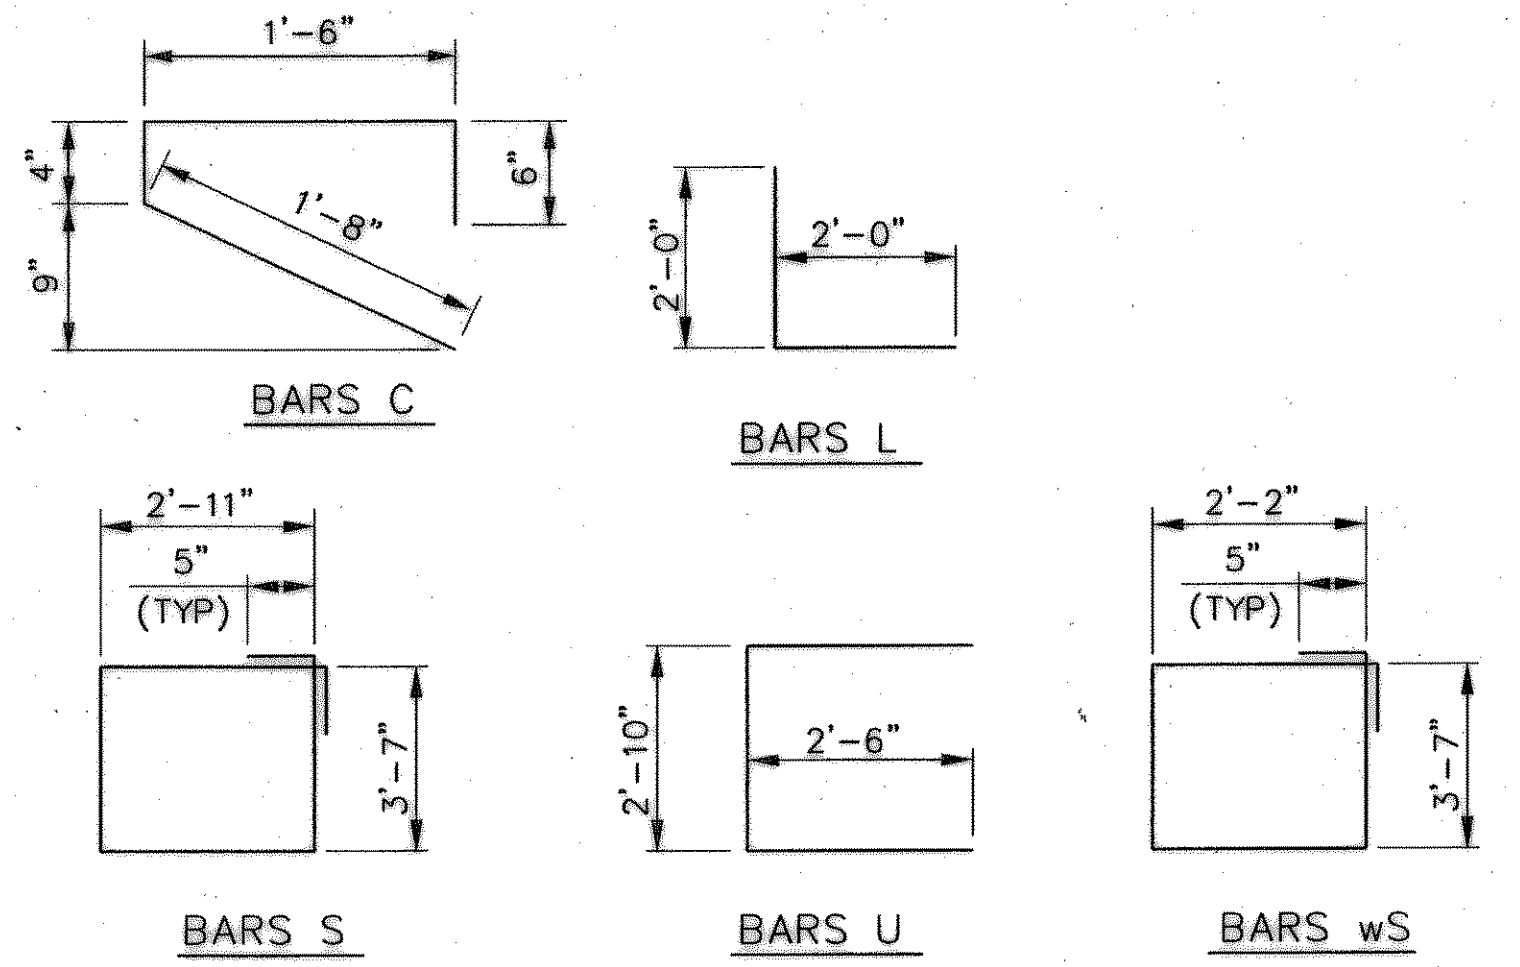

SHEET 1 OF 2

NO.	DATE	REVISIONS	APPROVED

**ABUTMENT NO. 1**  
**NORTH LAKESHORE DRIVE**  
**NAPA DRIVE TO S.H. 205**

**HUNT-ZOLLARS** Hunt-Zollars, Inc. 8311 McGraw Avenue, Suite 600 Dallas, Texas 75204-2489 Phone (214) 871-3311 Fax (214) 871-0757

**CITY OF ROCKWALL, TEXAS**

DESIGN	DRAWN	APPR.	SCALE	DATE	PROJECT NO.	NO.
HZI	HZI	CEQ	AS SHOWN	AUGUST 2004	01-3354-01	B-5

RECORD DRAWINGS JANUARY 12, 2006  
 THIS RECORD DOCUMENT HAS BEEN PREPARED BASED ON INFORMATION PROVIDED BY OTHERS. THE CONSULTANT HAS NOT VERIFIED THE ACCURACY AND/OR COMPLETENESS OF THIS INFORMATION AND SHALL NOT BE RESPONSIBLE FOR ANY ERRORS OR OMISSIONS THAT MAY BE INCORPORATED AS A RESULT OF ERRONEOUS INFORMATION PROVIDED BY OTHERS.