
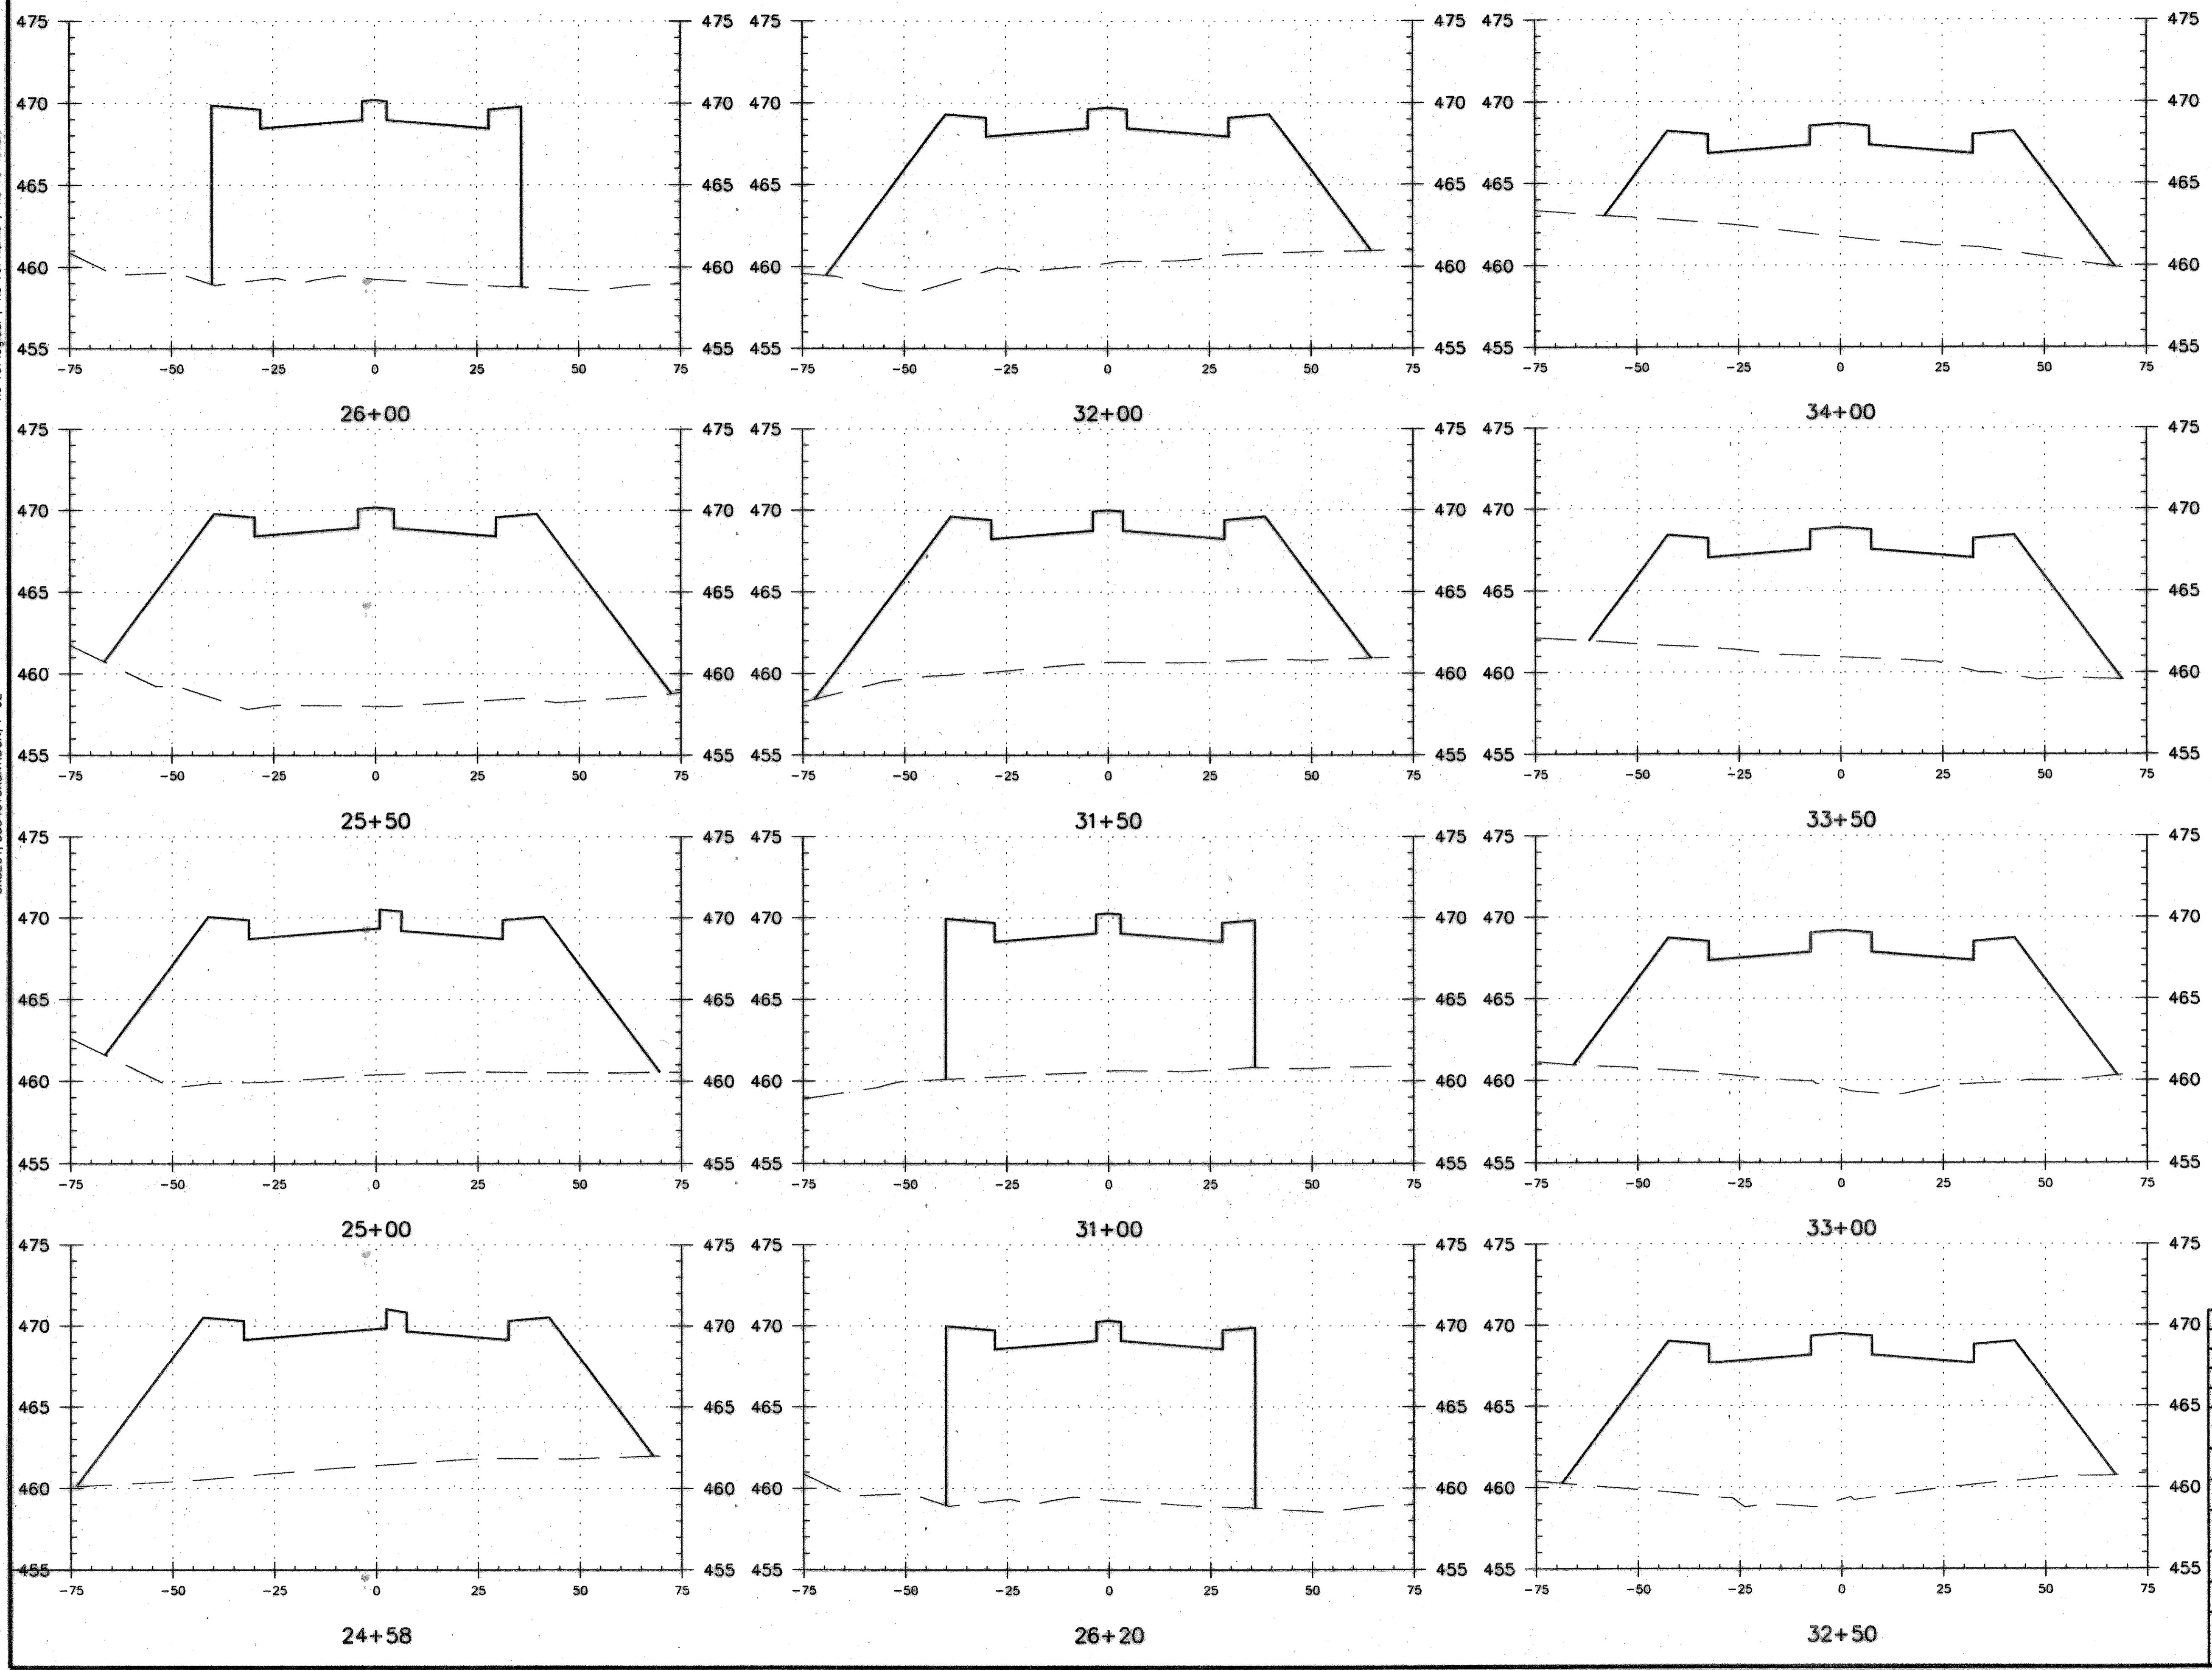


no ref logical *no ref name* *no ref levels*
 no ref logical *no ref name* *no ref levels*

CROW, 335401CROW1.DGN, 1-47, 49-63
 CSTR, 335401CSTR1.DGN, 1-18, 19-29, 31-41, 43-63
 CHALLON, 335401CHALLON1.DGN, 1-63
 CHALLON, 335401CHALLON1.DGN, 1-7, 9-57, 59-63
 BORDER, 335401BORDER1.DGN, 1-4, 6, 7, 20-31, 35-60
 CXCSECT, 335401CXCSECT1.DGN, 1-62

Message:
 SCALE: 1/8"=1'-0"
 PLOT: 1/8"=1'-0"
 FILE: 01335401CXCSECT1.DGN

h:\proj\01335401\dgn\335401CXCSECT1.DGN
 DATE: 1/9/2006
 TIME: 10:15

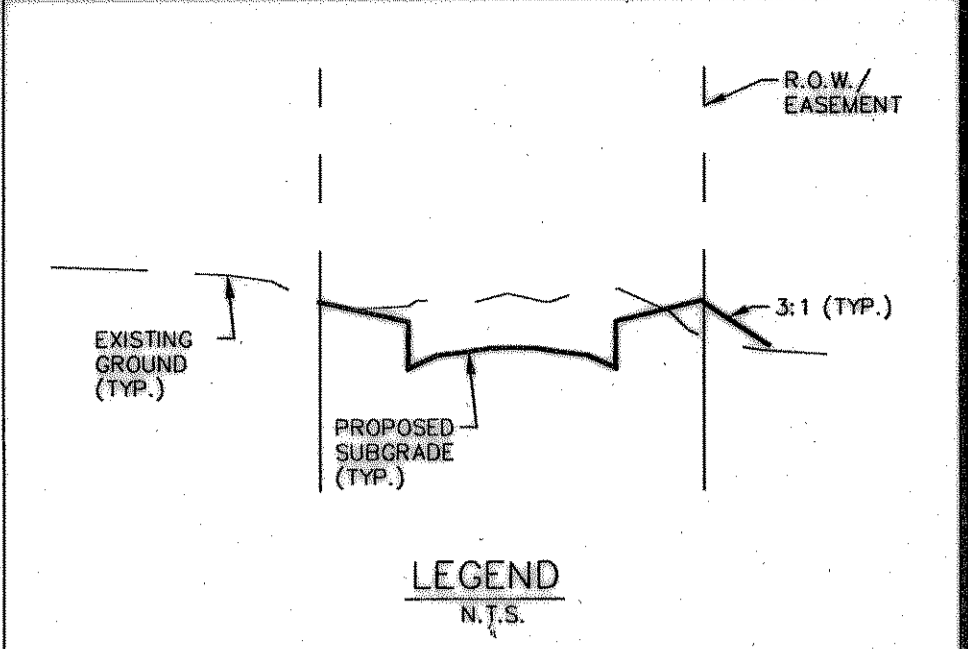

RECORD DRAWINGS JANUARY 12, 2006
 THIS RECORD DOCUMENT HAS BEEN PREPARED BASED ON INFORMATION PROVIDED BY OTHERS. THE CONSULTANT HAS NOT VERIFIED THE ACCURACY AND/OR COMPLETENESS OF THIS INFORMATION AND SHALL NOT BE RESPONSIBLE FOR ANY ERRORS OR OMISSIONS THAT MAY BE INCORPORATED AS A RESULT OF ERRONEOUS INFORMATION PROVIDED BY OTHERS.

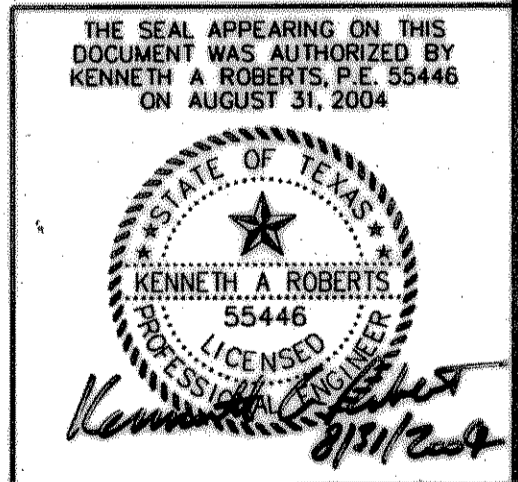

NO.	DATE	REVISIONS	APPROVED			
1	12/20/2004	MEDIAN OPENING REVISION	KAR			
CROSS SECTIONS						
STA. 24+50 TO STA. 34+00						
NORTH LAKESHORE DRIVE						
NAPA DRIVE TO S.H. 205						
HUITT-ZOLIARS		<small>Huitt-Zoliars, Inc. Dallas</small> <small>391 McKinney Avenue, Suite 600</small> <small>Dallas, Texas 75204-2499</small> <small>Phone (214) 871-3311 Fax (214) 871-0757</small>				
CITY OF ROCKWALL, TEXAS						
DESIGN	DRAWN	APPR.	SCALE	DATE	PROJECT NO.	NO.
HZI	HZI	KAR	H: 1"=20' V: 1"=5'	AUGUST 2004	01-3354-01	X-1