
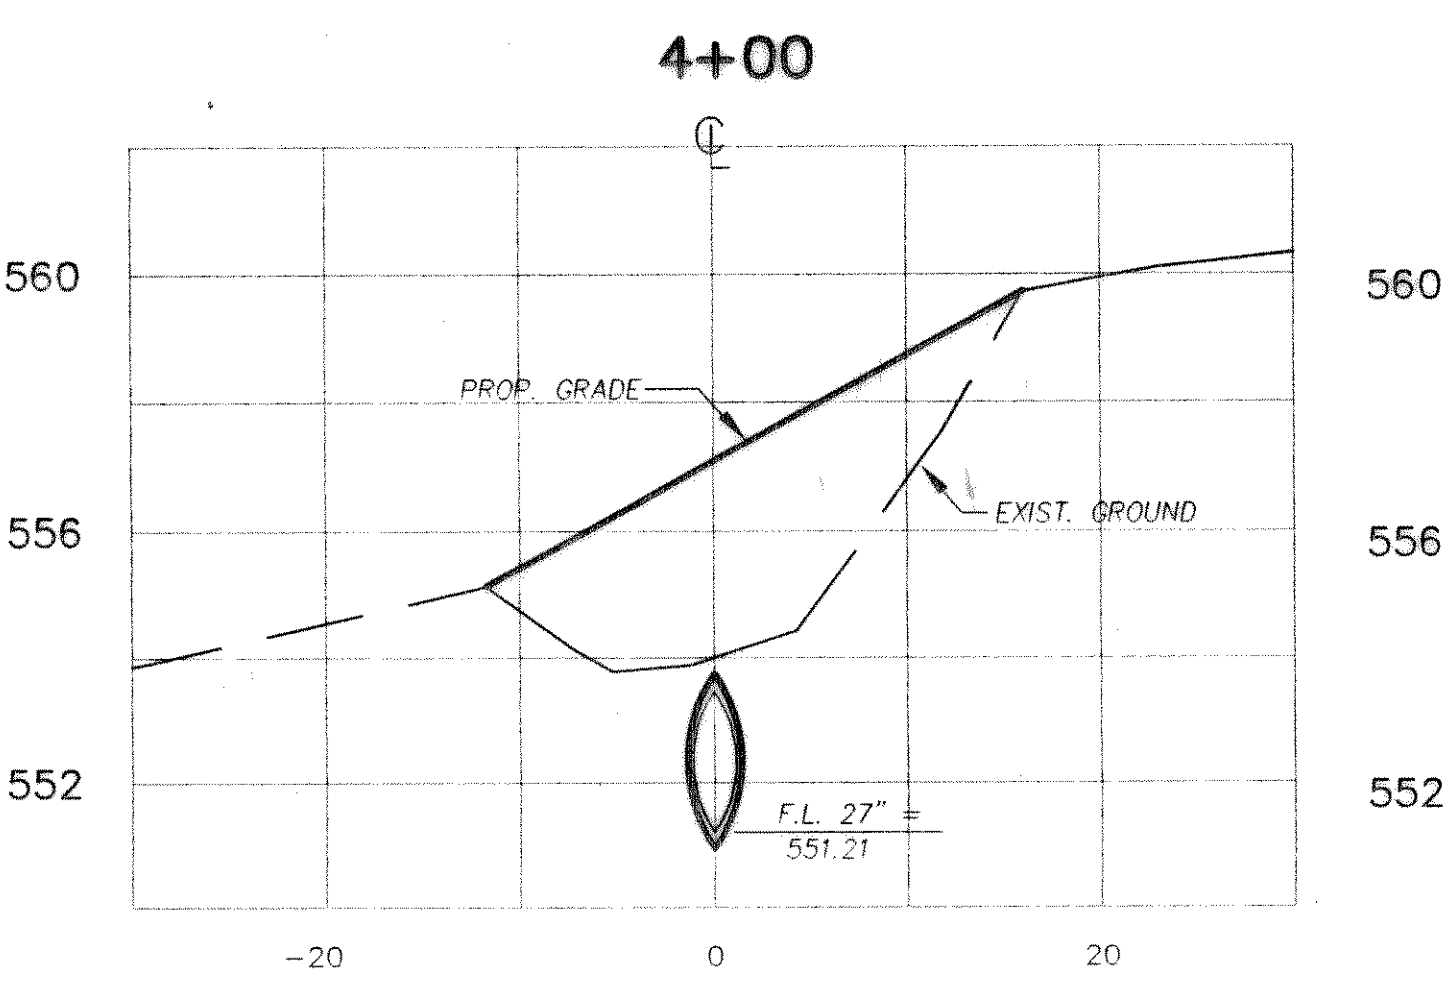
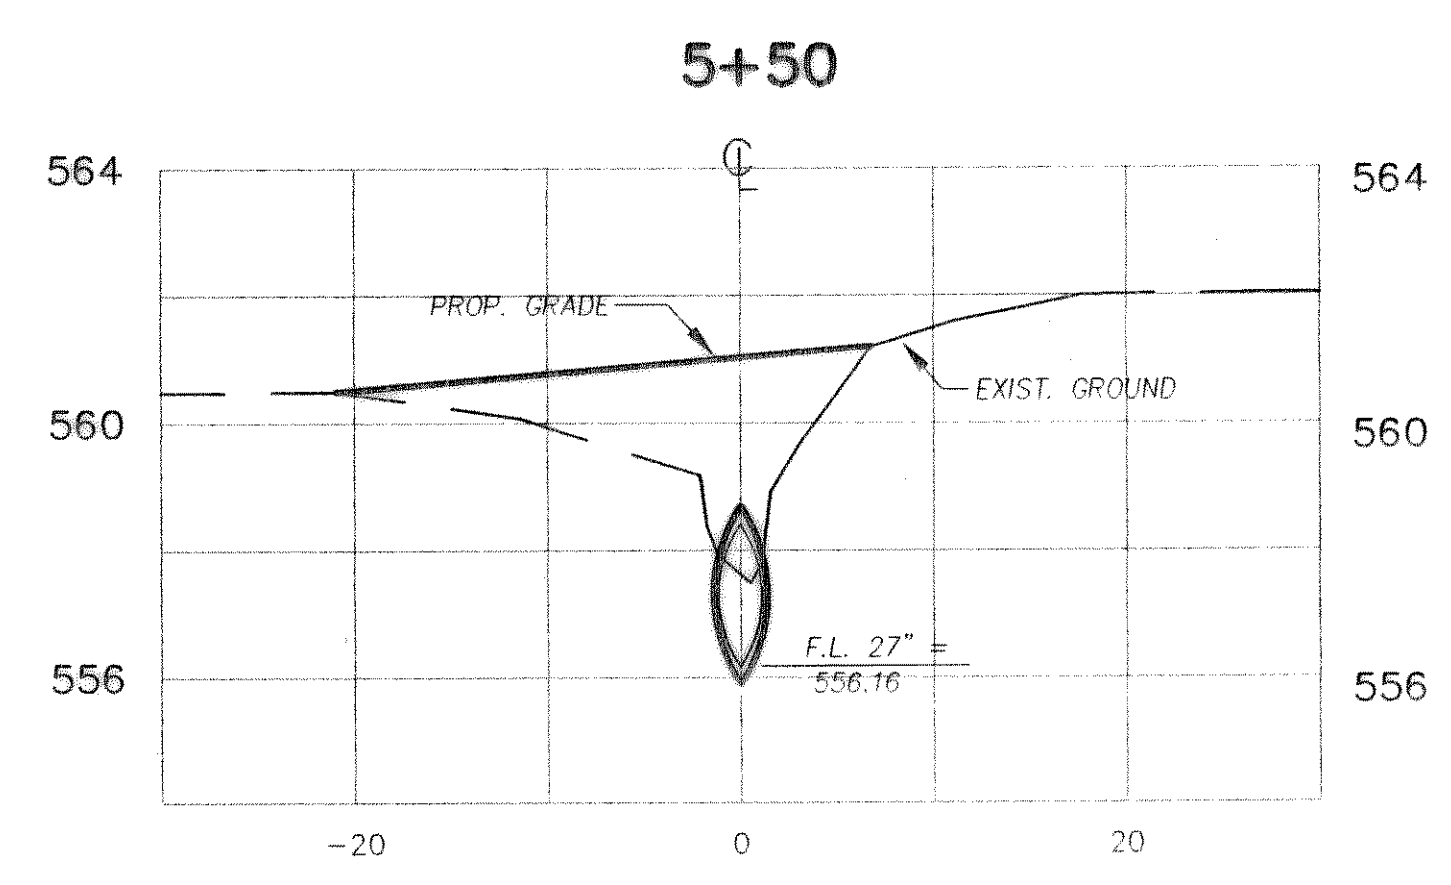
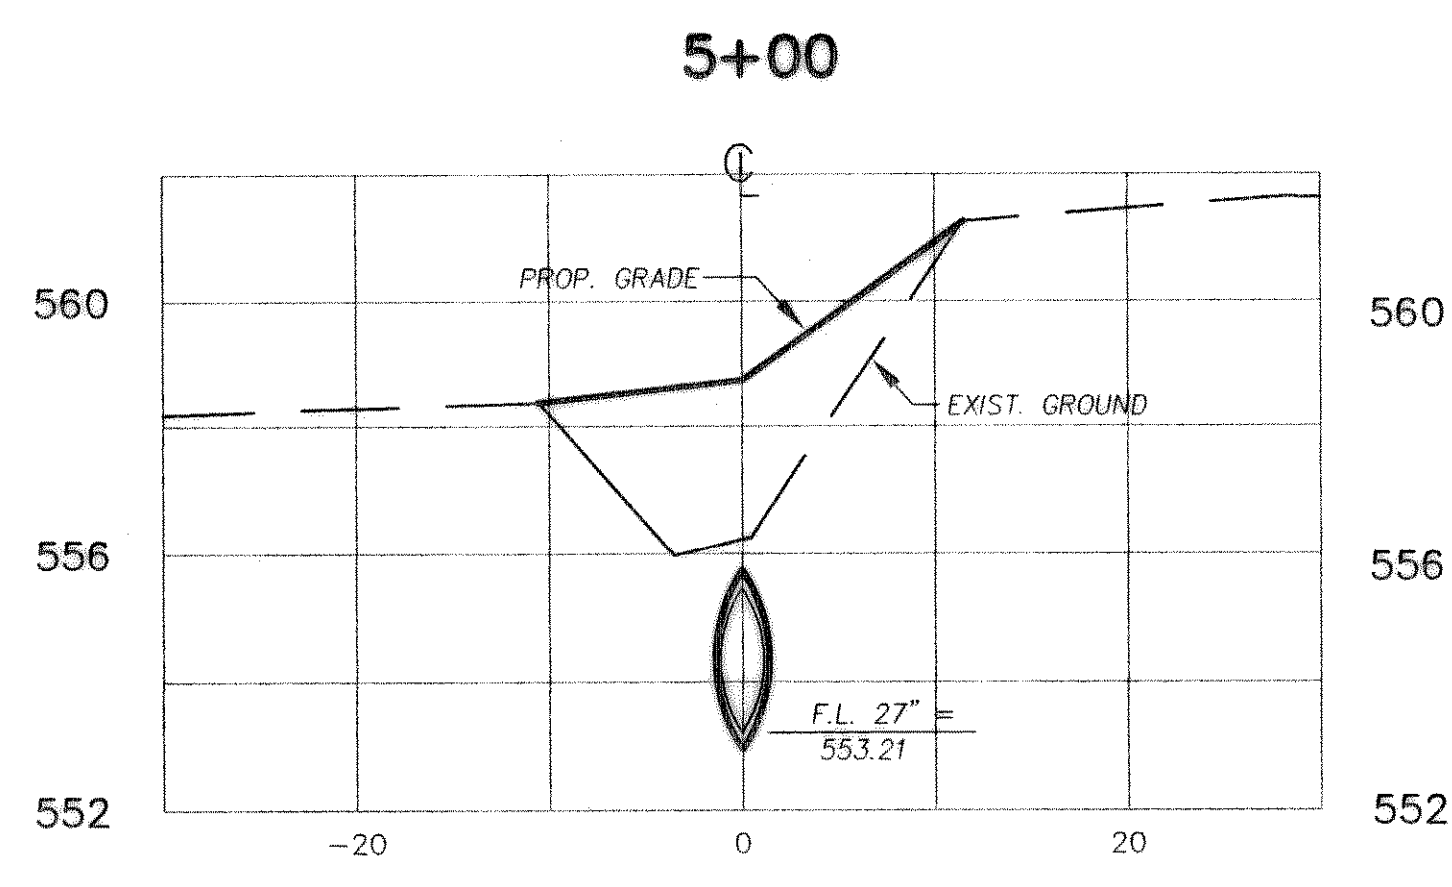
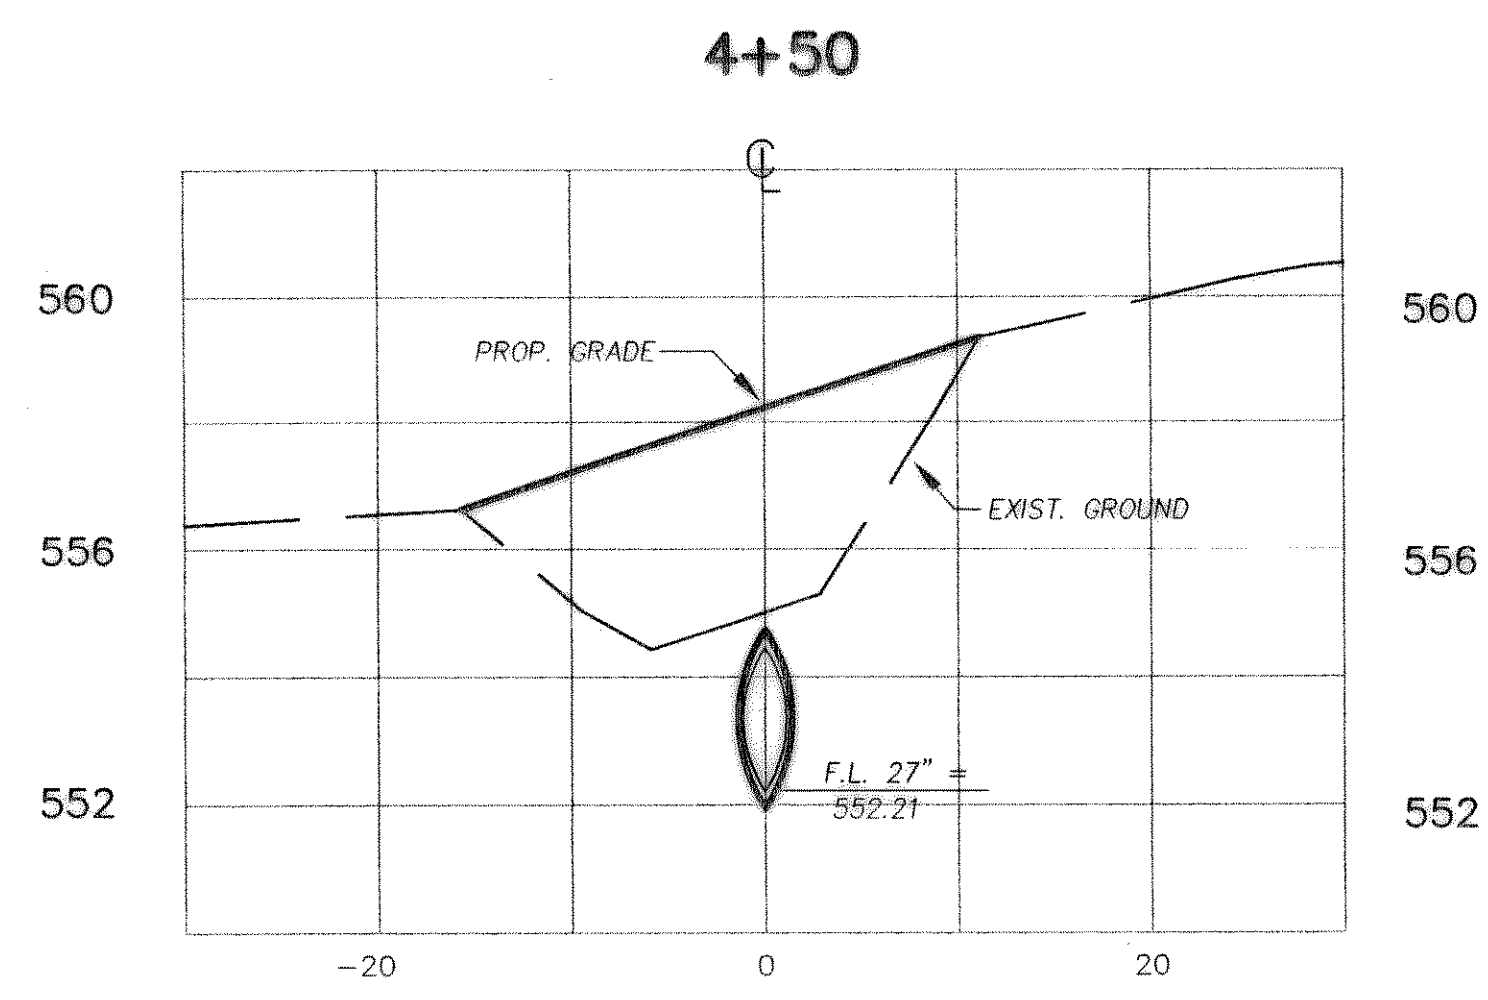
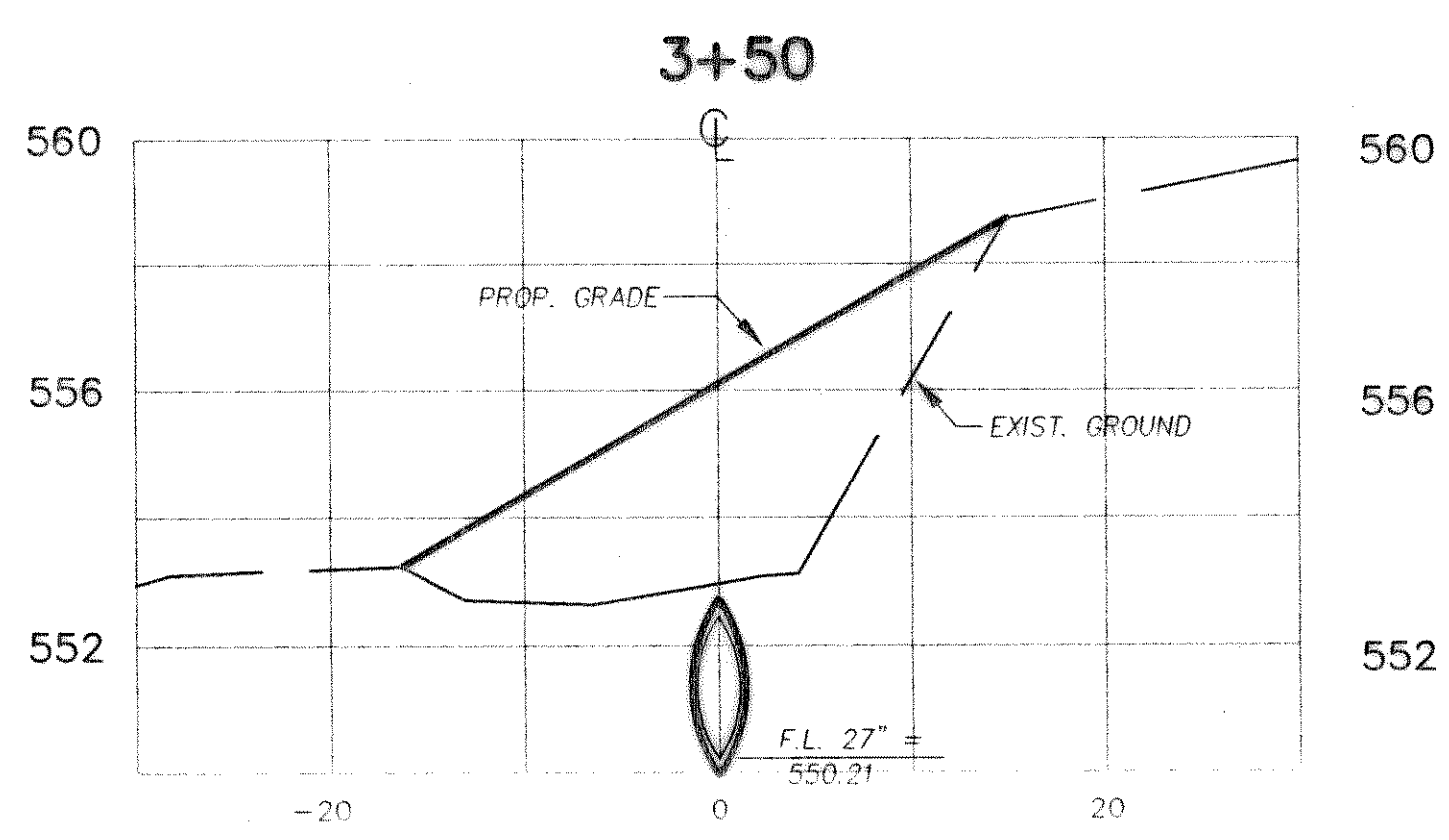


SCALE: 1" = 20' HORIZ.
1" = 5' VERT.

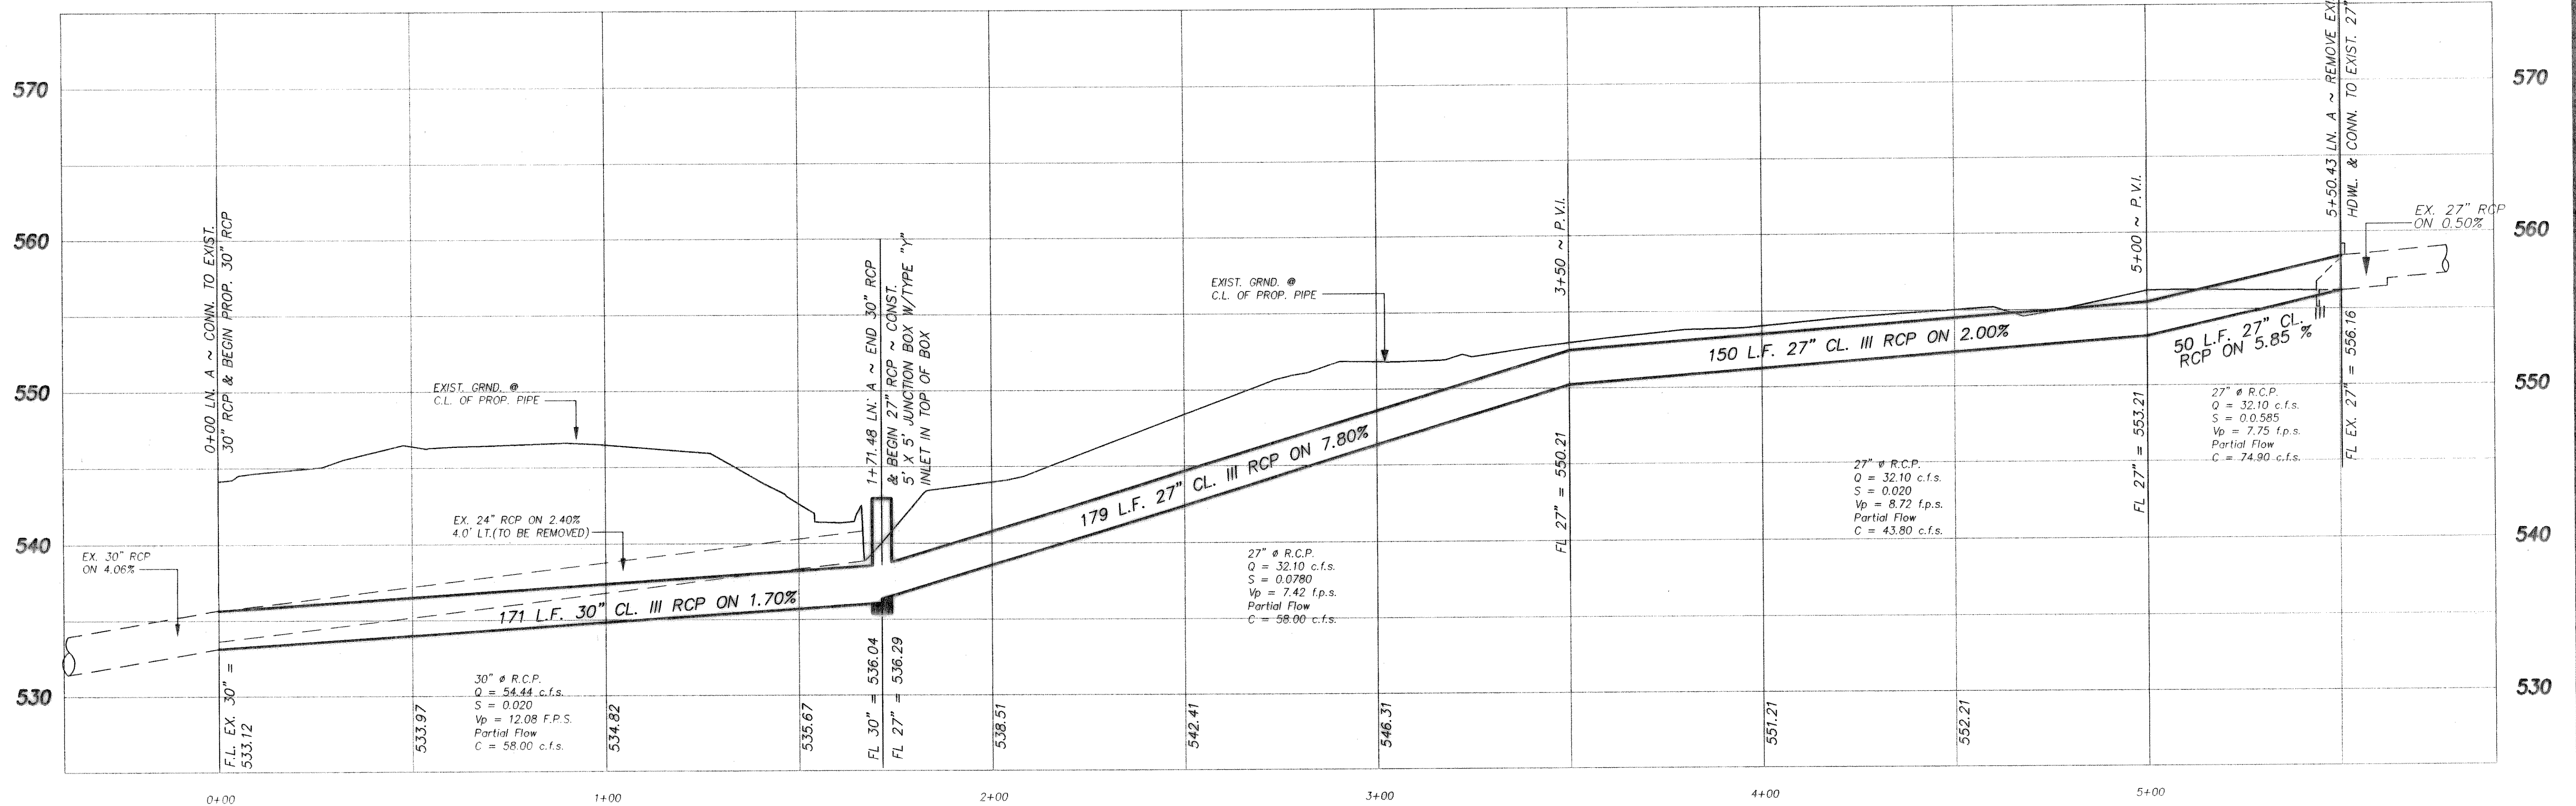

SCALE: 1" = 10' HORIZ.
1" = 3' VERT.

REVISION NO.	REMARKS	DATE

DRAINAGE PROFILE
NORTHSHORE ADDITION PHASE 1
ROCKWALL, TEXAS

CITY OF ROCKWALL
"THE NEW HORIZON"

DESIGNED:	B.W.H.	THE SEAL APPEARING ON THIS DOCUMENT WAS AUTHORIZED BY W.L. DOUPHRADE II TEXAS P.E. NO. 60102 ON 8/2/95
DRAWN:	ACAD	8/2/95
JOB NO.	DATE: 8/21/95	SHEET NO. 3 OF 3

W.L. DOUPHRADE II
60102
REGISTERED PROFESSIONAL ENGINEER