


CITY OF ROCKWALL, TEXAS

CONSTRUCTION PLANS FOR:

NORTHSHORE LIFT STATION IMPROVEMENTS

CONTRACTOR: RAMA ENTERPRISES
 PHONE: 817-303-9681
 FINAL CONTRACT AMOUNT: \$428,190.00

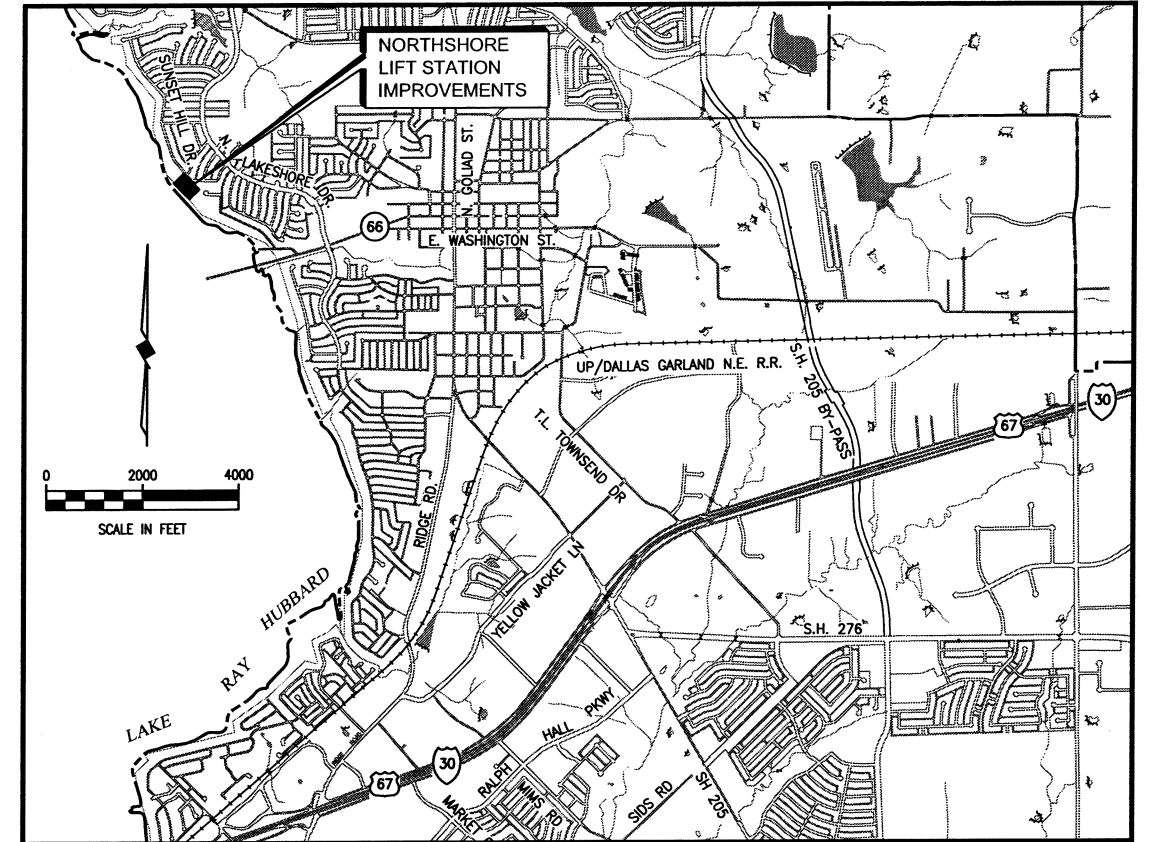

LOCATION MAP

SHEET INDEX

SHEET NO.	SHEET DESCRIPTION
CIVIL	
1	COVER SHEET AND LOCATION MAP
2	GENERAL PROJECT & LIFT STATION NOTES
3	EXISTING LIFT STATION LOCATION
4	EXISTING LIFT STATION SITE PLAN
5A	LIFT STATION PIPE PHOTOS
5	PROPOSED LIFT STATION SITE PLAN
6	PROPOSED PAVEMENT & FENCE PLAN
7	PROPOSED PIPING PROFILES
8	EXISTING LIFT STATION SECTIONS
9	PROPOSED LIFT STATION SECTIONS
10	PROPOSED GRADING PLAN
11	PROPOSED RETAINING WALL PROFILE & SECTIONS
12 - 15	MISCELLANEOUS DETAILS
ELECTRICAL	
16	ELECTRICAL SITE PLAN
17	ELECTRICAL OVERALL ONE LINE DIAGRAM
18	ELECTRICAL SCHEDULES
19	ELECTRICAL PUMP CONTROL SCHEMATICS
20	ELECTRICAL SCADA RTU I/O TABLE
21	ELECTRICAL CONTROL BLOCK DIAGRAM
22 - 24	ELECTRICAL DETAILS
25	ELECTRICAL WET WELL CONTROLS
STRUCTURAL	
26	GENERAL NOTES & TYPICAL DETAILS
27	PLAN, SECTIONS & DETAILS

COUNCIL MEMBERS


DAVID SWEET, MAYOR
 DAVID WHITE, MAYOR PRO-TEM
 JIM PRUITT
 BENNIE DANIELS
 DENNIS LEWIS
 SCOTT MILDER
 MIKE TOWNSEND

CITY MANAGER

RICK CROWLEY

ASSISTANT CITY MANAGER

MARY SMITH
 BRAD GRIGGS

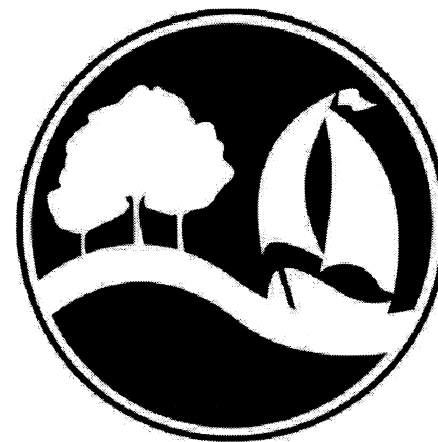

Matthew Hickey
 1/2/14

BIRKHOFF, HENDRICKS & CARTER, L.L.P.
 PROFESSIONAL ENGINEERS

Texas Firm 526
 Dallas, Texas

JANUARY 2014

This record drawing is a compilation of the sealed engineering drawing for this project; modified by addenda, change orders and information furnished by the contractor. The information shown on the record drawings that was provided by the contractor or others not associated with the design engineer cannot be verified for accuracy or completeness. This original sealed drawings are on file at the offices of Birkhoff, Hendricks & Carter, L.L.P.

BY MH DATE 06/08/15

These plans and related specifications were prepared for construction of this specific project only. Reuse of these documents is not permitted without written authorization of Birkhoff, Hendricks & Carter, L.L.P. If this drawing is converted to an electronic file, any discrepancy occurs between the electronic file and the Birkhoff, Hendricks & Carter, L.L.P. original document, the original document will govern in all cases.