


**NORTHSHORE  
LIFT STATION SITE**

**FURNISH AND  
INSTALL 4\"/>**

*This record drawing is a compilation of the sealed engineering drawing for this project; modified by addenda, change orders and information furnished by the contractor. The information shown on the record drawings that was provided by the contractor or others not associated with the design engineer cannot be verified for accuracy or completeness. This original sealed drawings are on file at the offices of Birkhoff, Hendricks & Carter, L.L.P.*  
 BY MH DATE 06/08/15

These plans and related specifications were prepared for construction of this specific project only. Reuse of these documents is not permitted without written authorization of Birkhoff, Hendricks & Carter, L.L.P. If this drawing is converted to an electronic file, if any discrepancy occurs between the electronic file and the Birkhoff, Hendricks & Carter, L.L.P. original document, the original document will govern in all cases.

**BIRKHOFF, HENDRICKS & CARTER, L.L.P.**  
 PROFESSIONAL ENGINEERS  
 Texas Firm F526  
 11910 Greenville Ave., Suite 600  
 Dallas, Texas 75243 (214) 361-7900

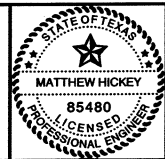

*Matthew Hickey*  
 1/2/14

**CITY OF ROCKWALL, TEXAS**  
 NORTHSHORE LIFT STATION  
 EXISTING LIFT STATION LOCATION

BHC  
 PROJECT NO.  
 2013-119  
 January 2014

SHEET NO.  
**3**