


- NOTES:
- 8" FLEXIBLE BASE MATERIAL SHALL BE NCTCOG ITEM 301.5, GRADE 1 ON TOP OF GEOTEXTILE FABRIC (MIRAFI 180NC OR EQUAL) COMPACTED TO 95% STD. PROCTOR.
 - ALL CONCRETE PAVEMENT SHALL BE NCTCOG CLASS P1 (4,000 PSI), MIN. 6.5 SACK.
 - ALL FILL SHALL BE COMPACTED IN 8" LOOSE LIFTS TO 95% STANDARD PROCTOR WITH SHEEPS FOOT ROLLER.
 - CONTRACTOR SHALL VERIFY LOCATION OF ANY EXISTING UTILITIES PRIOR TO PLACEMENT OF FENCE POSTS.
 - IRREGULAR DISTANCES BETWEEN PROPOSED FENCE CORNERS EXIST. CONTRACTOR SHALL PROVIDE SHOP DRAWING OF FENCE POST AND PANEL LAYOUT PRIOR TO CONSTRUCTION. FENCE POST LAYOUT ON THE RETAINING WALL SHALL BE COORDINATED BY THE CONTRACTOR (NO SEPARATE PAY ITEM).

FENCE COORDINATES		
POINT NO.	NORTHING	EASTING
1	7028287.1419	2588695.7595
2	7028280.6624	2588709.2878
3	7028282.8751	2588724.1237
4	7028278.2216	2588737.3277
5	7028261.8391	2588734.5851
6	7028259.0493	2588723.7859
7	7028259.0714	2588692.7832
8	7028267.3646	2588692.7832

PAVING COORDINATES & ELEVATIONS			
POINT NO.	NORTHING	EASTING	ELEVATION
1	7028294.0669	2588741.3182	450.12
2	7028293.6237	2588758.3418	451.35
3	7028276.4962	2588757.3248	450.93
4	7028263.3889	2588756.7517	450.87
5	7028263.3412	2588752.0236	450.78
6	7028263.7151	2588747.0338	TC 450.39 GUT 449.89
7	7028264.0888	2588742.0478	TC 449.50 GUT 449.00
8	7028264.7153	2588736.0806	TC 449.50 GUT 449.00
9	7028265.7114	2588736.2473	449.02
10	7028260.3885	2588715.6421	448.25
11	7028270.3885	2588715.6421	448.50
12	7028277.5366	2588738.2269	449.33
13	7028278.7041	2588738.4224	449.60
14	7028278.8546	2588739.1550	449.39

!! WARNING !!
 THERE ARE EXISTING AND/OR PROPOSED UTILITIES IN PROJECT AREA. UTILITY INFORMATION SHOWN ON PLANS REPRESENTS APPROXIMATE LOCATIONS OF EXISTING UTILITIES AND IS NOT NECESSARILY ALL-INCLUSIVE. CONTRACTOR SHALL BE RESPONSIBLE FOR VERIFYING EXACT LOCATIONS OF EXISTING UTILITIES AND SHALL BE REQUIRED TO PROTECT UTILITIES TO AVOID DAMAGE.
 PRIOR TO ANY EXCAVATION, CONTRACTOR SHALL CONTACT DIG-TESS, TEXAS ONE CALL, LONE STAR NOTIFICATION AND OTHERS AS REQUIRED TO LOCATE EXISTING UTILITIES.
 CONTRACTOR SHALL ALSO CONTACT APPROPRIATE CITY UTILITY DEPARTMENT FOR FIELD LOCATES OF MUNICIPAL INFRASTRUCTURE 48 HOURS PRIOR TO CONSTRUCTION.

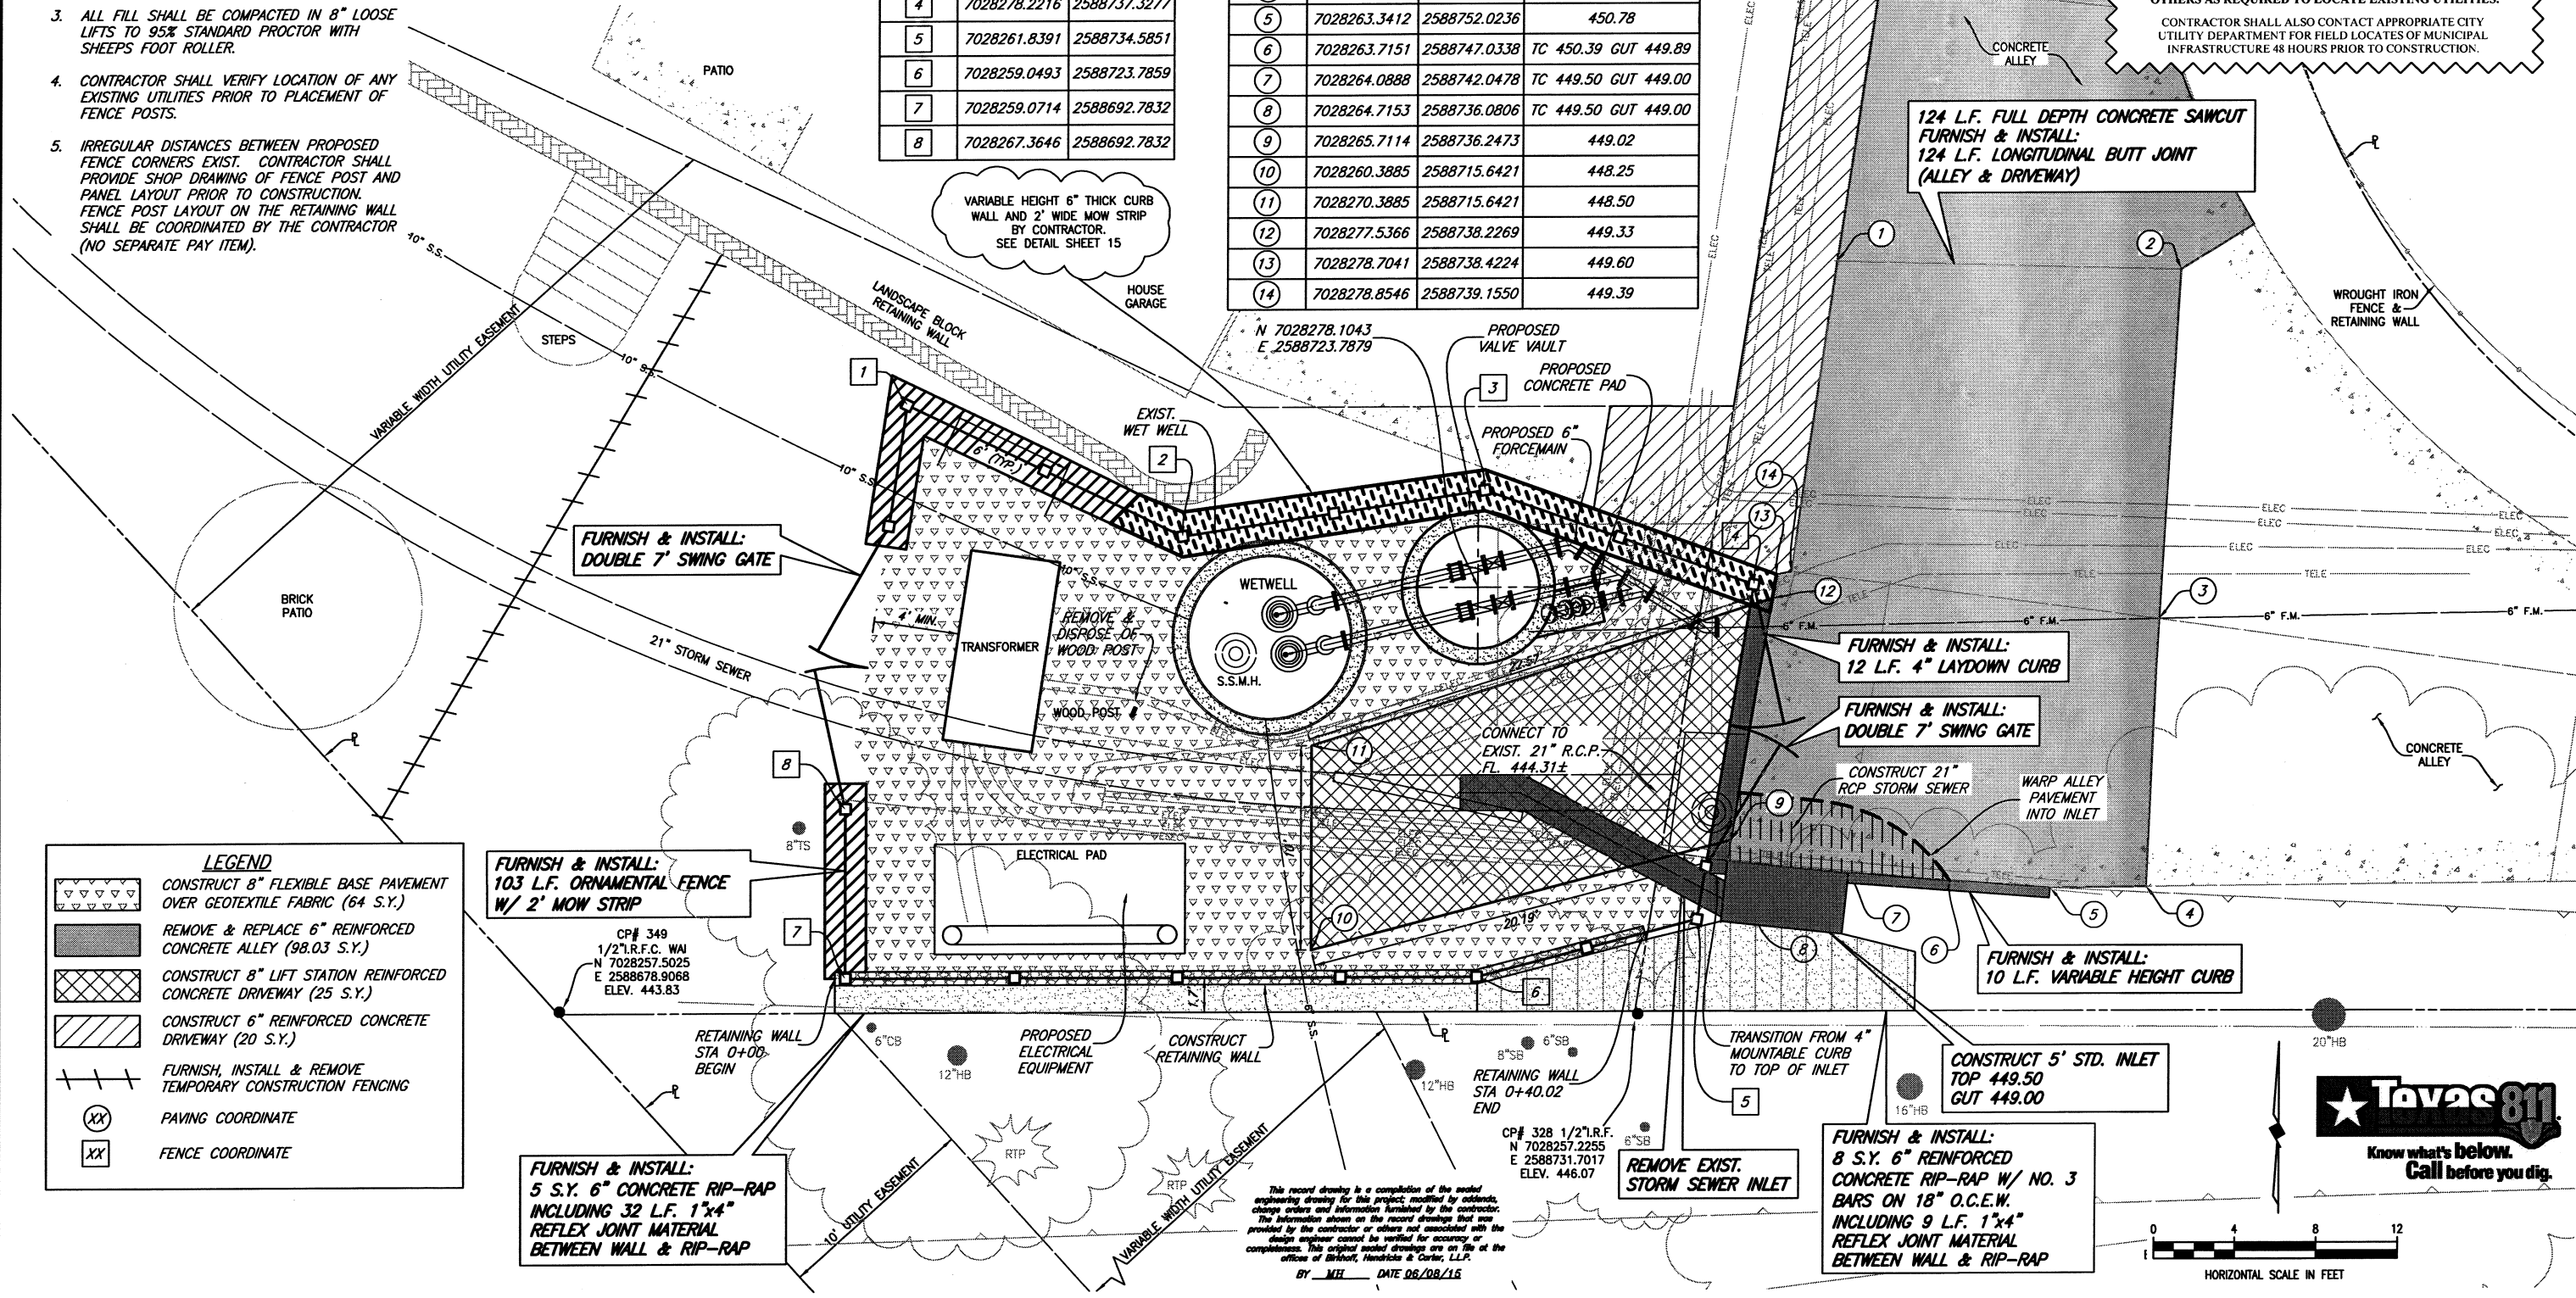



LEGEND

- CONSTRUCT 8" FLEXIBLE BASE PAVEMENT OVER GEOTEXTILE FABRIC (64 S.Y.)
- REMOVE & REPLACE 6" REINFORCED CONCRETE ALLEY (98.03 S.Y.)
- CONSTRUCT 8" LIFT STATION REINFORCED CONCRETE DRIVEWAY (25 S.Y.)
- CONSTRUCT 6" REINFORCED CONCRETE DRIVEWAY (20 S.Y.)
- FURNISH, INSTALL & REMOVE TEMPORARY CONSTRUCTION FENCING
- PAVING COORDINATE
- FENCE COORDINATE

FURNISH & INSTALL:
 103 L.F. ORNAMENTAL FENCE
 W/ 2' MOW STRIP

CP# 349
 1/2" R.F.C. WAI
 N 7028257.5025
 E 2588678.9068
 ELEV. 443.83

FURNISH & INSTALL:
 8 S.Y. 6" REINFORCED
 CONCRETE RIP-RAP W/ NO. 3
 BARS ON 18" O.C.E.W.
 INCLUDING 9 L.F. 1"x4"
 REFLEX JOINT MATERIAL
 BETWEEN WALL & RIP-RAP

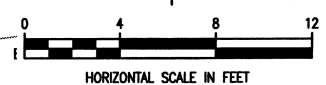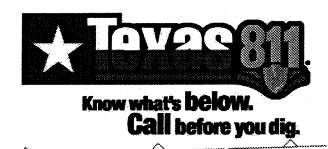

This record drawing is a compilation of the sealed engineering drawings for this project, modified by addenda, change orders and information furnished by the contractor. The information shown on the record drawings that was provided by the contractor or others not associated with the design engineer cannot be verified for accuracy or completeness. This original sealed drawings are on file at the office of Birkhoff, Hendricks & Carter, L.L.P.
 BY: ME DATE 06/08/15

These plans and related specifications were prepared for construction of this specific project only. Reuse of these documents is not permitted without written authorization of Birkhoff, Hendricks & Carter, L.L.P. If this drawing is converted to an electronic file, if any discrepancy occurs between the electronic file and the Birkhoff, Hendricks & Carter, L.L.P. original document, the original document will govern in all cases.	BIRKHOFF, HENDRICKS & CARTER, L.L.P. PROFESSIONAL ENGINEERS Texas Firm F526 11910 Greenville Ave., Suite 600 Dallas, Texas 75243 (214) 361-7900		Matthew Hickey 1/2/14	CITY OF ROCKWALL, TEXAS NORTHSHORE LIFT STATION PROPOSED PAVEMENT & FENCE PLAN	BHC PROJECT NO. 2013-119 January 2014	SHEET NO. 6
				REVISED: 6/9/15 - KBIRKHOFF	H:\Projects\Rockwall\2013119\Sheets\2013119 06 Prop Pave Fen Plan.dwg	PLOT SCALE: 1:2