

WARNING!!!
 CONTRACTOR SHALL FIELD VERIFY THE
 HORIZONTAL & VERTICAL LOCATION OF ALL
 UNDERGROUND UTILITIES PRIOR TO EXCAVATION.

*This record drawing is a compilation of the sealed
 engineering drawing for this project; modified by addenda,
 change orders and information furnished by the contractor.
 The information shown on the record drawings that was
 provided by the contractor or others not associated with the
 design engineer cannot be verified for accuracy or
 completeness. This original sealed drawings are on file at the
 offices of Birkhoff, Hendricks & Carter, L.L.P.*


BY MH DATE 06/08/15

HYDRAULIC INFORMATION BASED ON
 NORTHSORE PHASE 2-A DRAINAGE AREA MAP
 BY HAROLD L. EVANS CONSULTING ENGINEER
 DATED 11-29-83.
 DRAINAGE AREA NO. 11
 AREA = 1.47 AC.
 TIME OF CONCENTRATION = 10 MIN.
 "C" = 0.50
 INTENSITY 5 YR = 6.8 IN/HR
 $Q_{5 YR} = 5 \text{ c.f.s.}$

FIELD CHANGE: REVISED 6" F.M. FLOWLINE TO MATCH VALVE VAULT - 12/17/14

These plans and related specifications were prepared for construction of this specific project only. Reuse of these documents is not permitted without written authorization of Birkhoff, Hendricks & Carter, L.L.P. If this drawing is converted to an electronic file, if any discrepancy occurs between the electronic file and the Birkhoff, Hendricks & Carter, L.L.P. original document, the original document will govern in all cases.

BIRKHOFF, HENDRICKS & CARTER, L.L.P.
 PROFESSIONAL ENGINEERS
 Texas Firm F526
 11910 Greenville Ave., Suite 600
 Dallas, Texas 75243 (214) 361-7900

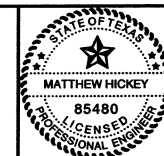

Matthew Hickey
 1/2/14

CITY OF ROCKWALL, TEXAS
 NORTHSORE LIFT STATION
 PROPOSED PIPING PROFILES

BHC
 PROJECT NO.
 2013-119
 January 2014

SHEET NO.
7