


ELECTRICAL SITE & PLAN SYMBOL LEGEND	
SYMBOL	DESCRIPTION
—	EXPOSED CONDUIT RUN
- - -	CONCEALED OR UNDERGROUND CONDUIT RUN
→	CIRCUIT HOME RUN TO PANELBOARD
⊙	GROUND ROD & WELL SEE DETAIL 01, SHEET 12.
⋯	COPPER GROUND #2/0 WIRE GROUND RING
⊥	EXOTHERMIC GROUND CONNECTION
⊙	POLE MOUNTED FIXTURE - LETTER DENOTES FIXTURE TYPE
⋯	GROUND WIRE #2 (EGC)
XXXX	CONDUIT AND CABLE TAG NUMBER. REF ONLINE DIAGRAM/CONDUIT SCHEDULE
XX EX	EXAMPLE: DETAIL REFERENCE XX= DETAIL NO. EX= ELECTRICAL SHEET
⊙	ANTENNA

This record drawing is a compilation of the sealed engineering drawing for this project; modified by addenda, change orders and information furnished by the contractor. The information shown on the record drawings that was provided by the contractor or others not associated with the design engineer cannot be verified for accuracy or completeness. This original sealed drawings are on file at the offices of Birkhoff, Hendricks & Carter, L.L.P.


BY MH DATE 06/08/15

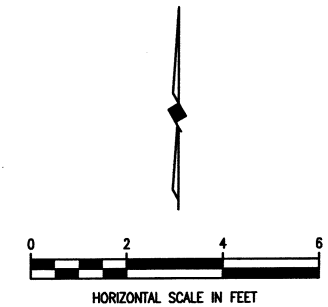

ELECTRICAL SITE PLAN

These plans and related specifications were prepared for construction of this specific project only. Reuse of these documents is not permitted without written authorization of Birkhoff, Hendricks & Carter, L.L.P. If this drawing is converted to an electronic file, if any discrepancy occurs between the electronic file and the Birkhoff, Hendricks & Carter, L.L.P. original document, the original document will govern in all cases.

BIRKHOFF, HENDRICKS & CARTER, L.L.P.
 PROFESSIONAL ENGINEERS
 Texas Firm F526
 11910 Greenville Ave., Suite 600
 Dallas, Texas 75243 (214) 361-7900

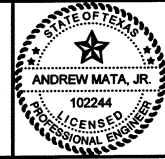

Andrew Mata, Jr.
1/2/14

CITY OF ROCKWALL, TEXAS
 NORTHSORE LIFT STATION
 ELECTRICAL SITE PLAN

BHC PROJECT NO. 2013-119	SHEET NO. 16
January 2014	