
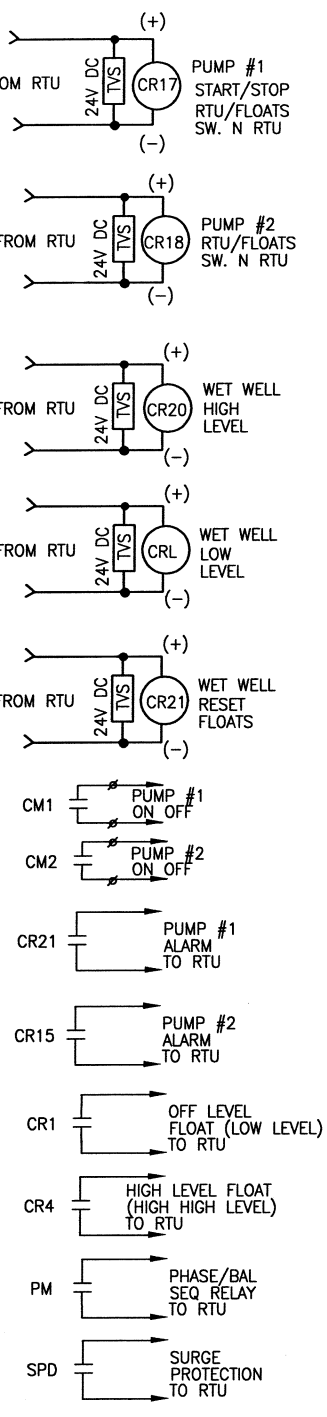
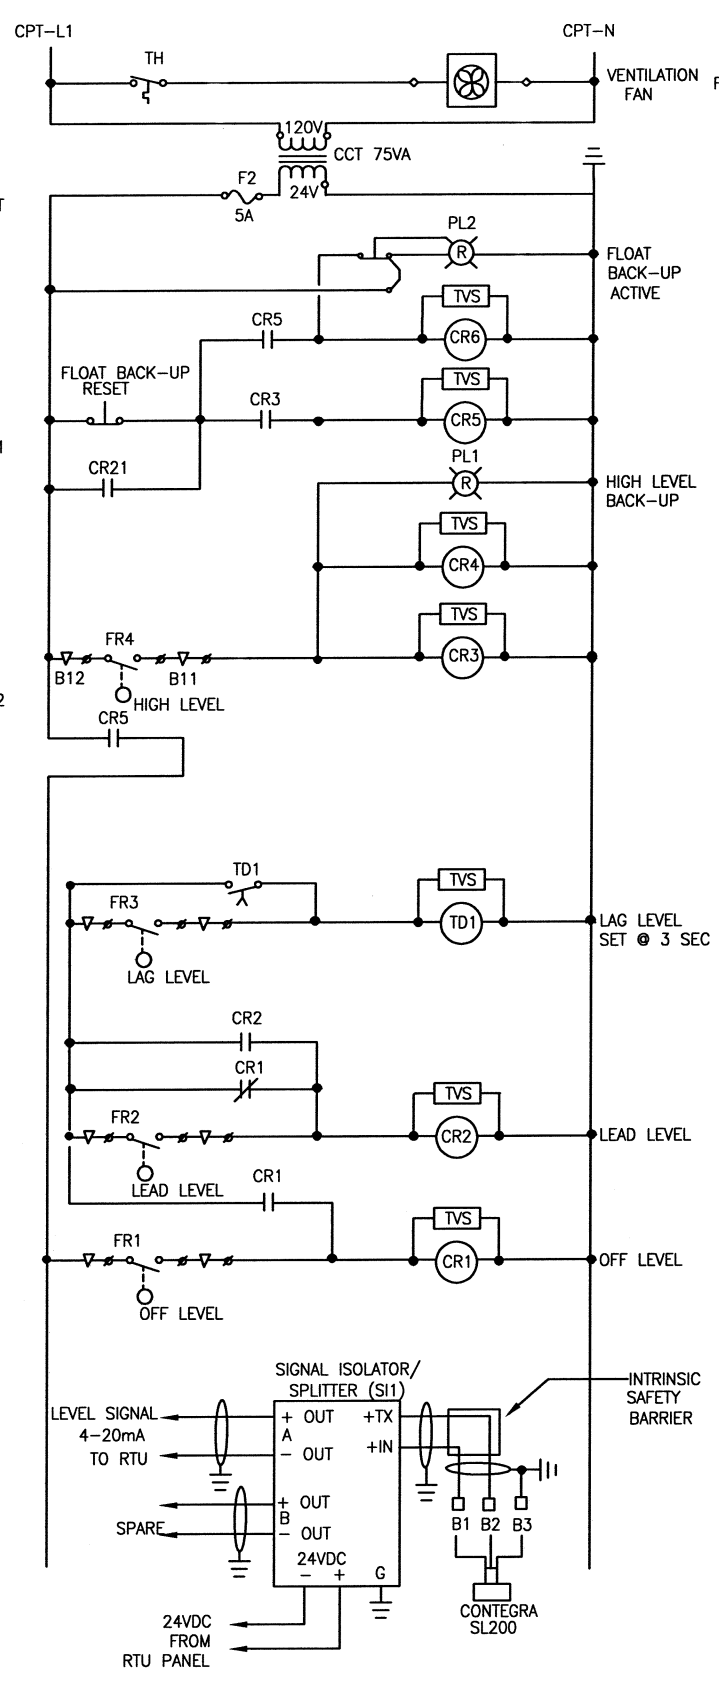


This record drawing is a compilation of the sealed engineering drawing for this project; modified by addenda, change orders and information furnished by the contractor. The information shown on the record drawings that was provided by the contractor or others not associated with the design engineer cannot be verified for accuracy or completeness. This original sealed drawings are on file at the offices of Birkhoff, Hendricks & Carter, L.L.P.


BY MH DATE 06/08/15

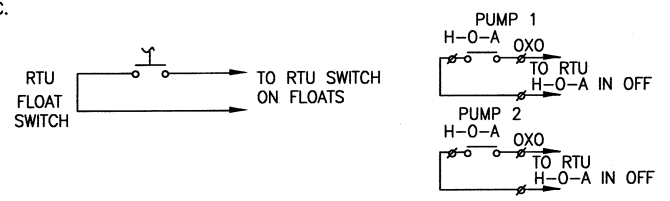

- NOTES:
- LOCATE FSL2 LOW LEVEL CUT-OFF (LLCO) FLOAT AT RECOMMENDED LEVELS BELOW LEAD LAG LEVELS.
 - LOCATE FSL1 RESET FLOAT MIN.12" ABOVE LLCO.
 - PROVIDE 3 SPARE RELAYS FOR RTU.
 - ADD NAMEPLATE ON PANEL: FOREIGN VOLTAGES IN PANEL
 - SSOLR SHALL BE ELECTRONIC RELAY.
 - PMU TO BE EATON 250/260, SEE CONTROL BLOCK DIAGRAM SHEET 20.

These plans and related specifications were prepared for construction of this specific project only. Reuse of these documents is not permitted without written authorization of Birkhoff, Hendricks & Carter, L.L.P. If this drawing is converted to an electronic file, if any discrepancy occurs between the electronic file and the Birkhoff, Hendricks & Carter, L.L.P. original document, the original document will govern in all cases.

BIRKHOFF, HENDRICKS & CARTER, L.L.P.
 PROFESSIONAL ENGINEERS
 Texas Firm F526
 11910 Greenville Ave., Suite 600
 Dallas, Texas 75243 (214) 361-7900

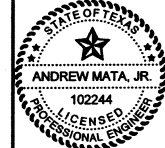

Andrew Mata, Jr.
 1/2/14

CITY OF ROCKWALL, TEXAS
 NORTHSHORE LIFT STATION
 ELECTRICAL PUMP CONTROL SCHEMATICS

BHC
 PROJECT NO. 2013-119
 January 2014
 SHEET NO. 19