


CITY OF ROCKWALL
 NORTH SHORE
 QUOTE NO. DATE DRAWN BY REVISION
 130318AA 9/18/2014 RJB B

FLYGT
 a system brand

THIS DOCUMENT IS THE PROPRIETARY PROPERTY OF FLYGT. IT HAS BEEN PREPARED UNDER THE CONDITIONS THAT IT IS NOT TO BE REPRODUCED, COPIED, DISTRIBUTED, USED OR DISCLOSED IN WHOLE OR IN PART FOR ANY PURPOSE WITHOUT THE EXPRESS WRITTEN PERMISSION OF FLYGT AND SHALL BE CONSIDERED CONFIDENTIAL INFORMATION.

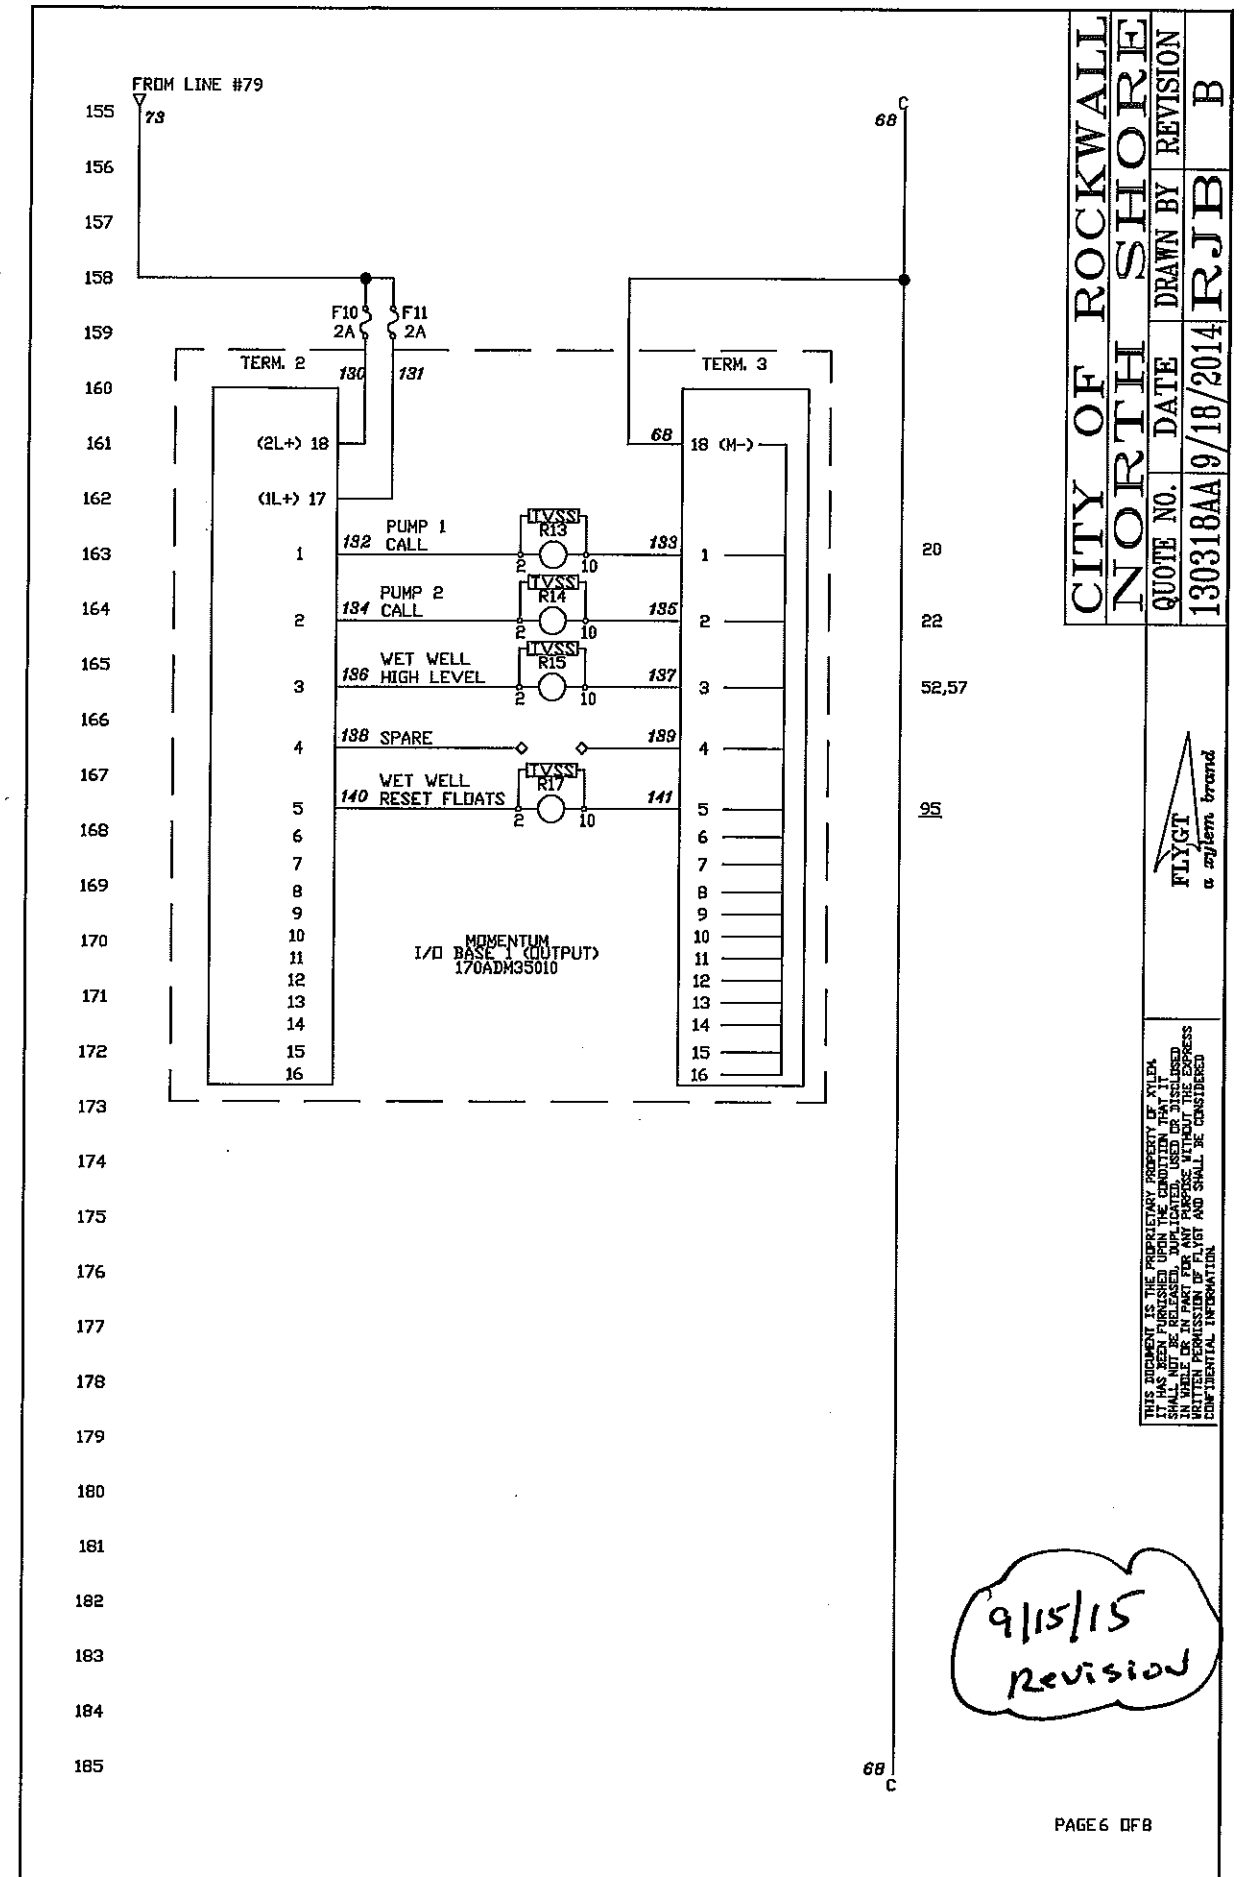

CITY OF ROCKWALL
 NORTH SHORE
 QUOTE NO. DATE DRAWN BY REVISION
 130318AA 9/18/2014 RJB B

FLYGT
 a system brand

THIS DOCUMENT IS THE PROPRIETARY PROPERTY OF FLYGT. IT HAS BEEN PREPARED UNDER THE CONDITIONS THAT IT IS NOT TO BE REPRODUCED, COPIED, DISTRIBUTED, USED OR DISCLOSED IN WHOLE OR IN PART FOR ANY PURPOSE WITHOUT THE EXPRESS WRITTEN PERMISSION OF FLYGT AND SHALL BE CONSIDERED CONFIDENTIAL INFORMATION.

9/15/15
 Revision

19D