


# CONSTRUCTION PLANS FOR HARBOR DISTRICT MASTER GRADING AND CITY INFRASTRUCTURE CITY OF ROCKWALL, TEXAS

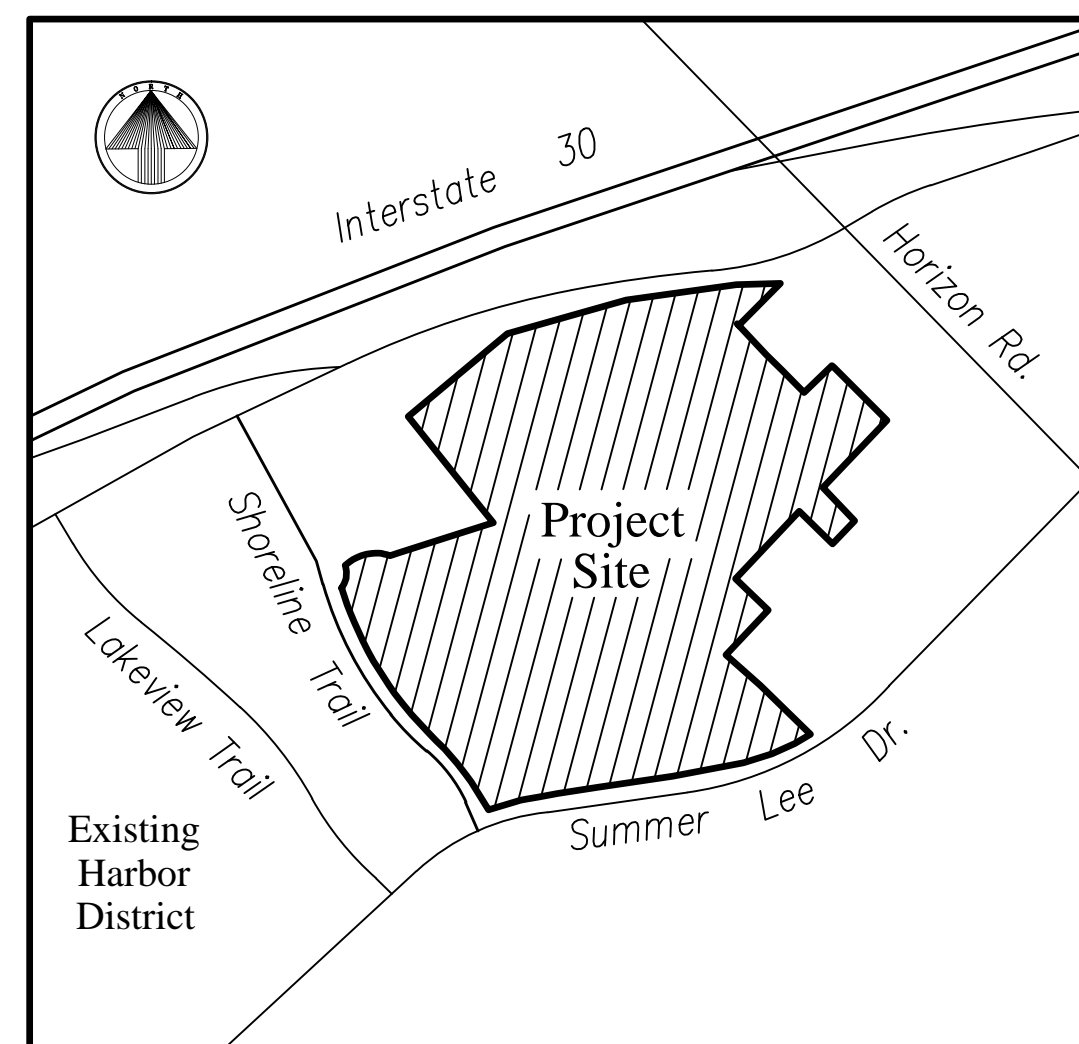

LOCATION MAP

THE SEAL APPEARING ON THIS DOCUMENT WAS AUTHORIZED BY CHRISTOPHER R. CUNY, P.E. 65642



INDEX of SHEETS

<u>Sheet No.</u>	<u>Title</u>
1	Cover Sheet
2-4	Paving Plans
5	Grading Plan
6	Erosion Control Plan
7	Water and Sanitary Sewer Plan
8-9	Sanitary Sewer Profiles
10	Drainage Area Map
11	Storm Sewer Calculations
12-15	Storm Sewer Plan and Profile
16	Atmos Energy Gas Service Plan
17	Oncor Electric Plan
17A - 17C	Electric Duct Plans
18	Master Utility Plan
18A	Sleeving Plan
19	Lift Station Plan
20	Lift Station Details
21	Retaining Wall Details

Developer / Construction Manager  
Sterling One Construction L.L.C.  
#2 Horizon Court, Suite 1000  
Heath, Texas 75032  
(972) 772-9400

RECORD DRAWINGS  
September 30, 2014



~ Engineer ~  
**F.C. CUNY CORPORATION**

#2 Horizon Court • Heath, Texas 75032 • (469) 402-7700  
Texas Registered Engineering Firm F-7449