



TYPICAL PAVING SECTION D2 - D2  
NTS

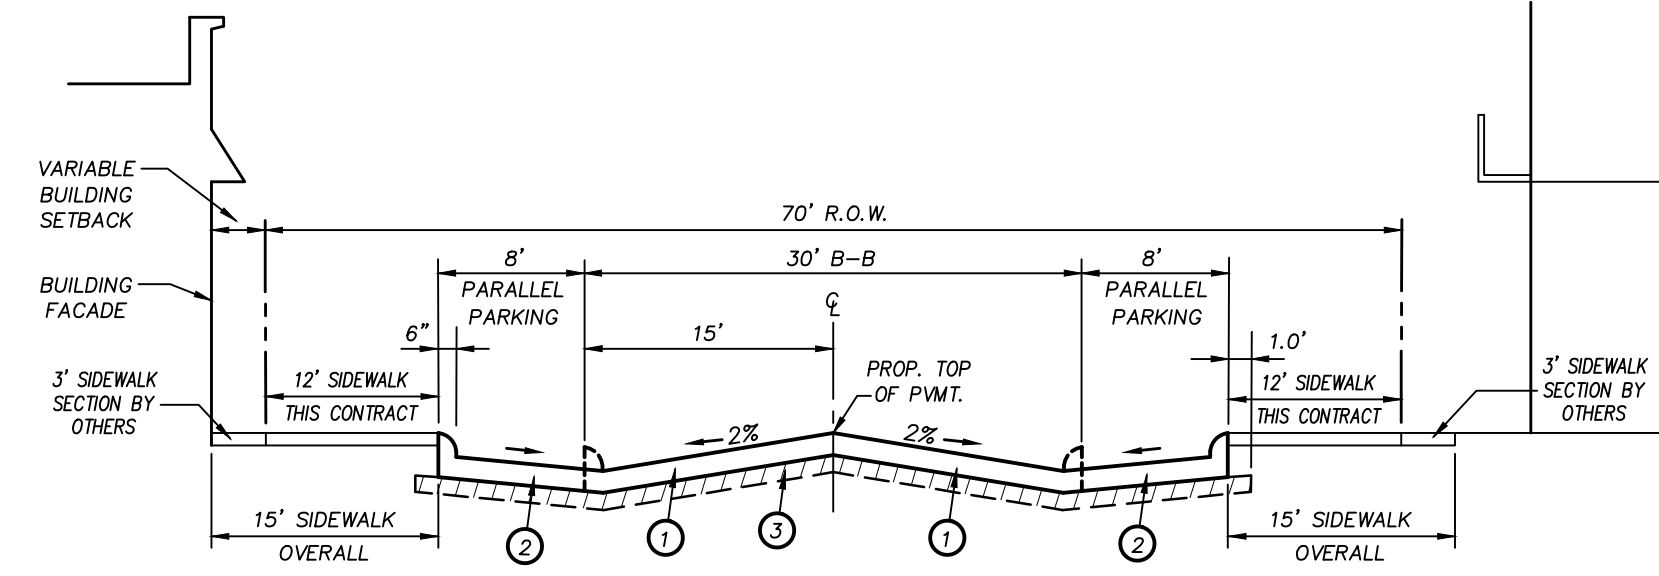


TYPICAL PAVING SECTION D - D  
NTS

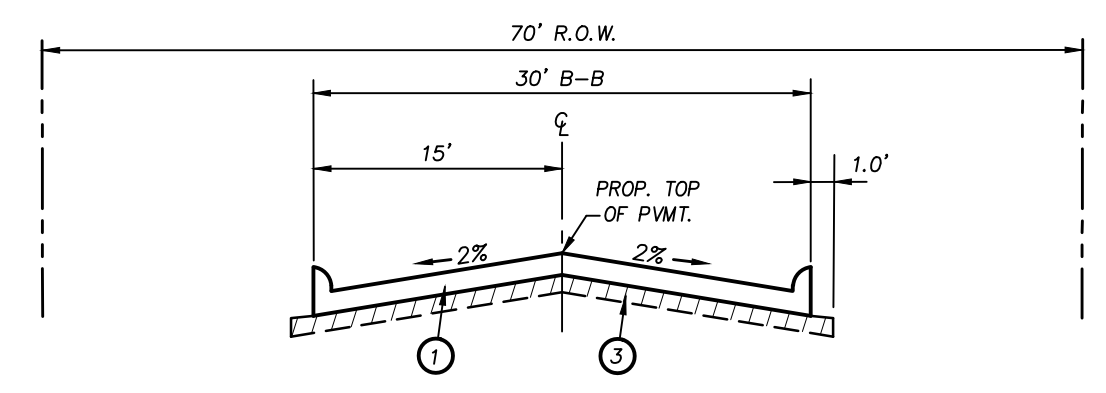

TYPICAL PAVING SECTION D1 - D1  
(TEMPORARY PAVEMENT)  
NTS


- ① 8"-3600 PSI Class "C" concrete pavement with No. 3 bars 24" on centers both ways.
  - ② 6"-3600 PSI Class "C" concrete pavement with No. 3 bars 24" on centers both ways.
  - ③ Subgrade shall be 8" thick and compacted to a density not less than 96% at 0.5-3% of optimum moisture content.
- Notes:  
1. All construction joints & rebar to be in conformance with the City of Rockwall Specifications and Standards.

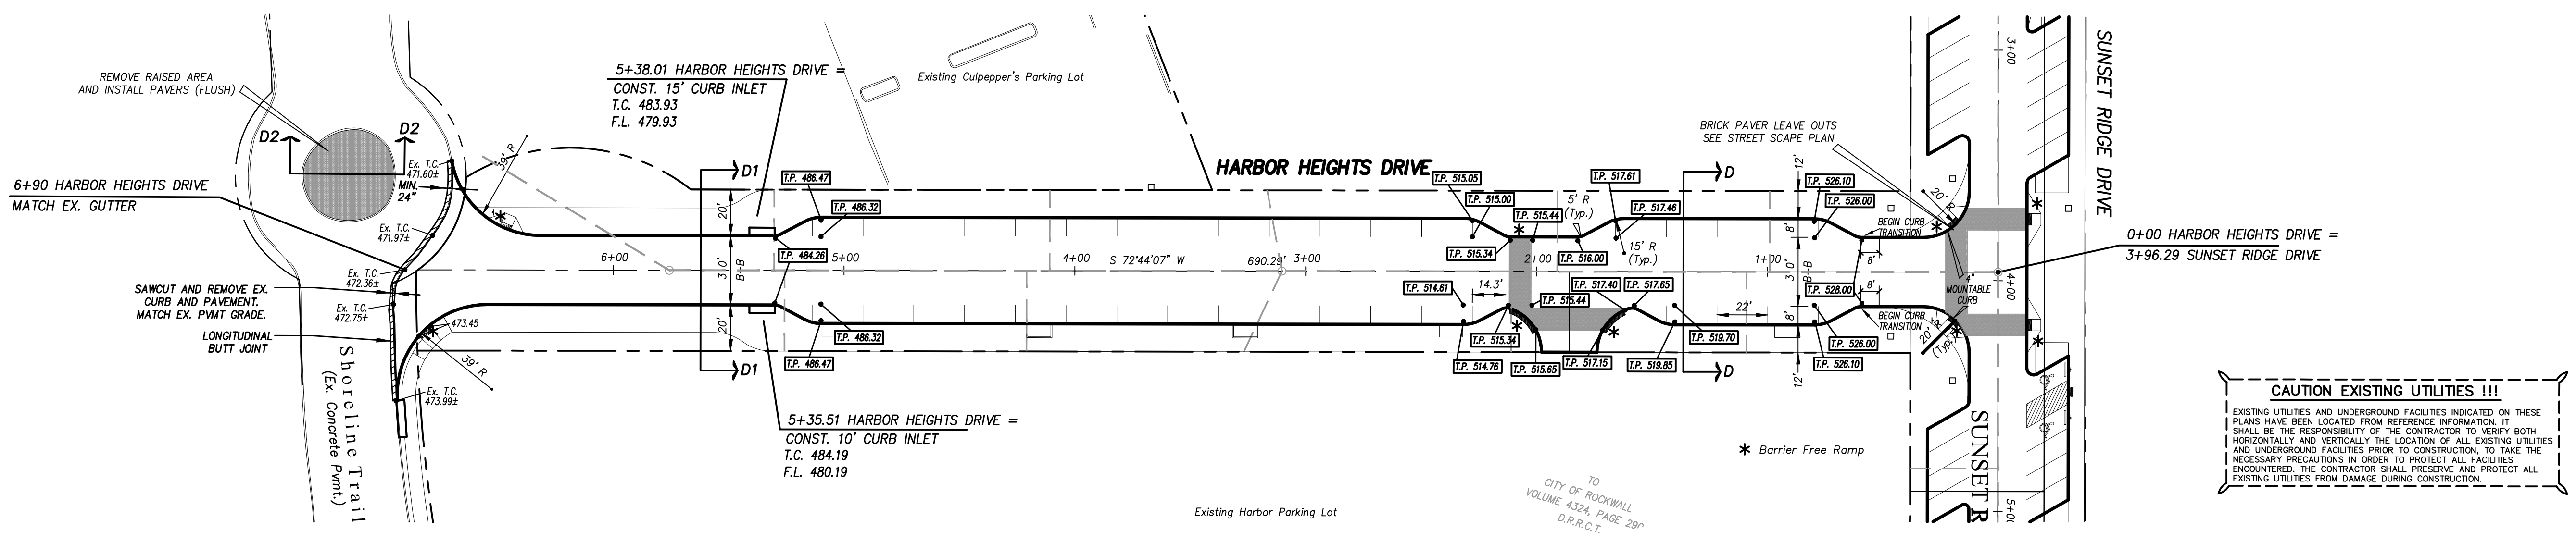

**CAUTION EXISTING UTILITIES !!!**  
EXISTING UTILITIES AND UNDERGROUND FACILITIES INDICATED ON THESE PLANS HAVE BEEN LOCATED FROM REFERENCE INFORMATION. IT SHALL BE THE RESPONSIBILITY OF THE CONTRACTOR TO VERIFY BOTH HORIZONTALLY AND VERTICALLY THE LOCATION OF ALL EXISTING UTILITIES AND UNDERGROUND FACILITIES PRIOR TO CONSTRUCTION. TO TAKE THE NECESSARY PRECAUTIONS IN ORDER TO PROTECT ALL FACILITIES ENCOUNTERED. THE CONTRACTOR SHALL PRESERVE AND PROTECT ALL EXISTING UTILITIES FROM DAMAGE DURING CONSTRUCTION.

**BENCHMARK:**  
CITY OF ROCKWALL MONUMENT, N.W. CORNER OF INLET ON LAKEVIEW TRAIL AT SUMMER LEE.  
N 7013358.3381  
E 2588850.5919  
ELEV. 468.06

HARBOR HEIGHTS DRIVE

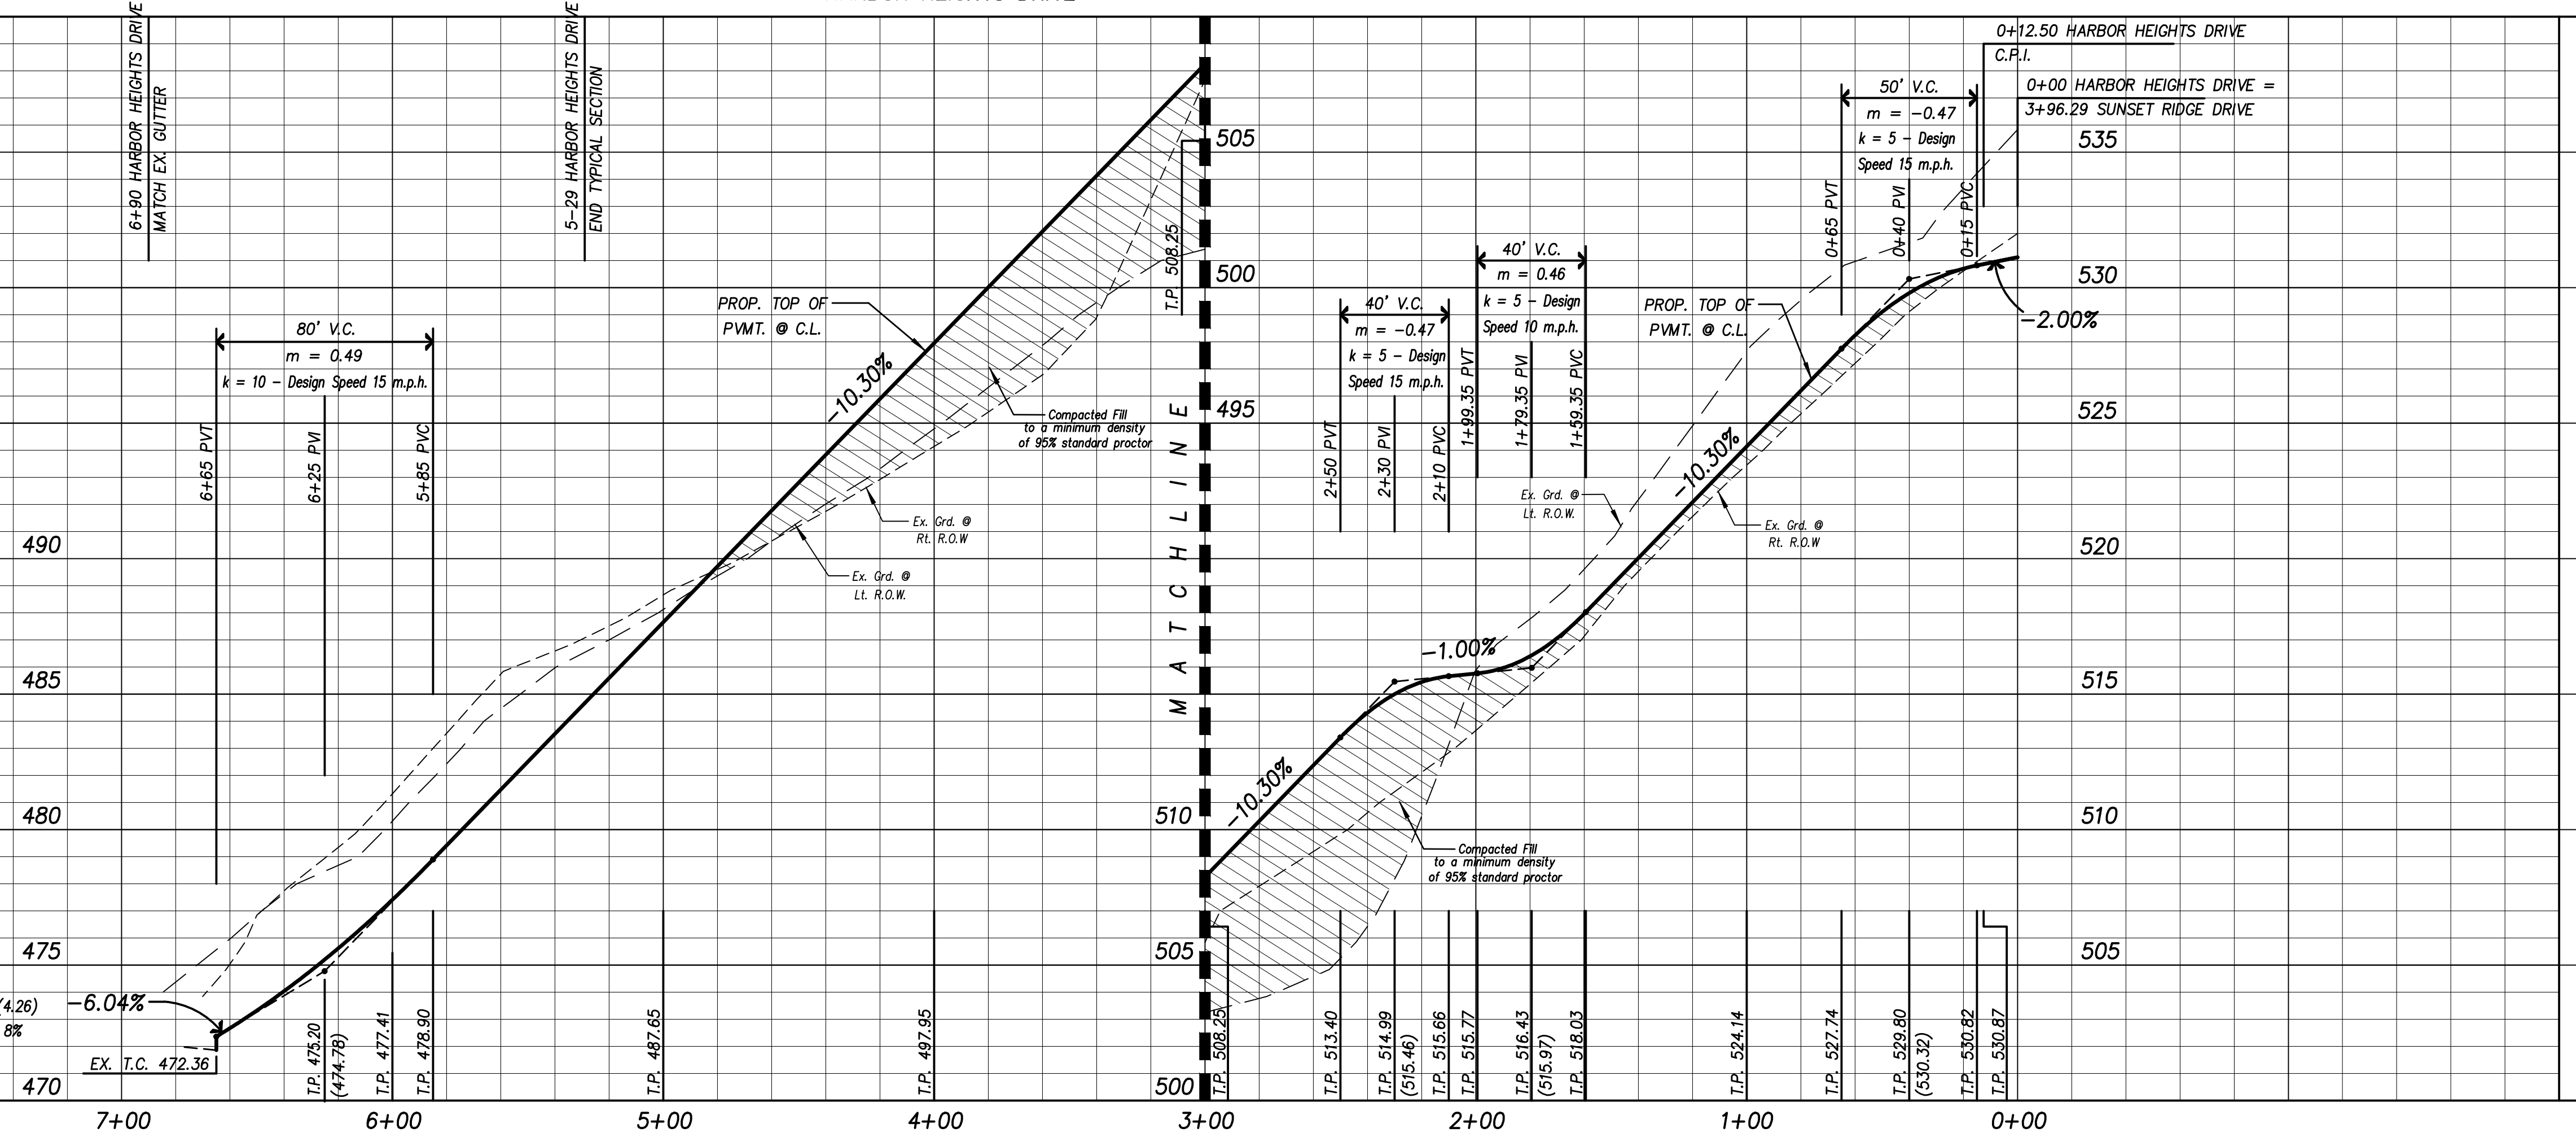

Algebraic difference (4.26)  
① sag is less than 8%

This drawing is proprietary and may not be copied or used in any way without the written permission of FC Cuny Corporation. © Copyright - FC Cuny Corporation

RECORD DRAWING

Revision	Date	Description

Owner: **CITY OF ROCKWALL**  
Developer: **Sterling One Construction L.L.C.**  
#2 Horizon Court • Heath, Texas 75032 • 469-772-9400

**Harbor District Infrastructure**  
Rockwall, Texas

~ Civil Engineer ~  
**F.C. CUNY CORPORATION**  
#2 Horizon Court • Heath, Texas 75032 • (469) 402-7700  
Texas Registered Engineering Firm F-7449

THE SEAL APPEARING ON THIS DOCUMENT WAS AUTHORIZED BY CHRISTOPHER R. CUNY, P.E. 65642

Drawn By: F.C. CUNY  
Checked By: F.C. CUNY  
Date: 08/11  
Project No.:  
Sheet Title: **Paving Plan & Profile Harbor Heights Drive**  
Scale: Sheet No.:  
H: 1"=40'  
V: 1"=4'  
3 of 21