

LEGEND	
	PROPOSED WATER LINE
	PROPOSED PRIVATE WATER LINE
	PROPOSED SANITARY SEWER LINE
	PROPOSED PRIVATE SANITARY SEWER LINE
	PROPOSED PRIVATE STORM LINE
	PROPOSED STORM LINE
	PROPOSED ELECTRIC DUCT BANK
	PROPOSED PRIVATE ELECTRIC LINE
	PROPOSED GAS LINE
	PROPOSED TELEPHONE LINE

This drawing is proprietary and may not be copied or used in any way without the written permission of FC Cunny Corporation - © Copyright - FC Cunny Corporation


Revision	Date	Description

Owner:
CITY OF ROCKWALL
 Developer:
Sterling One Construction L.L.C.
 #2 Horizon Court • Heath, Texas 75032 • 469-772-9400

Harbor District Infrastructure
 Rockwall, Texas

~ Civil Engineer ~
F.C. CUNY CORPORATION
 #2 Horizon Court • Heath, Texas 75032 • (469) 402-7700
 Texas Registered Engineering Firm F-7449

THE SEAL APPEARING ON THIS DOCUMENT WAS AUTHORIZED BY CHRISTOPHER R. CUNY, P.E. 65642

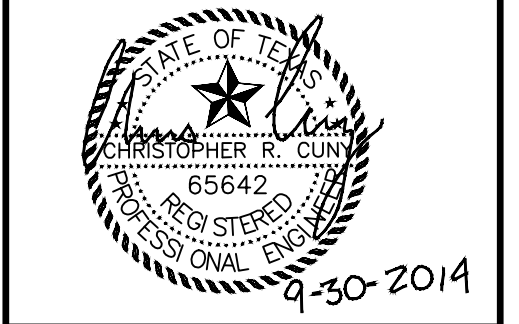

Drawn By: F.C. CUNY	Checked By: F.C. CUNY
Date: 06/11	Project No.:

Sheet Title:
Master Utility Plan

Scale: 1" = 50'	Sheet No.:
--------------------	------------