

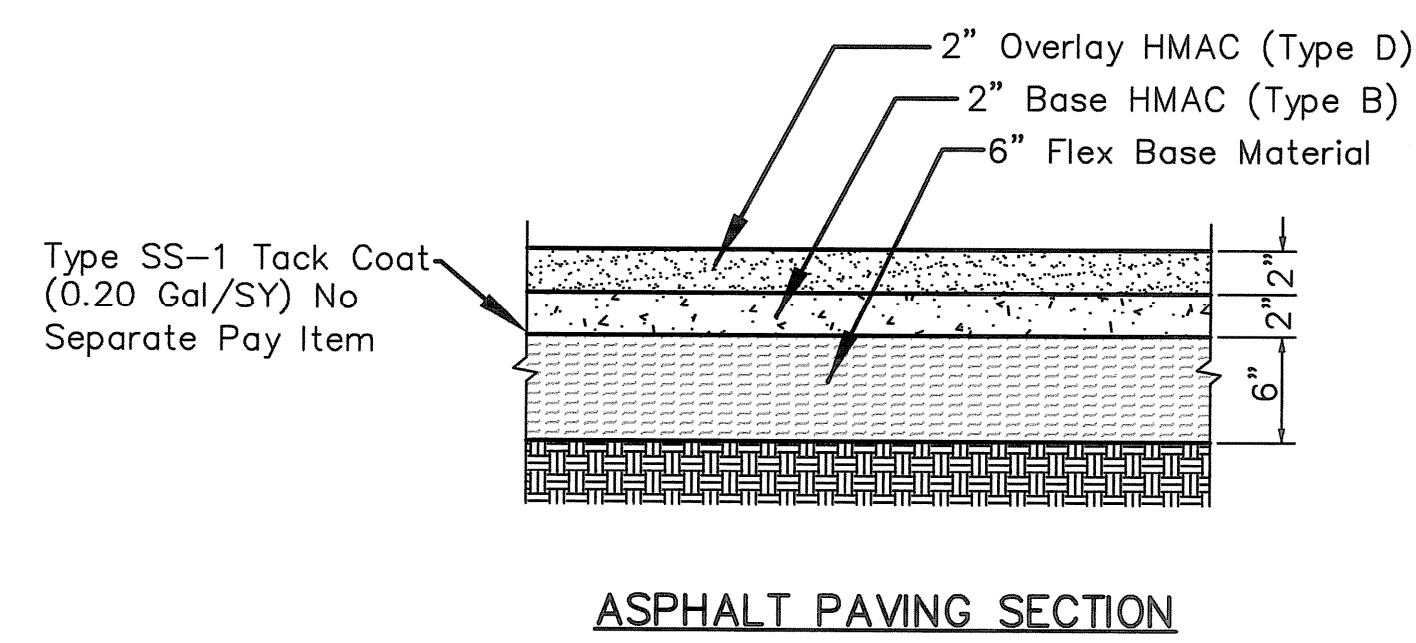


SCALE : 1" = 10'

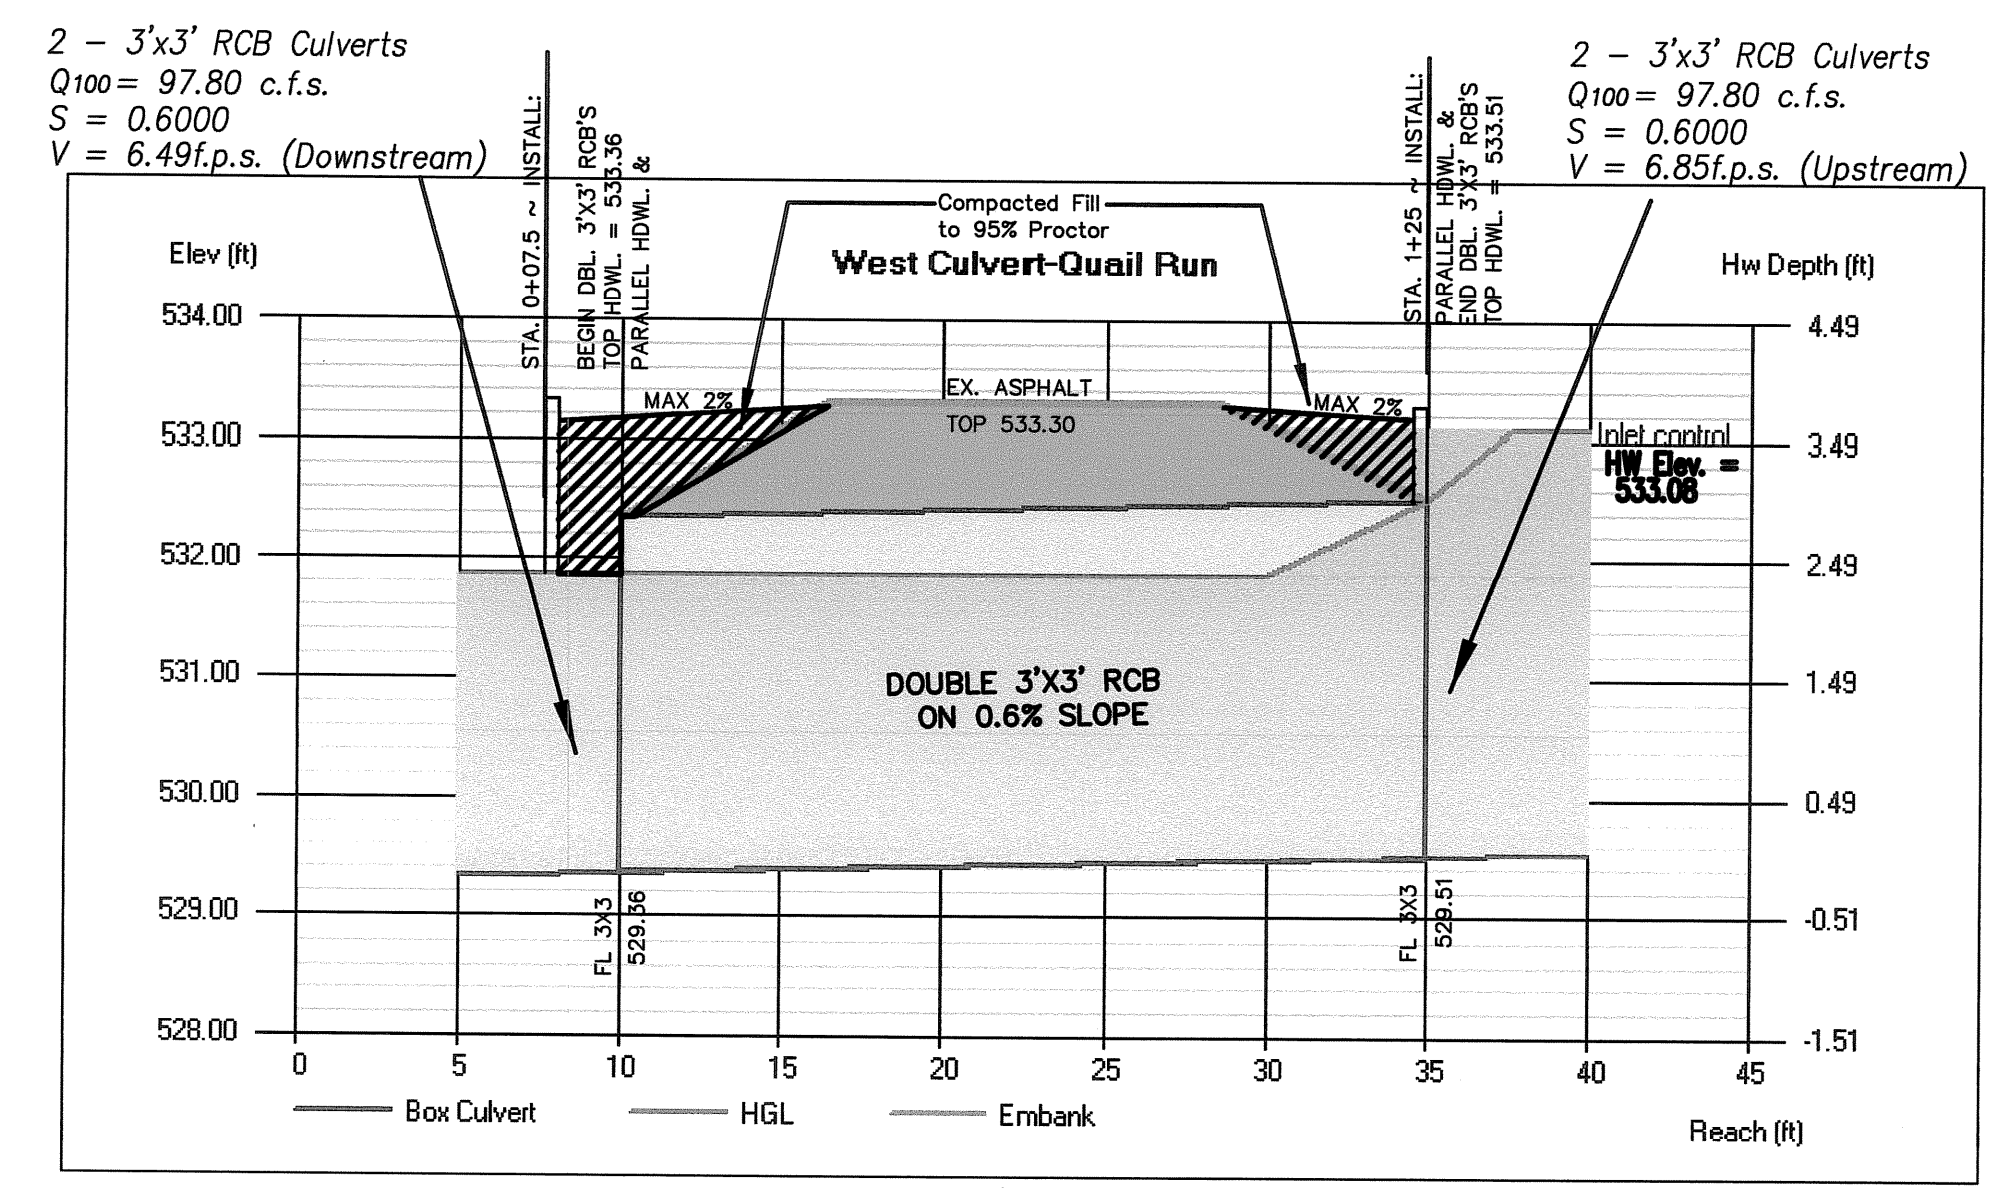

- NOTES**
1. ALL CONSTRUCTION TO BE BUILT USING THE STANDARDS AND DETAILS SHOWN IN NCTCOG 3RD EDITION STANDARDS AND CITY OF ROCKWALL STANDARDS OF DESIGN.
 2. THERE IS TO BE NO REVISIONS TO THESE PLANS WITHOUT THE CONSENT OF THE CITY OF ROCKWALL CITY ENGINEER.
 3. ALL COMPACTION SHALL BE 95% STD. DENSITY AND COMPACTED USING A SHEEPS FOOT ROLLER.
 4. NO CONSTRUCTION ALLOWED OUTSIDE OF THE RIGHT-OF-WAY.
 5. EACH CULVERT WILL BE FULLY CONSTRUCTED ONE AT A TIME (INCLUDING PAVING OVER CULVERT) PRIOR TO ROADWAY PAVING IMPROVEMENTS (SHEET 2).
 6. ACCESS TO EXISTING PROPERTY TO BE MAINTAINED DURING CONSTRUCTION

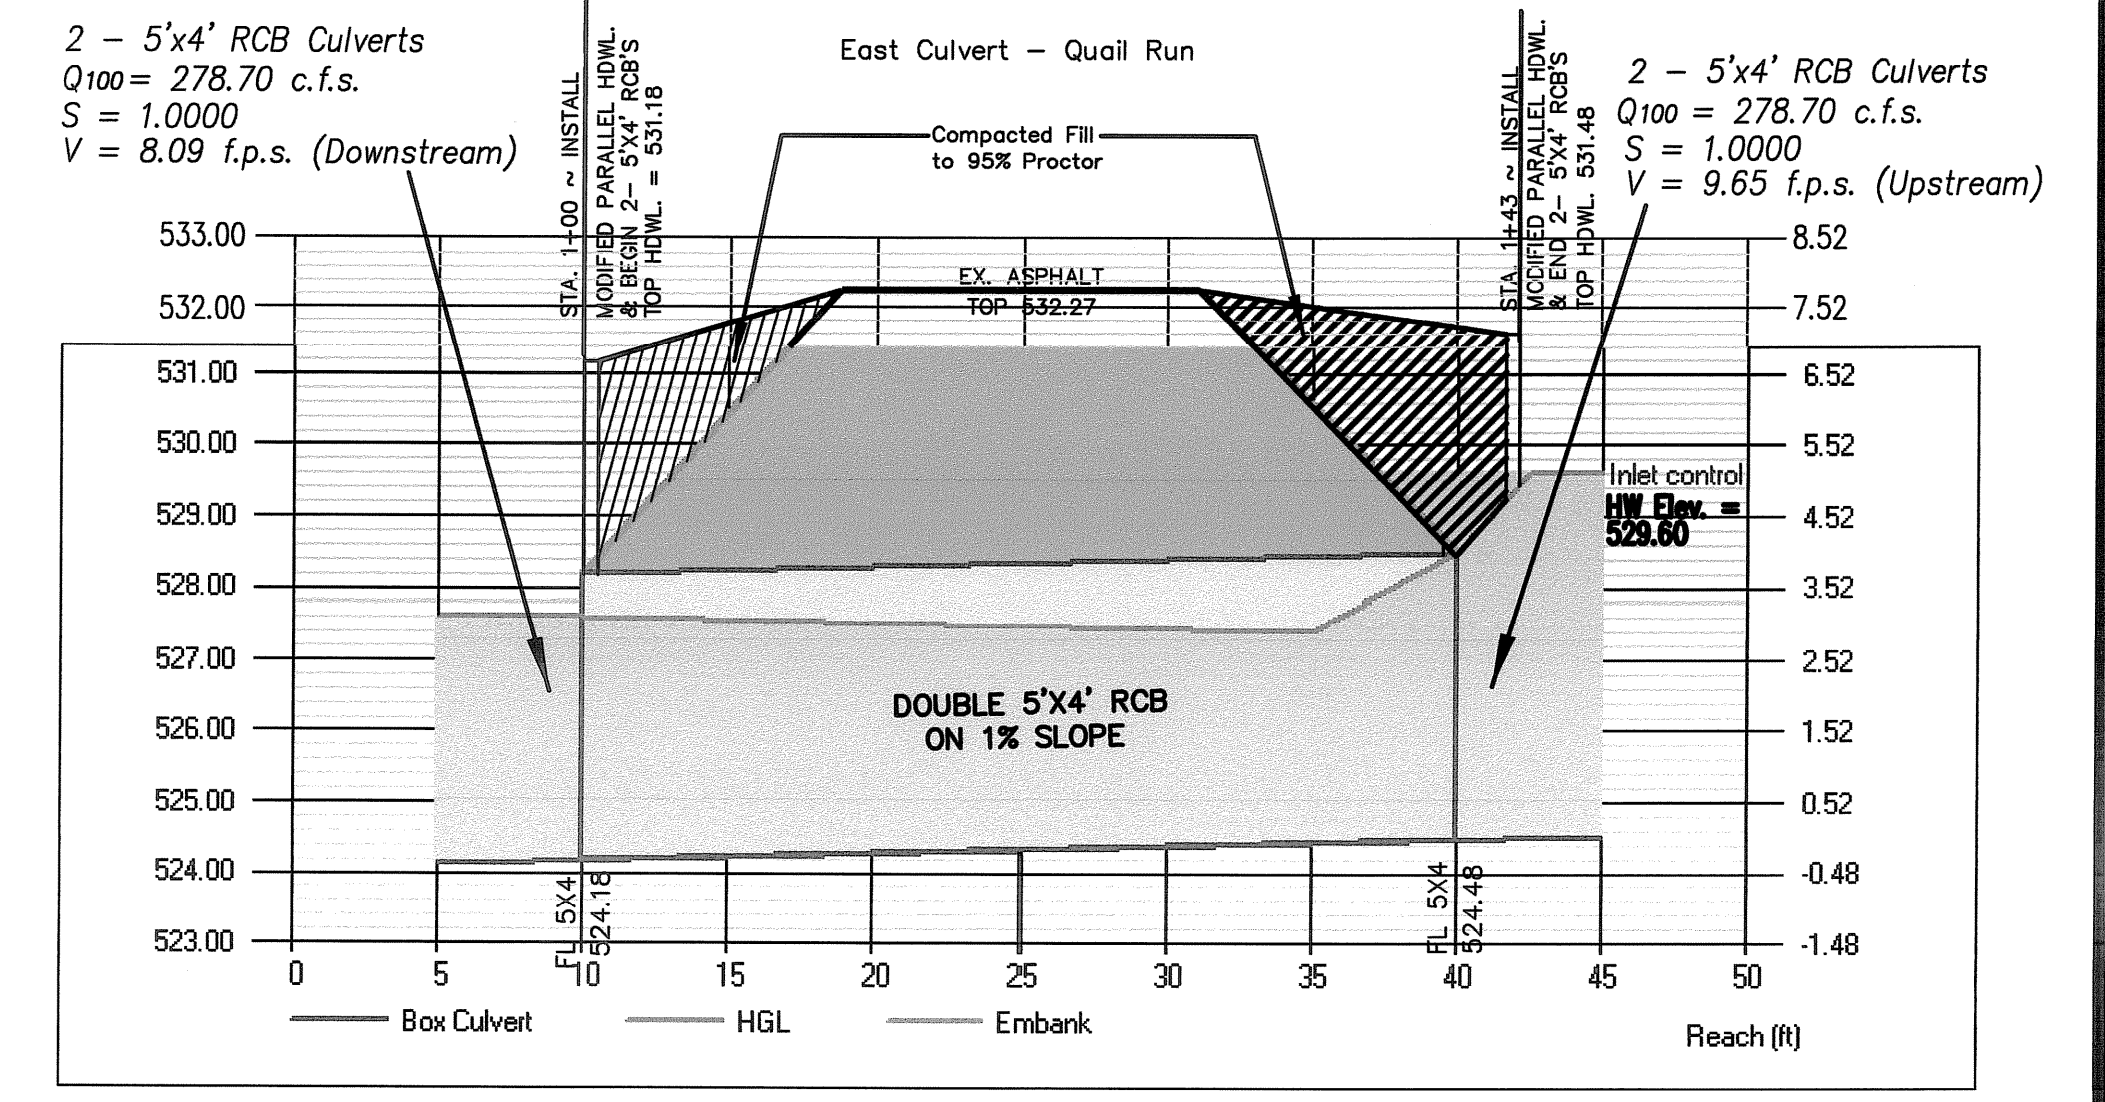

BOX CULVERT IMPROVEMENTS
QUAIL RUN ROAD
ROCKWALL, TEXAS
CITY OF ROCKWALL
 "THE NEW HORIZON"

DESIGNED: AJW
 DRAWN: ACAD
 JOB NO. QuailRun Box Culvert Plan.dwg
 DATE: 2/22/12
 SHEET NO. 1 OF 2

AMY J. WILLIAMS
 99406
 REGISTERED PROFESSIONAL ENGINEER

REVISION NO.	REMARKS	DATE

10/22/12
 AS BUILT