

NOTES:
 1. SUPPORT CABLES FROM HANGER BAR WITH KELLUMS STANDARD DUTY UNIVERSAL EYE CABLE SUPPORT GRIPS.


01 LEVEL SWITCHES - QUAIL RUN
 NOT TO SCALE

These plans and related specifications were prepared for construction of this specific project only. Reuse of these documents is not permitted without written authorization of Birkhoff, Hendricks, & Conway, L.L.P.

ELECTRICAL SITE PLAN
 SCALE: 1"=10'-0"

REVISED TO CONFORM TO CONSTRUCTION RECORDS BY PAC DATE 10/31/03

VERIFY SCALE
 Bar is one inch on original drawing.
 If not one inch on this sheet, adjust scale accordingly.

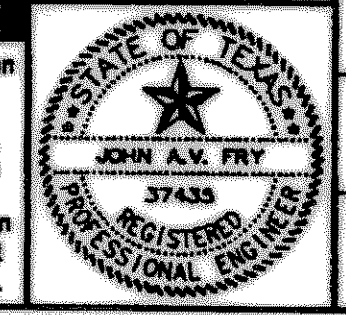

CITY OF ROCKWALL, TEXAS

QUAIL RUN LIFT STATION
ELECTRICAL SITE PLAN

BIRKHOFF, HENDRICKS & CONWAY, L.L.P.
 CONSULTING ENGINEERS
 Dallas, Texas

DESIGNED BY: J.A.V.F. PROJECT NO: 2000-172 SHEET NO. E1
 DRAWN BY: R.E.B. DATE: DECEMBER 2001 OF 4 SHEETS

John A.V. Fry
 13 Dec. 01