

REVISIONS: 3/12/09 - GCEKU  
H:\Projects\Rockwall\2006153\Sheets\2006153-01.dwg  
PLOT SCALE: 1:2,013  
PLOT STYLE: 11x17.ctb  
PLOTTED BY: GCEKU ON 3/12/2009

# CITY OF ROCKWALL, TEXAS

## CONSTRUCTION PLANS FOR

# R.C.H. WATER SUPPLY CORPORATION METER VAULT REPLACEMENTS

### COUNCIL MEMBERS

- BILL CECIL, MAYOR
- STEPHEN STRAUGHAN, MAYOR PRO-TEM
- DAVID SWEET
- MATT SCOTT
- GLENN FERRIS
- CLIFF SEVIER
- MARGO NIELSEN

### CITY MANAGER


JULIE COUCH

### ASSISTANT CITY MANAGER

RICHARD CROWLEY

### CITY ENGINEER

CHUCK TODD, P.E.


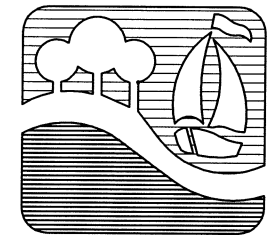


**BIRKHOFF, HENDRICKS & CONWAY, L.L.P.**  
CONSULTING ENGINEERS  
Dallas, Texas

DECEMBER, 2007



*[Signature]*  
12/7/07

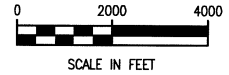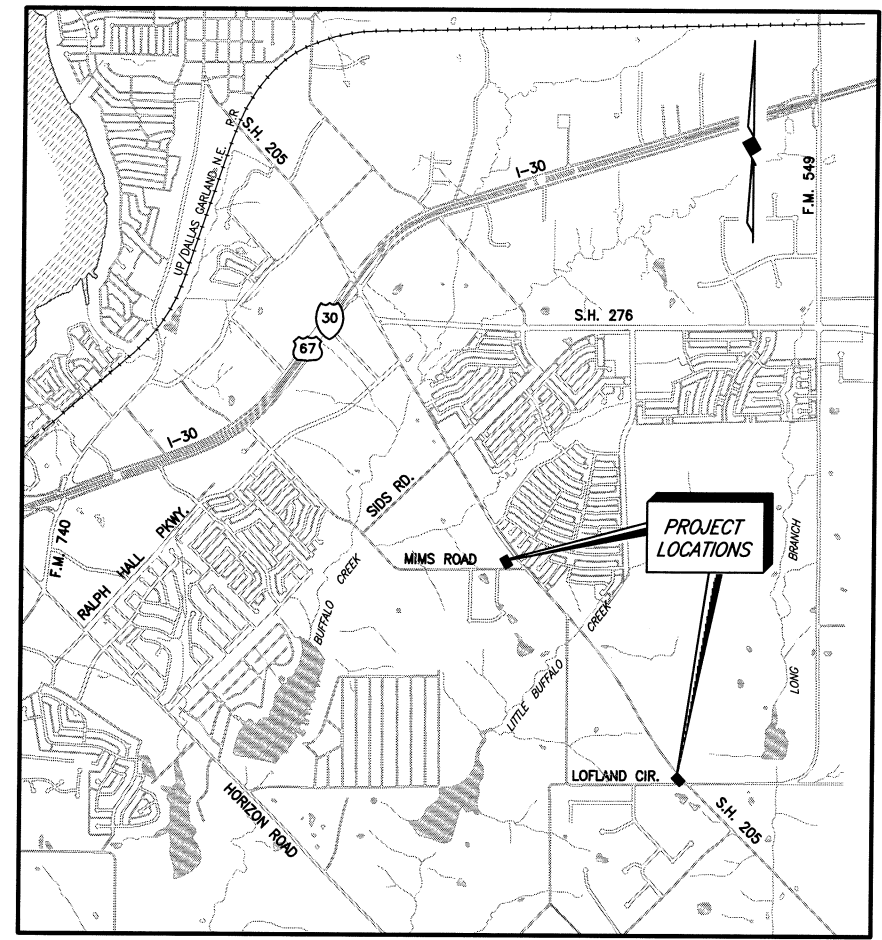

LOCATION MAP

### SHEET INDEX

<u>SHEET NO.</u>	<u>SHEET DESCRIPTION</u>
1	COVER SHEET AND LOCATION MAP
2	METER NO. 1 REPLACEMENT
3	METER NO. 2 REPLACEMENT
4	NOTES AND DETAILS

*This record drawing is a compilation of the sealed engineering drawing for this project; modified by addenda, change orders and information furnished by the contractor. The information shown on the record drawings that was provided by the contractor or others not associated with the design engineer cannot be verified for accuracy or completeness. This original sealed drawings are on file at the offices of Birkhoff, Hendricks & Conway, L.L.P.*

BY P.A.C. DATE 03/12/09