

PLOTTED BY: ANGEL ON 7/13/2009
PLOT STYLE: 11x17.ctb
PLOT SCALE: 1:2
H:\Projects\Rockwall\2006150\RCRCH WSC TRANSFER\Sheets\06150-01-COVER.dwg
REVISED: 7/9/09 - ANGEL

CITY OF ROCKWALL, TEXAS

CONSTRUCTION PLANS FOR:

RCH WSC SERVICE AREA TRANSFER



COUNCIL MEMBERS

BILL CECIL, MAYOR
CLIFFORD "CLIFF" SEVIER
DAVID SWEET
MATT SCOTT
GLEN FERRIS
MARK RUSSO
MARGO NIELSEN

CITY MANAGER

JULIE COUCH

ASSISTANT CITY MANAGER

RICK CROWLEY

CITY ENGINEER


CHUCK TODD, P.E.

BIRKHOFF, HENDRICKS & CONWAY, L.L.P.
PROFESSIONAL ENGINEERS
Texas Firm F526
11910 Greenville Ave., Suite 600
Dallas, Texas 75243 (214) 361-7900

SHEET INDEX

<u>SHEET NO.</u>	<u>SHEET DESCRIPTION</u>
------------------	--------------------------

- | | |
|---|----------------------|
| 1 | COVER SHEET |
| 2 | PROJECT LOCATION MAP |
| 3 | LOCATIONS 1 & 2 |
| 4 | LOCATIONS 3 & 4 |
| 5 | LOCATIONS 5 & 6 |
| 6 | LOCATIONS 7 & 8 |
| 7 | LOCATIONS 9 & 10 |
| 8 | LOCATIONS 11 & 12 |

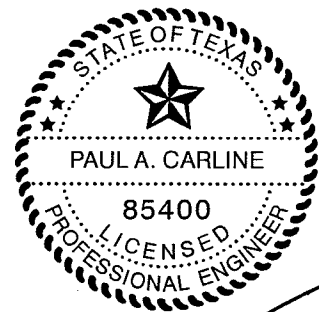

[Handwritten Signature]
7/13/09

July, 2009

*This record drawing is a compilation of the sealed engineering drawing for this project; modified by addenda, change orders and information furnished by the contractor. The information shown on the record drawings that was provided by the contractor or others not associated with the design engineer cannot be verified for accuracy or completeness. This original sealed drawings are on file at the offices of Birkhoff, Hendricks & Conway, L.L.P.
BY P.A.C. DATE 10/09/09*