
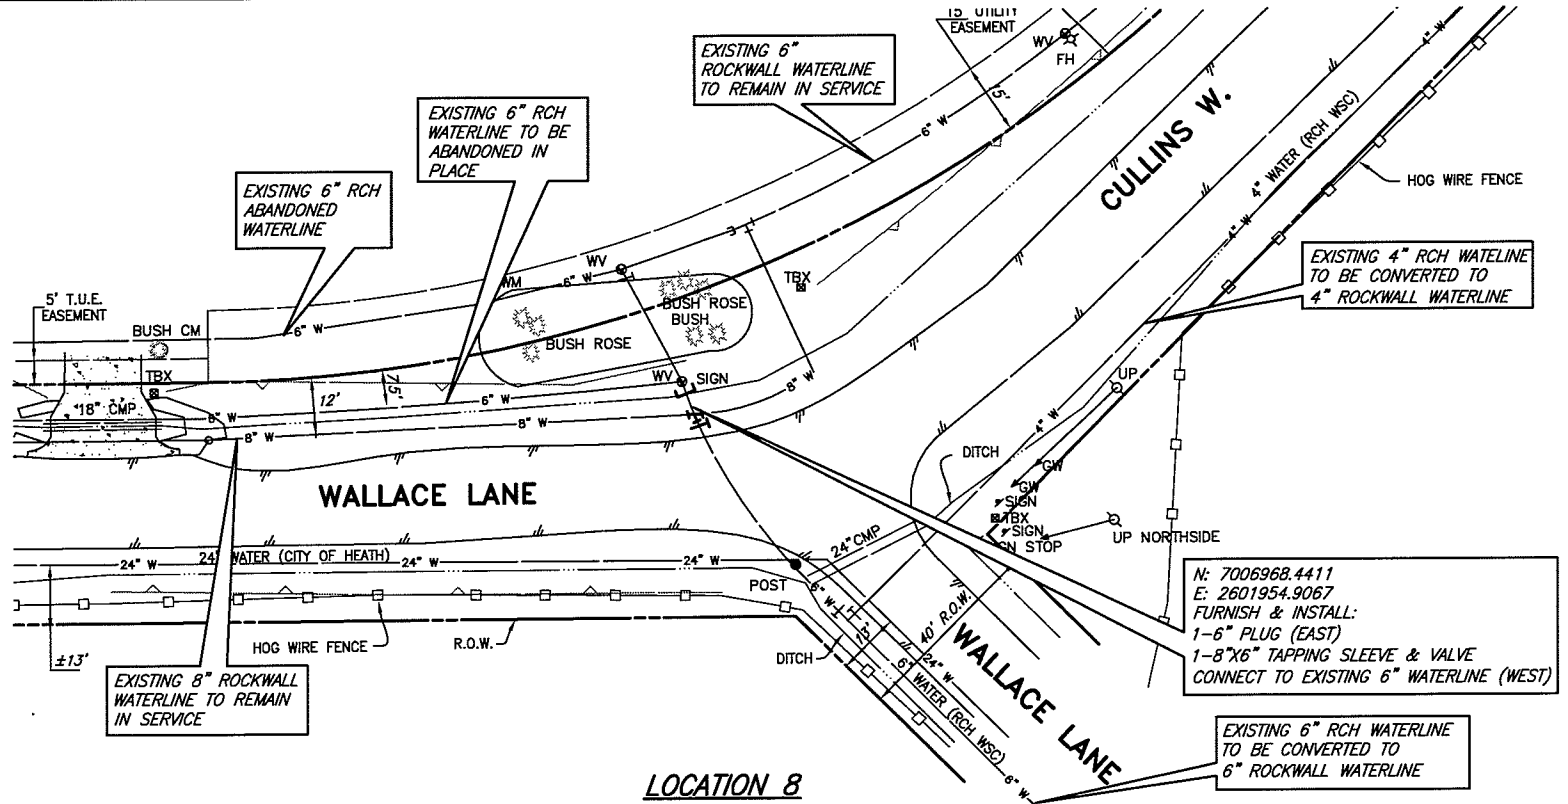


CAUTION!!
 RCH WSC WATER LINES IN AREA.
 CONTRACTOR TO CONFIRM LOCATIONS
 PRIOR TO CONSTRUCTION.
 CONTACT MR. DWIGHT LINDOP WITH
 RCH WSC AT 972-670-9091 PRIOR
 TO CONSTRUCTION.

LOCATION 7


N: 7007850.4770
 E: 2601928.8332
 TRANSFER EXISTING SERVICES
 FROM 6" RCH WATERLINE
 FURNISH & INSTALL:
 2-2" SERVICE SADDLES
 10 L.F. 2" WATERLINE
 2-2" PLUGS (RCH)

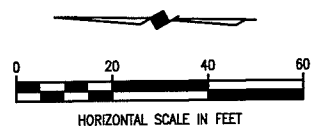

LOCATION 8

N: 7006968.4411
 E: 2601954.9067
 FURNISH & INSTALL:
 1-6" PLUG (EAST)
 1-8"x6" TAPPING SLEEVE & VALVE
 CONNECT TO EXISTING 6" WATERLINE (WEST)

CAUTION!!
 RCH WSC WATER LINES IN AREA.
 CONTRACTOR TO CONFIRM LOCATIONS
 PRIOR TO CONSTRUCTION.
 CONTACT MR. DWIGHT LINDOP WITH
 RCH WSC AT 972-670-9091 PRIOR
 TO CONSTRUCTION.

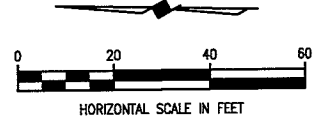

This record drawing is a compilation of the sealed engineering drawing for this project; modified by addenda, change orders and information furnished by the contractor. The information shown on the record drawings that was provided by the contractor or others not associated with the design engineer cannot be verified for accuracy or completeness. This original sealed drawings are on file at the offices of Birkhoff, Hendricks & Conway, L.L.P. BY P.A.C. DATE 10/09/09

These plans and related specifications were prepared for construction of this specific project only. Reuse of these documents is not permitted without written authorization of Birkhoff, Hendricks & Conway, L.L.P.

BIRKHOFF, HENDRICKS & CONWAY, L.L.P.
 PROFESSIONAL ENGINEERS
 Texas Firm F526
 11910 Greenville Ave., Suite 600
 Dallas, Texas 75243 (214) 361-7900



Paul A. Carline

CITY OF ROCKWALL, TEXAS
 RCH WSC SERVICE AREA TRANSFER
 LOCATION 7 & 8

BHC
 PROJECT NO.
 2007-150
 July, 2009

SHEET NO.
6