


STORM DRAIN PARKWAY
 CITY OF ROCKWALL
 ROCKWALL COUNTY, TEXAS



STORM DRAIN LINE "D"

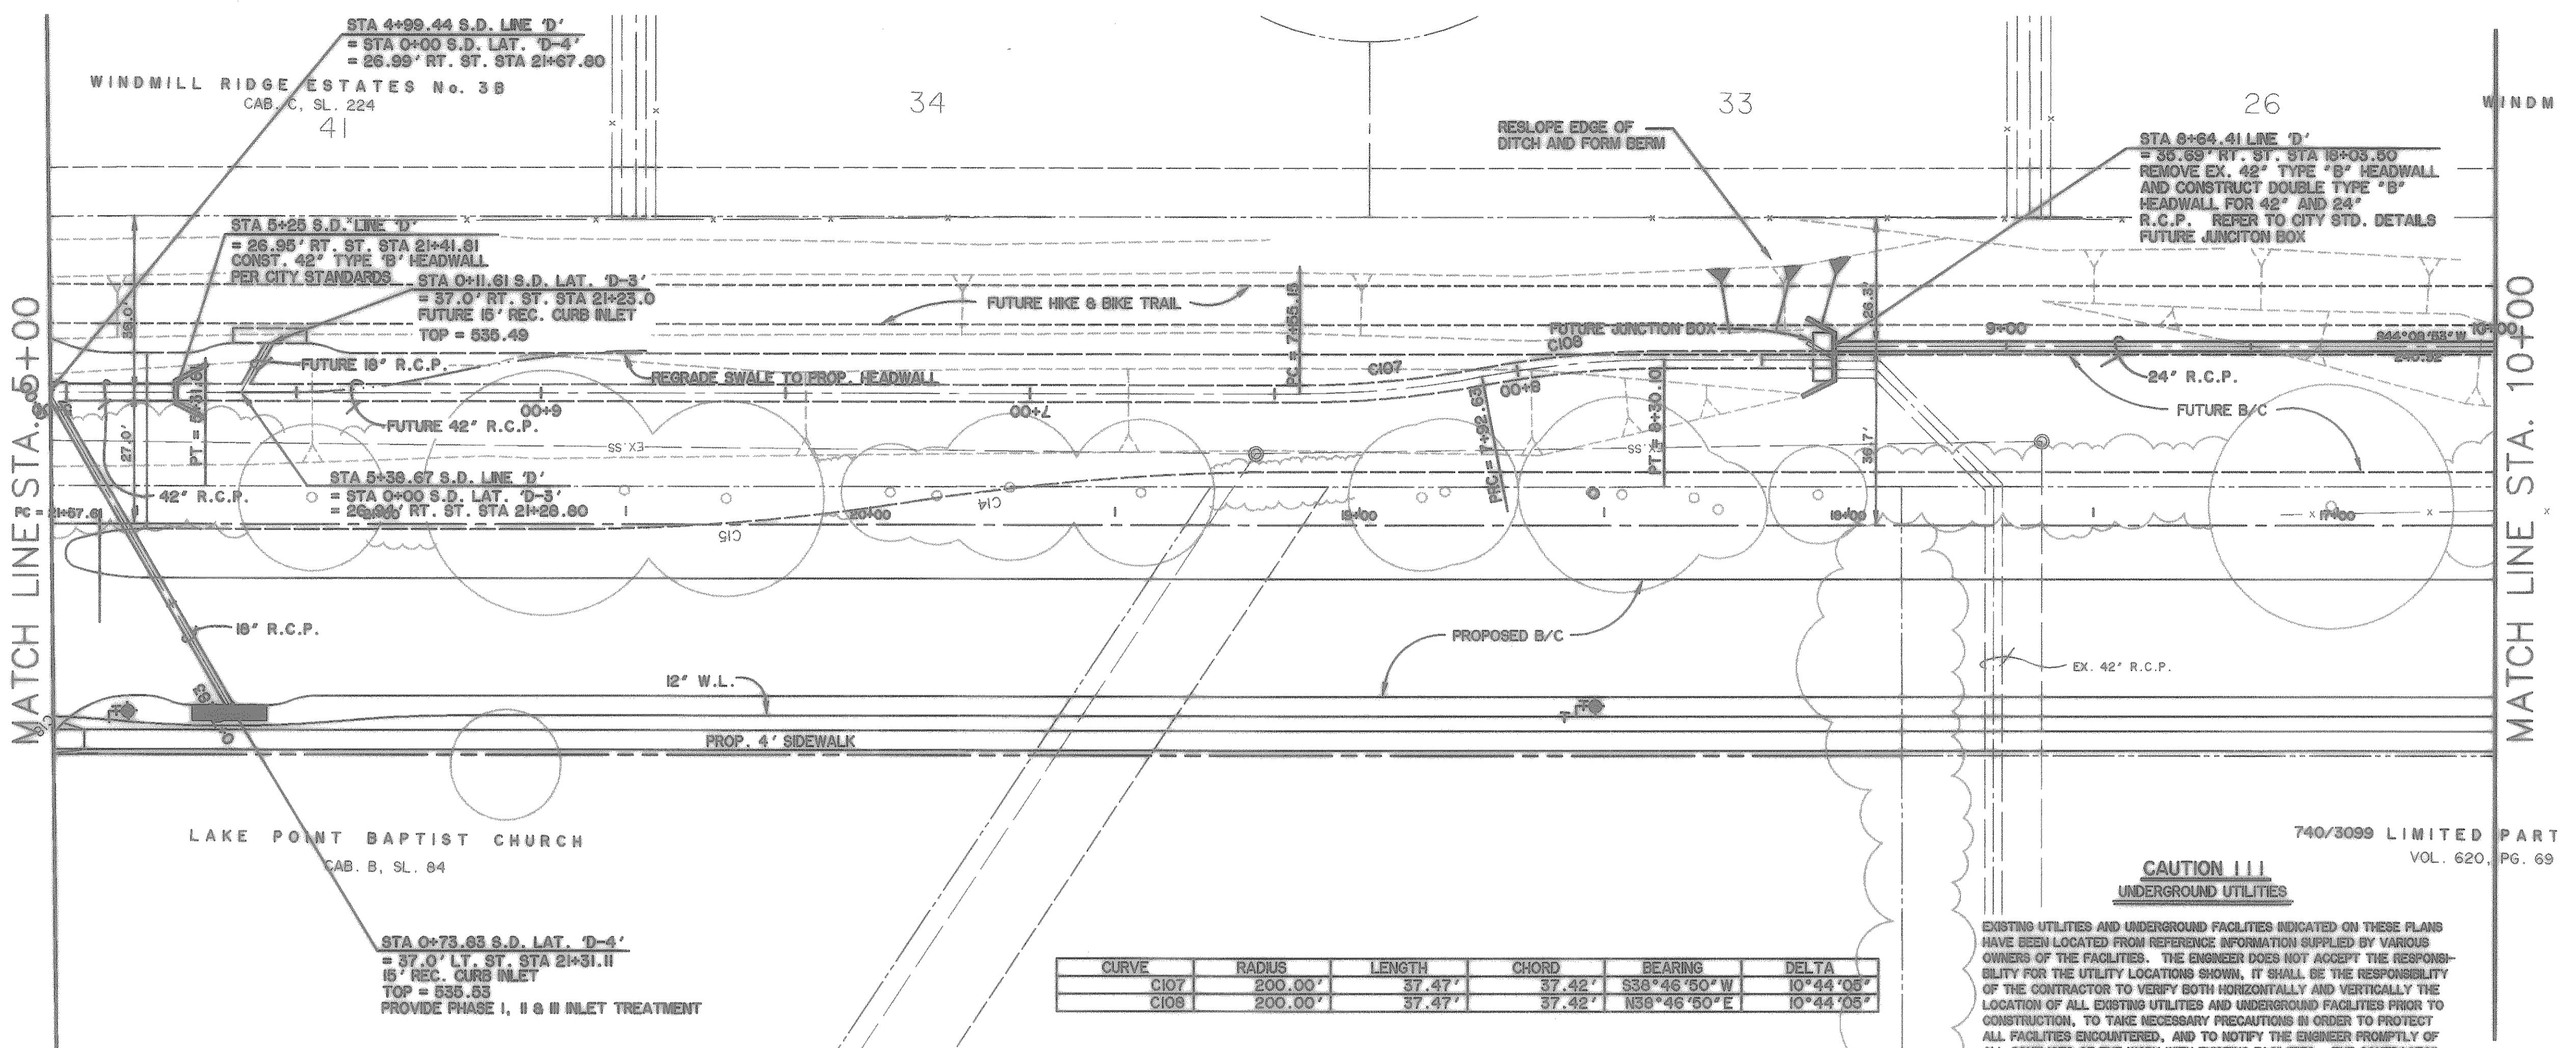