

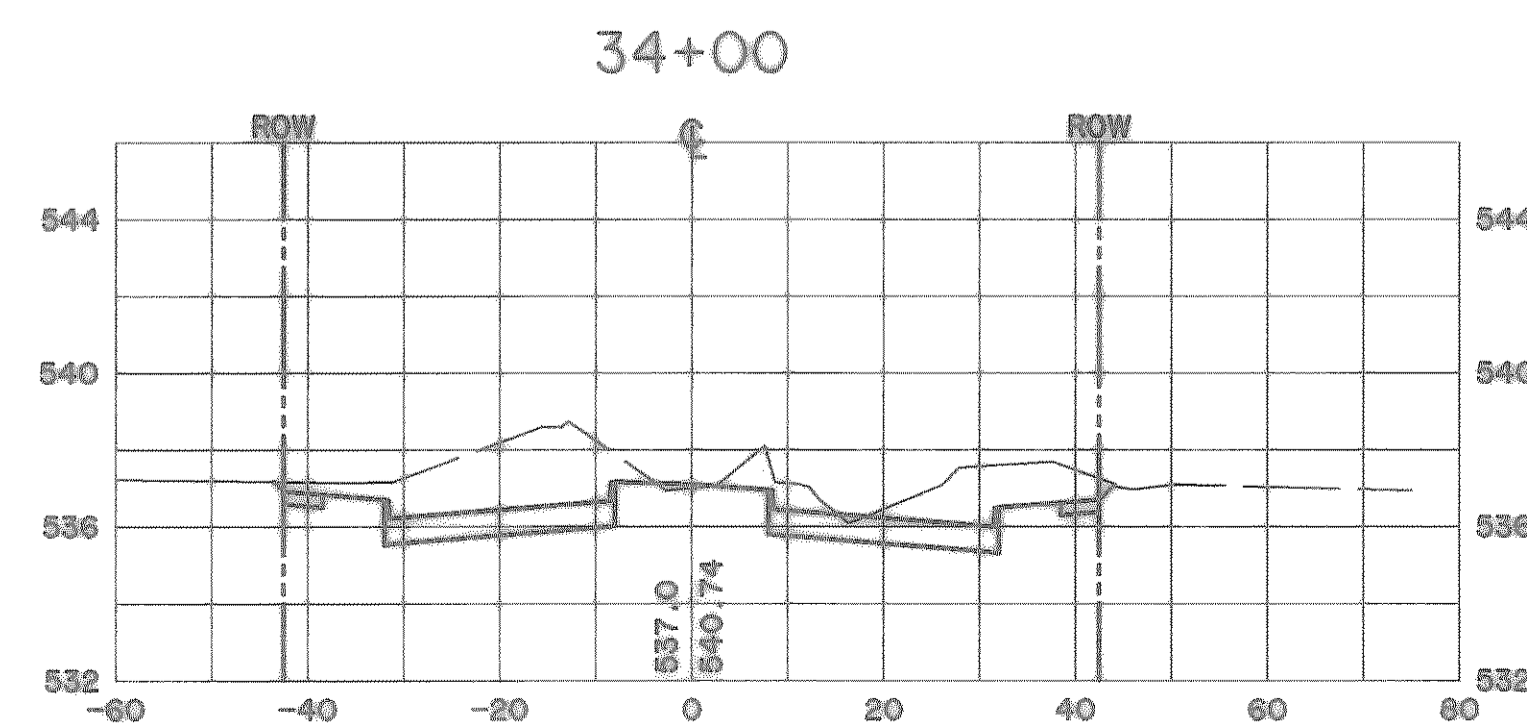
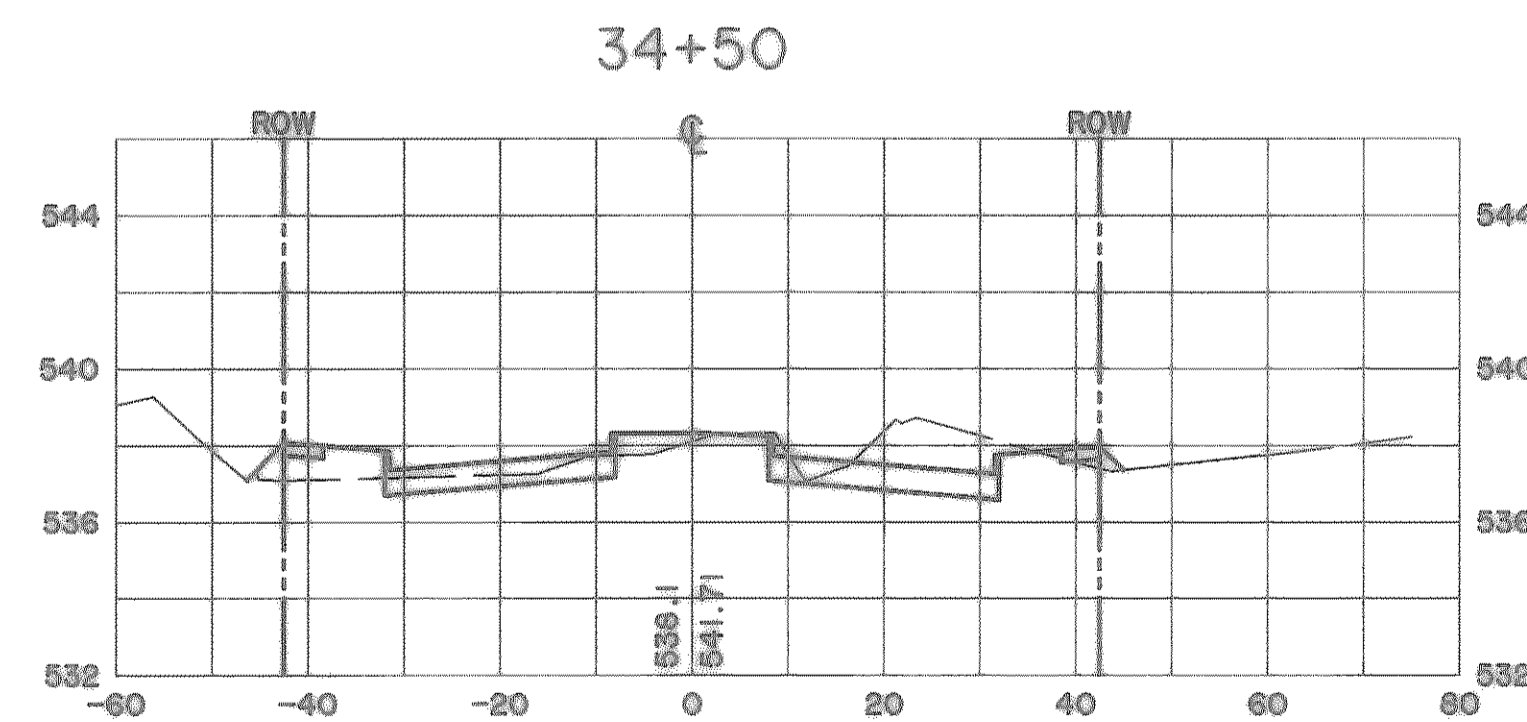
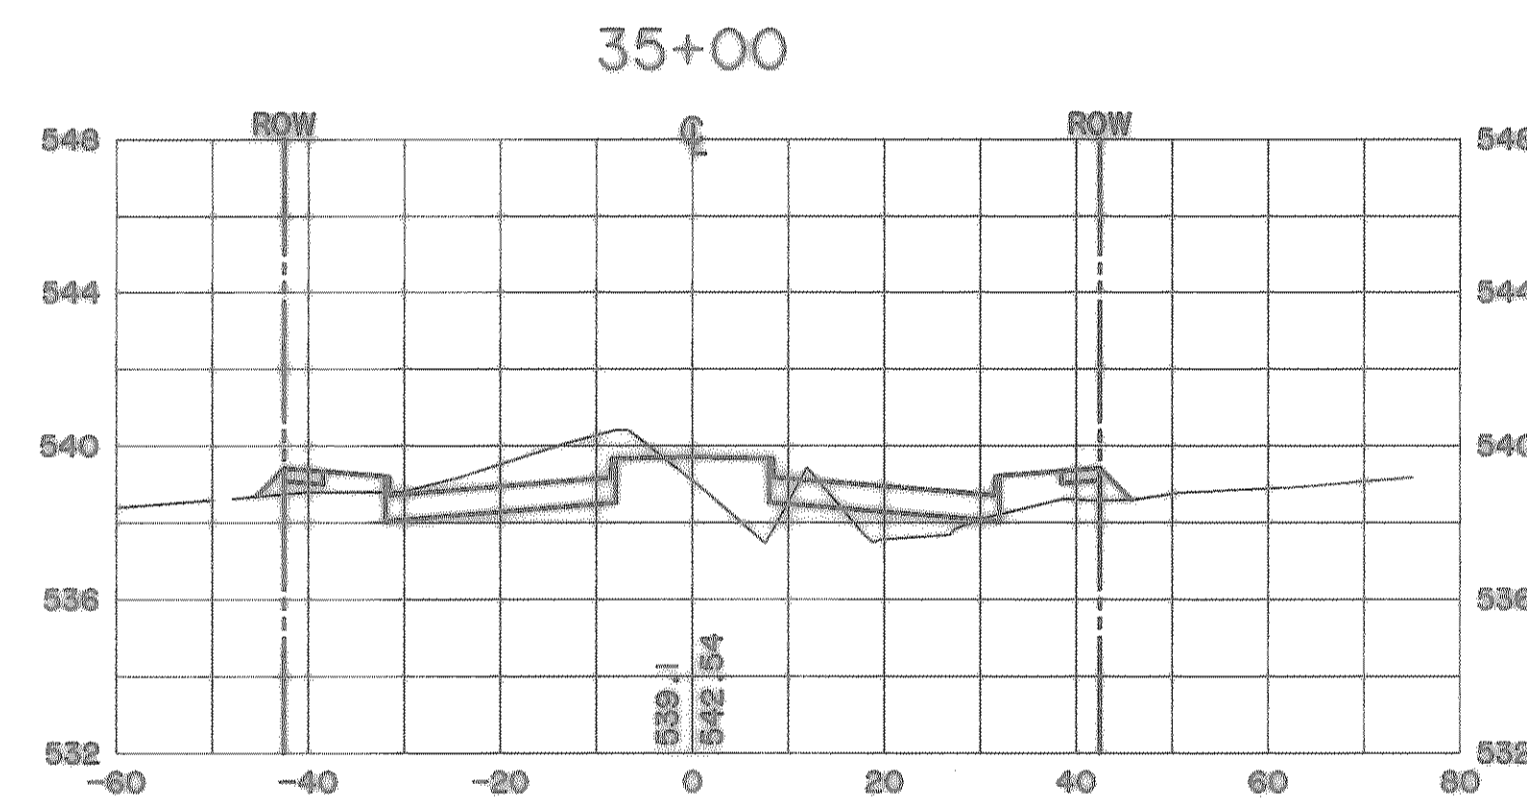
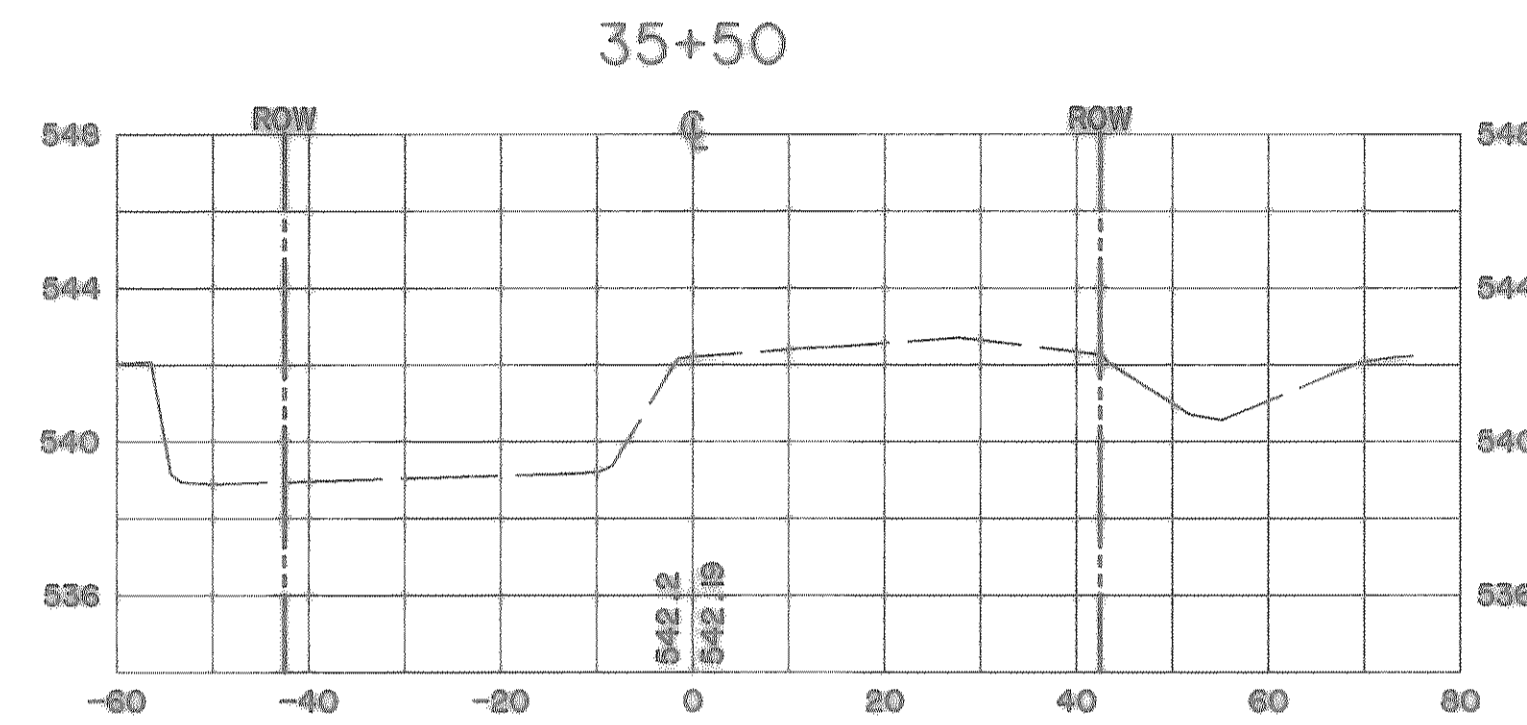
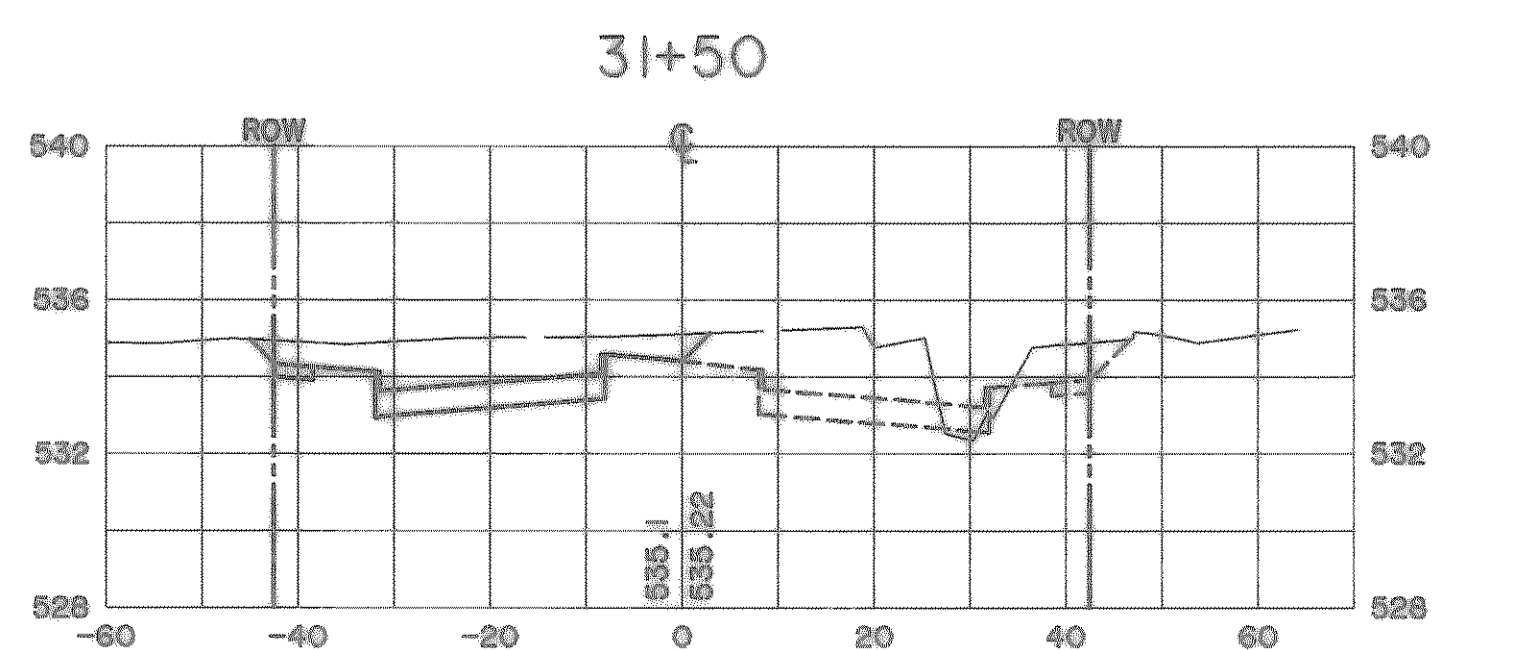
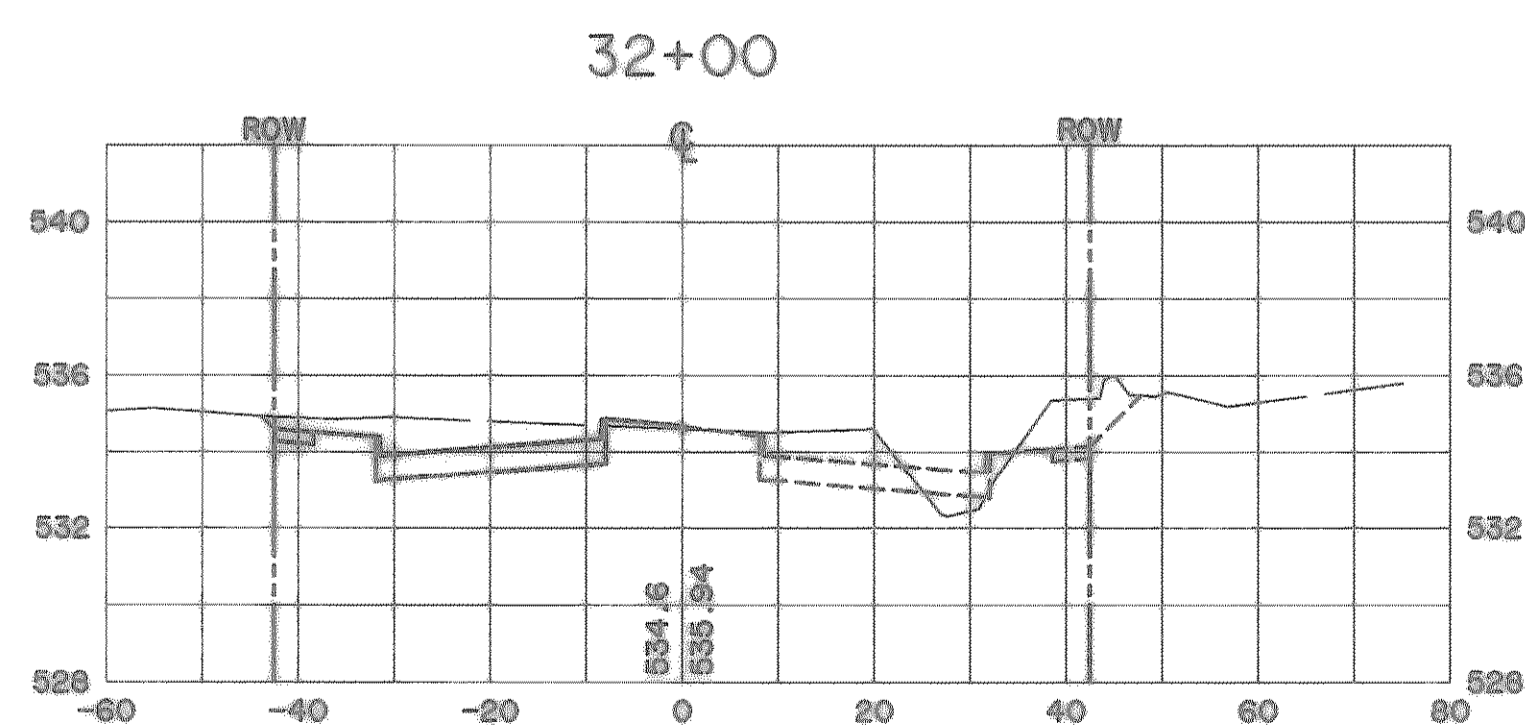
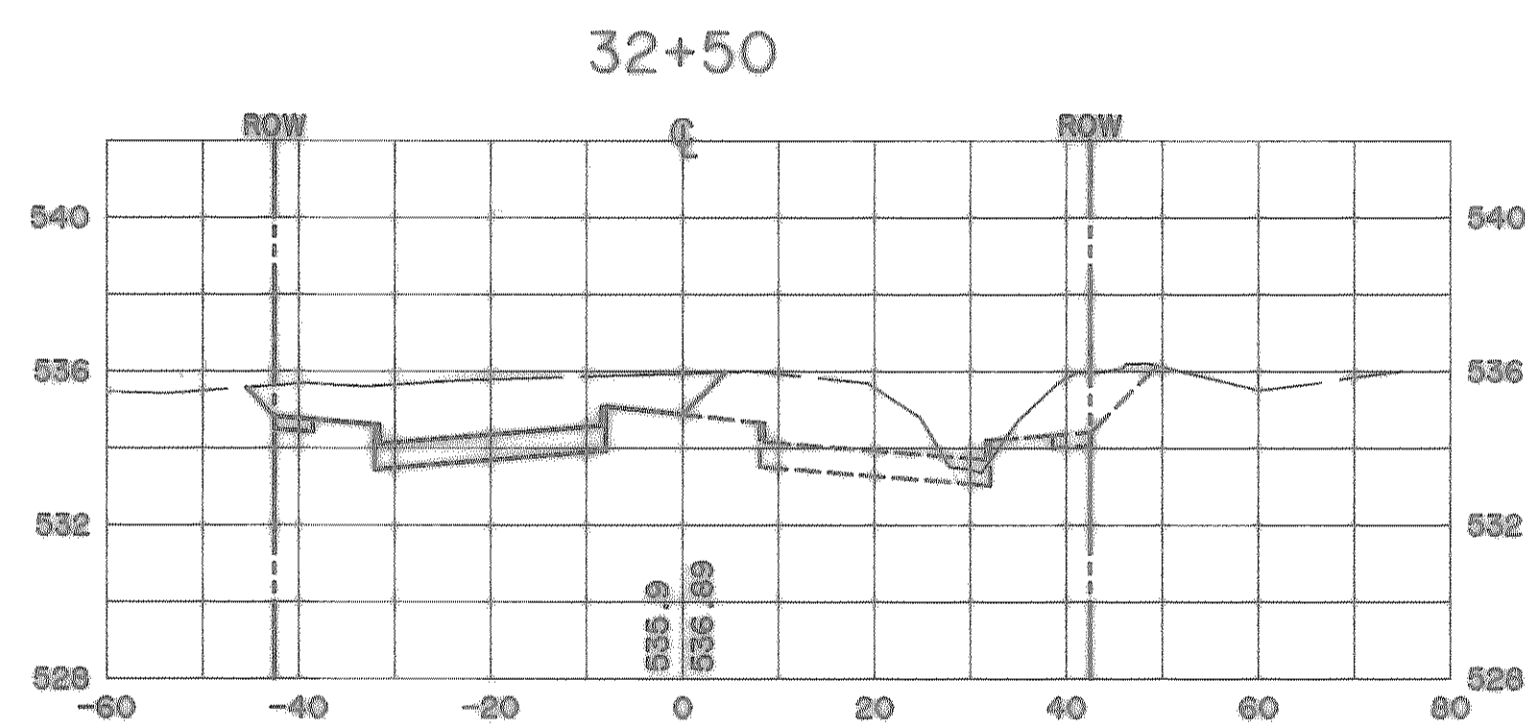
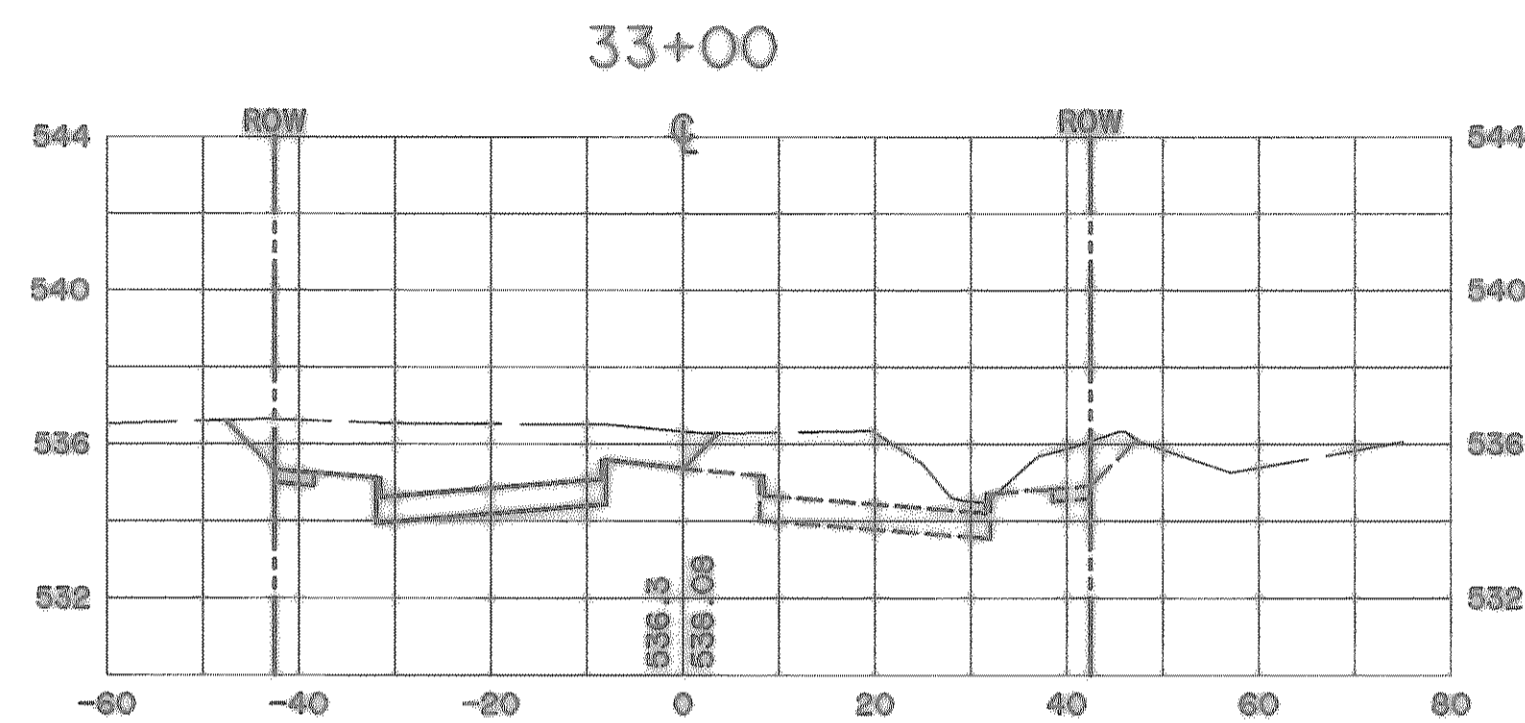
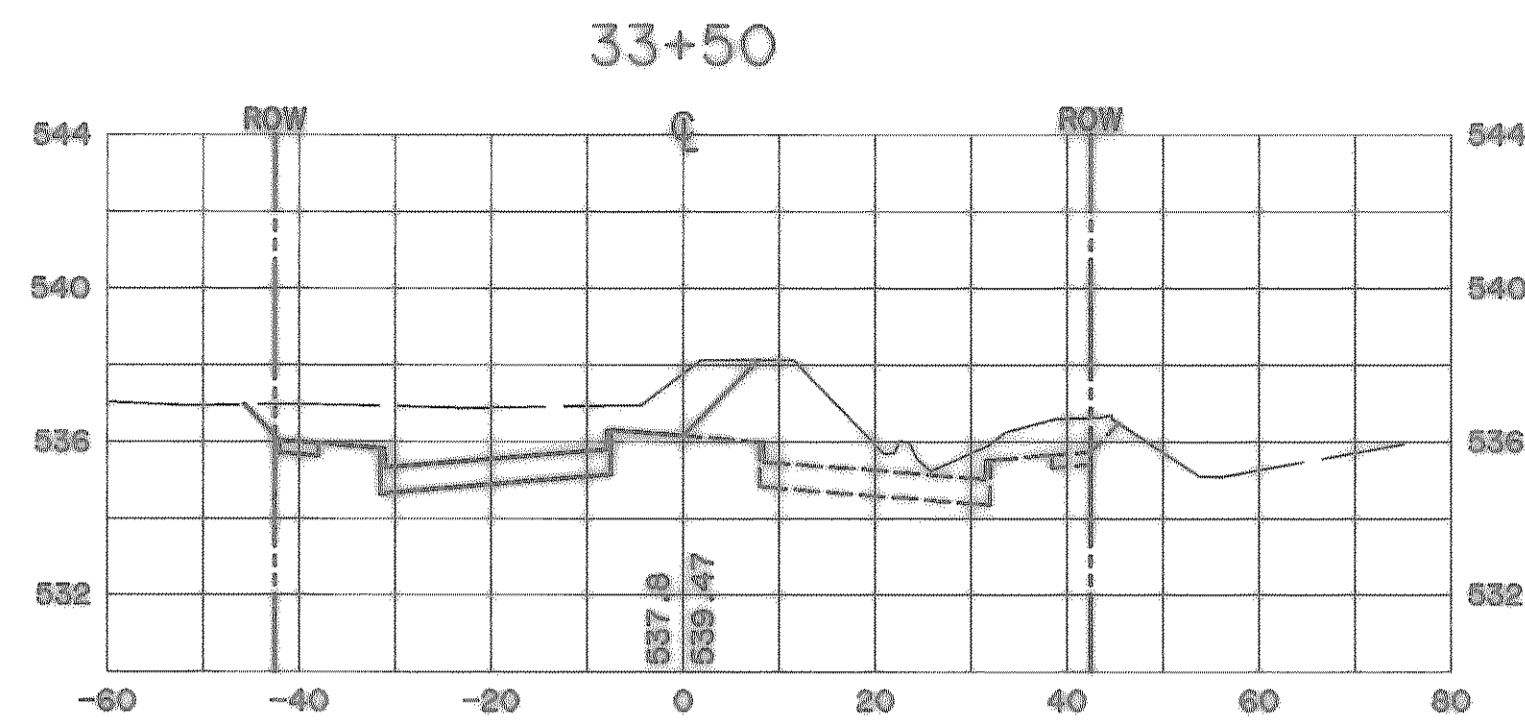
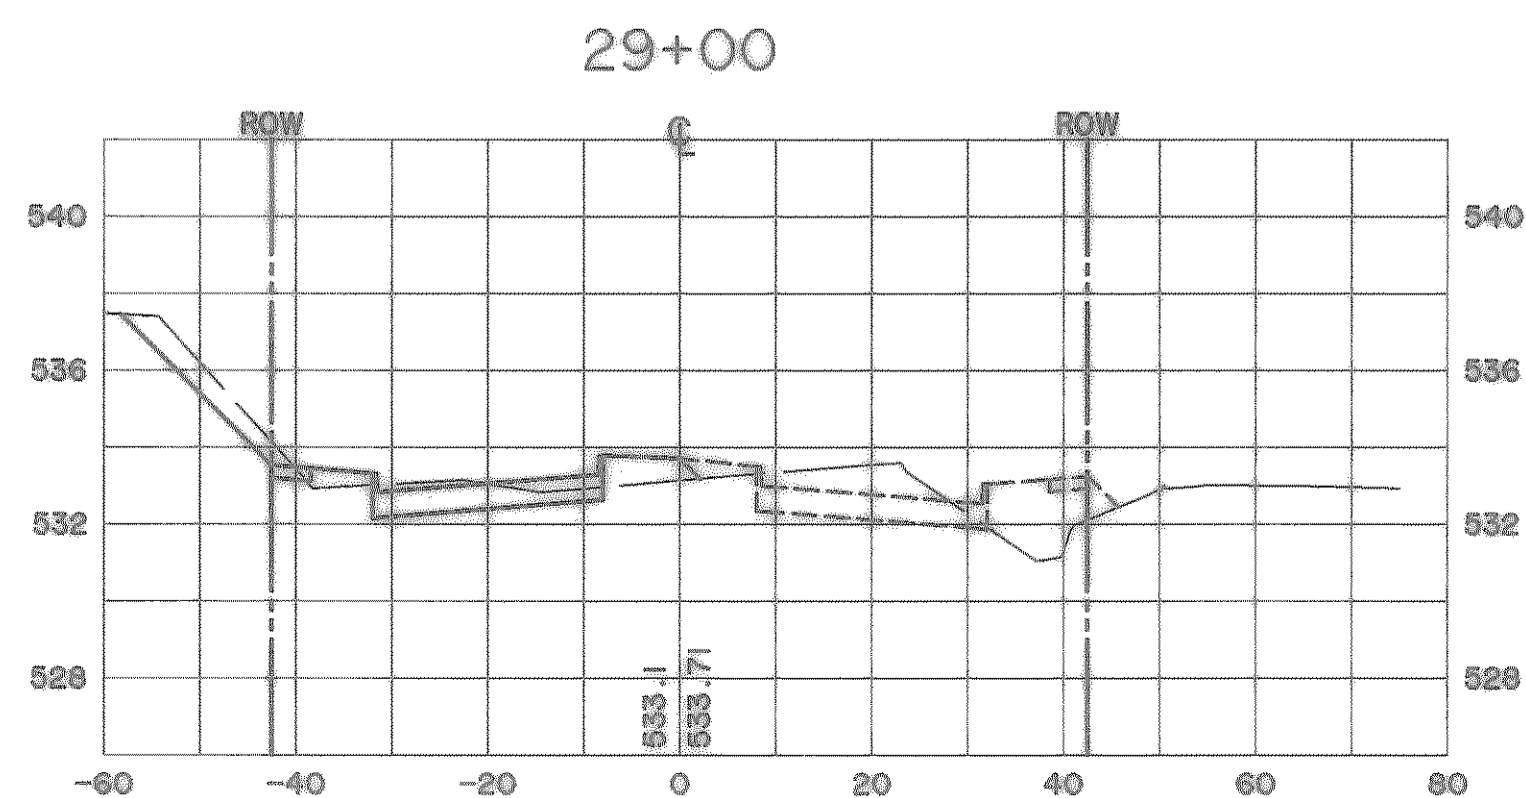
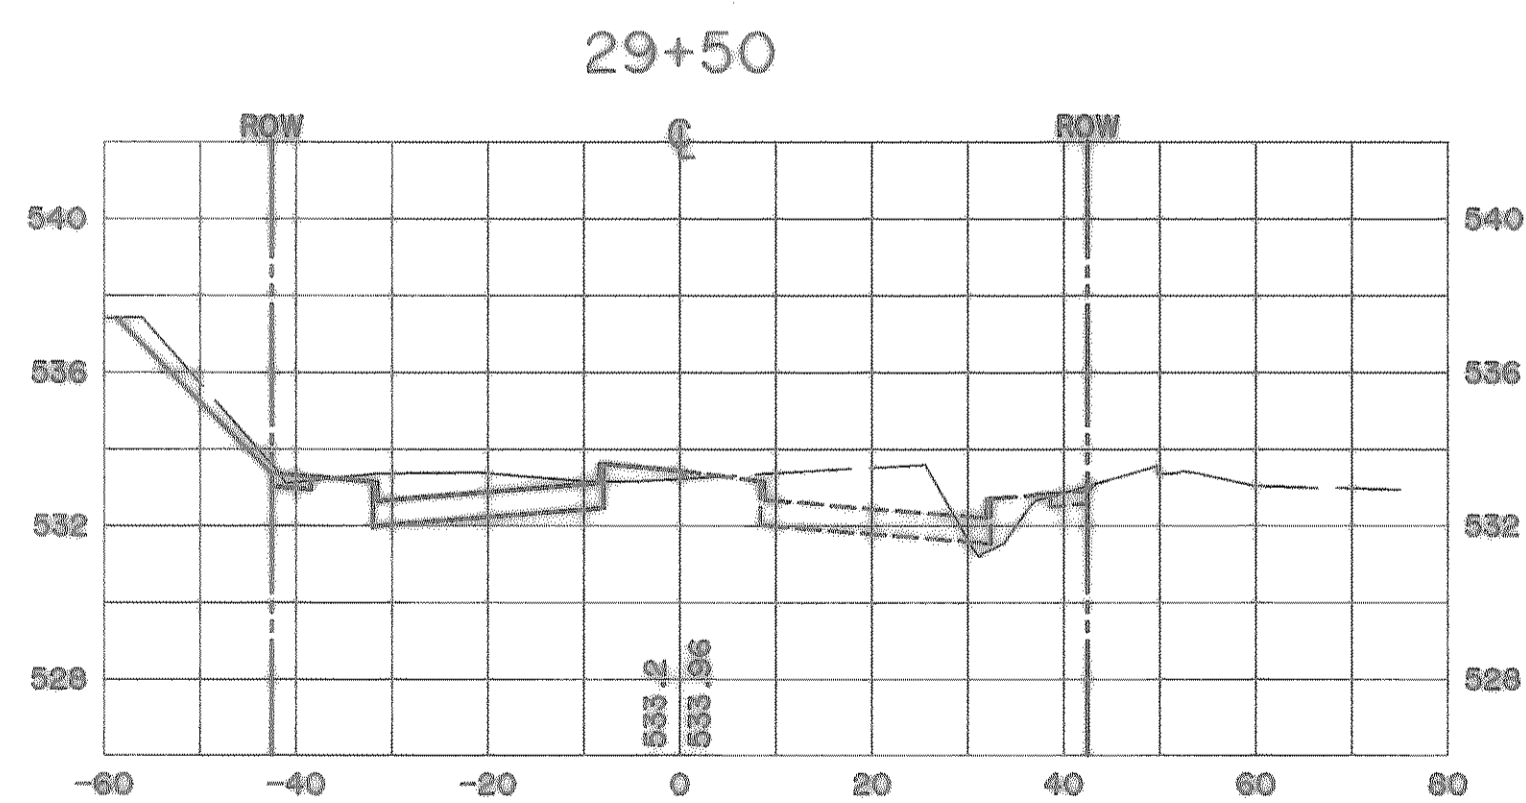
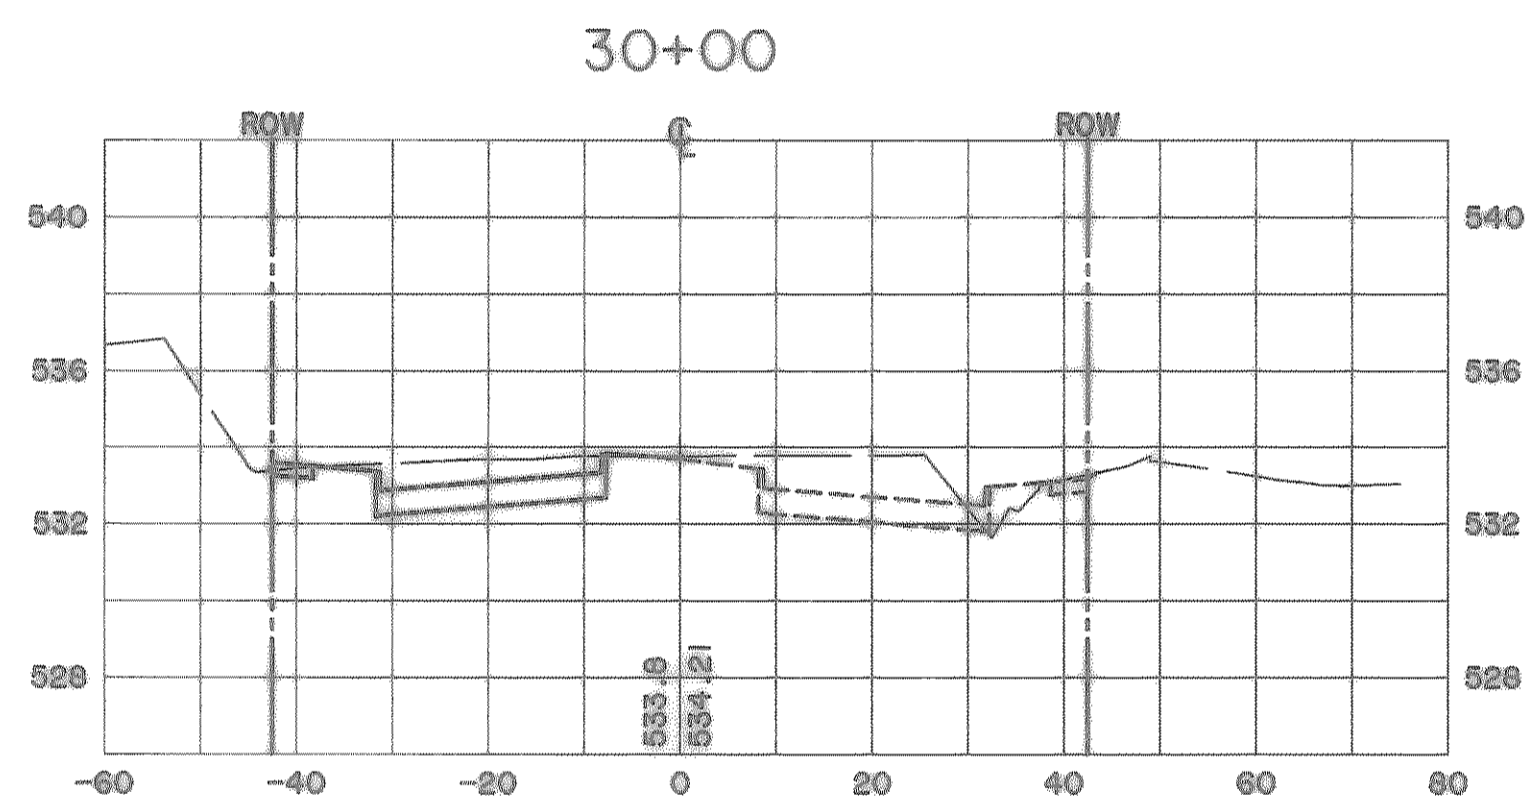
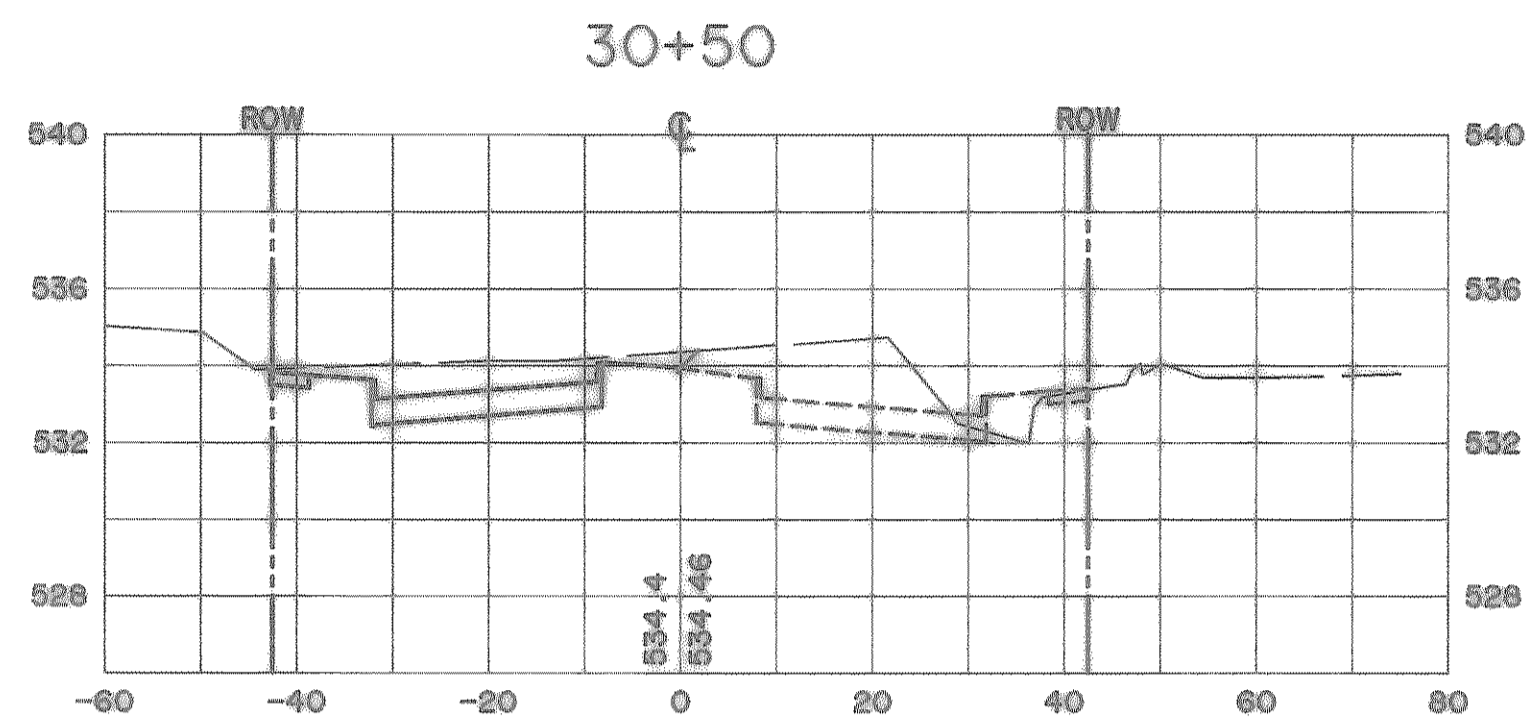


TIME: 0:57 FILE: Cross6.dwg

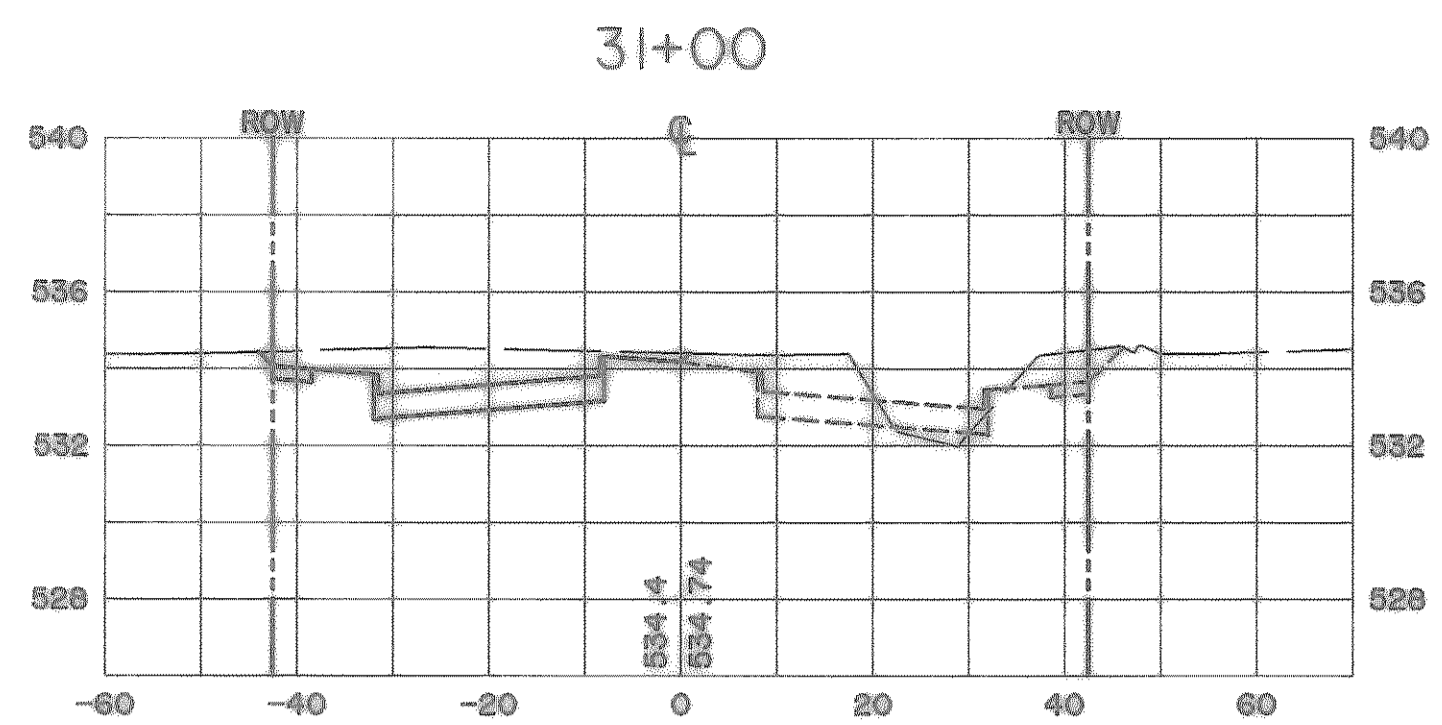


PREPARED BY:
VIA WIER & ASSOCIATES, INC.
 ENGINEERS SURVEYORS & LAND PLANNERS
 430 BELTWAY PLACE SUITE 130 ARLINGTON, TEXAS 76010 METRO (817)467-7700
 418 AMAR CENTER BLD. SUITE 200 FORT WORTH, TEXAS 76105 METRO (817)335-0457

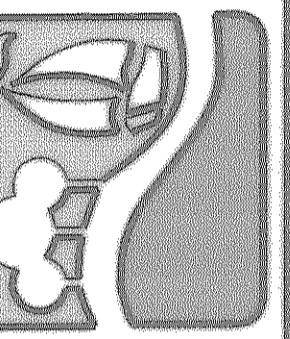

**RALPH M. HALL PARKWAY
 CITY OF ROCKWALL
 ROCKWALL COUNTY, TEXAS**

**PAVING
 CROSS SECTIONS
 STA 29+00 TO STA 35+50**

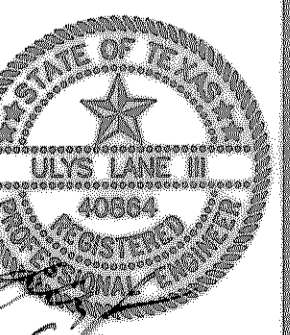

65072
 COPYRIGHT ©
 WIER & ASSOCIATES, INC.
 LAST SHEET EDIT
 DATE: 06-25-99
 WAR 97057

**SHEET NO.
 45**

**"RECORD PLANS"
 06-25-99**