
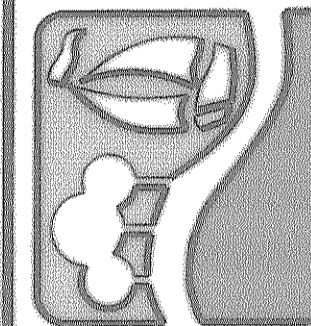
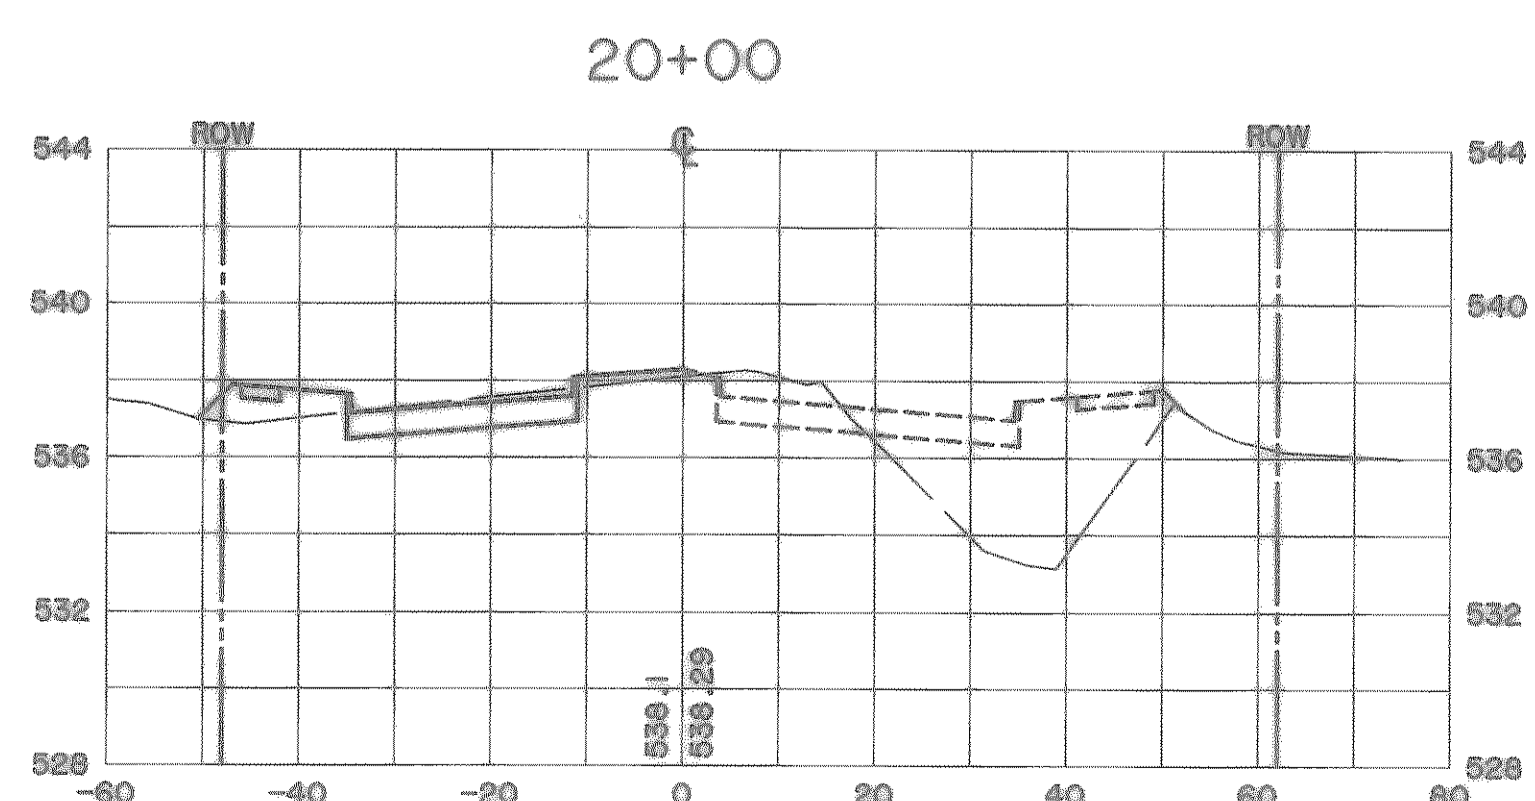
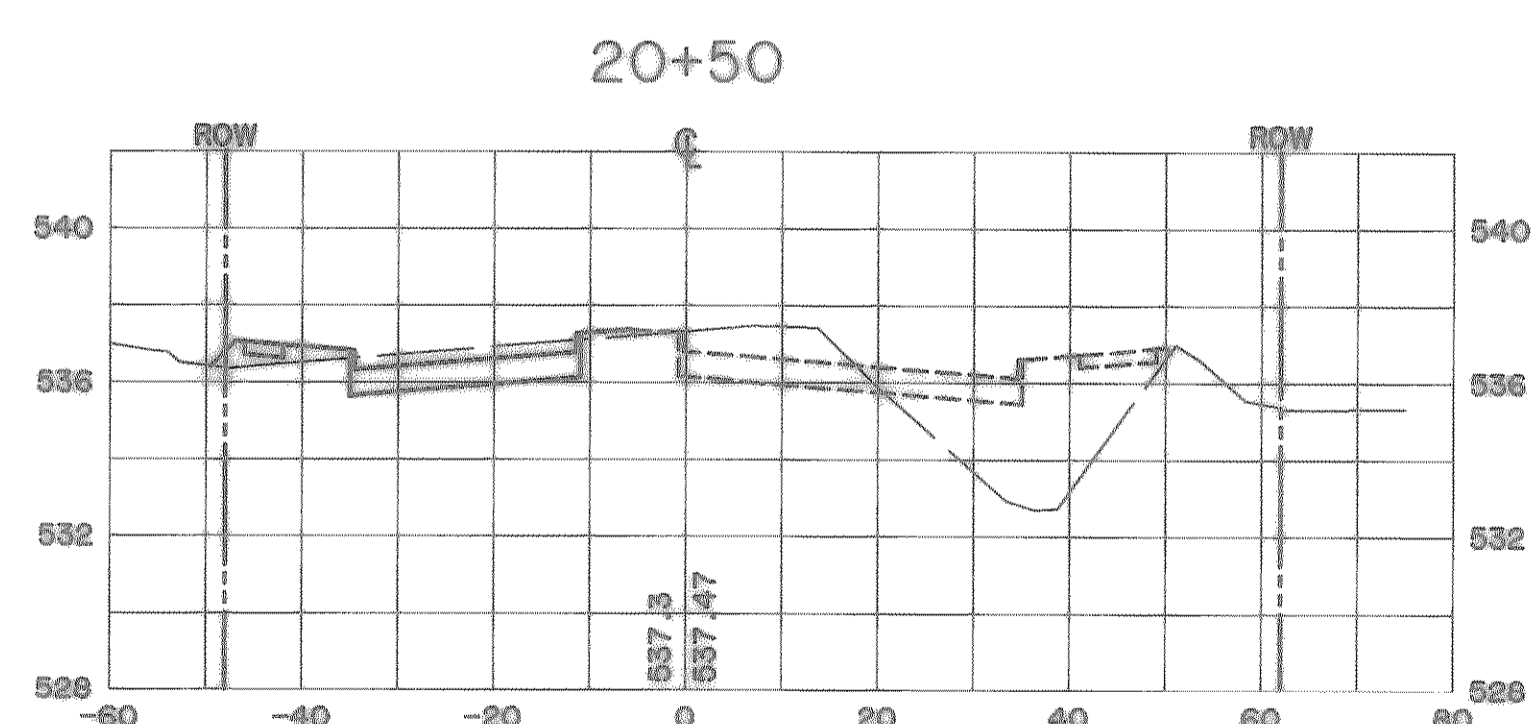
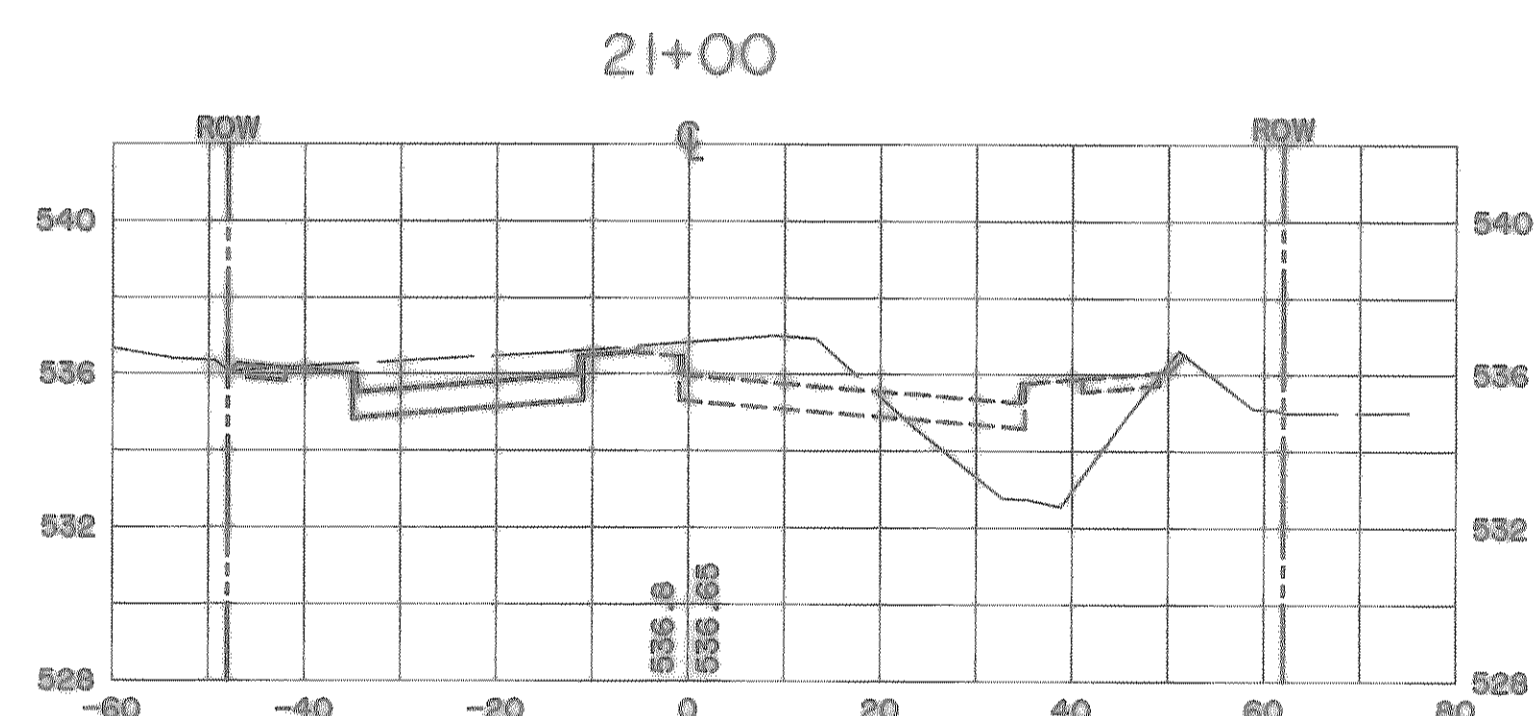
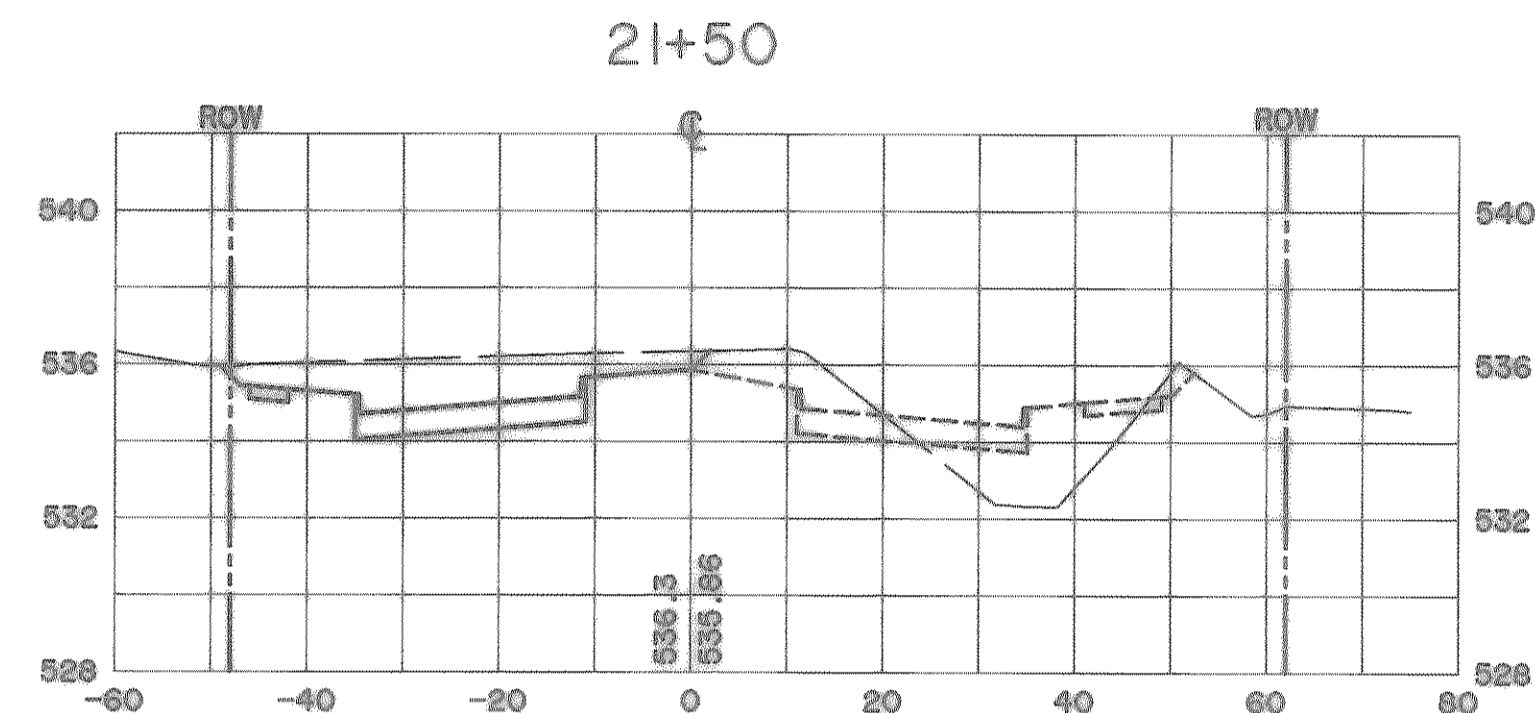
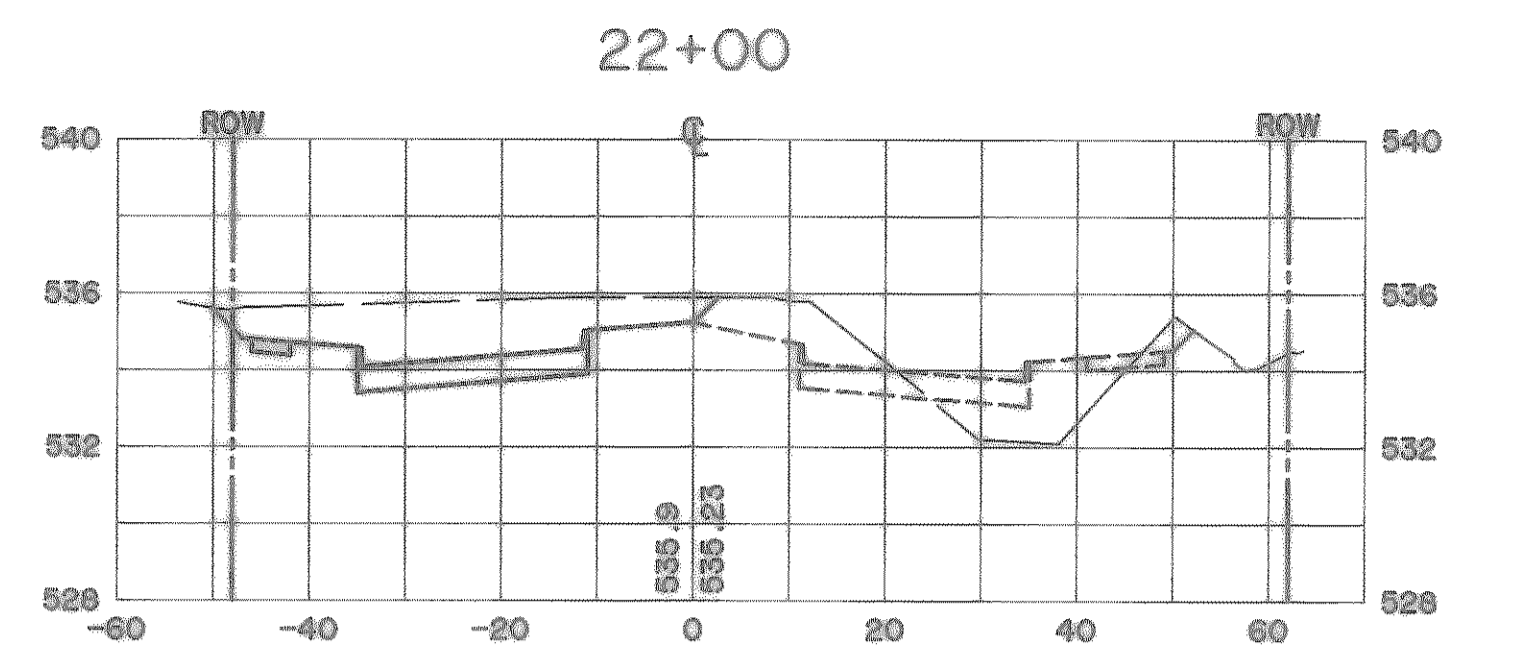
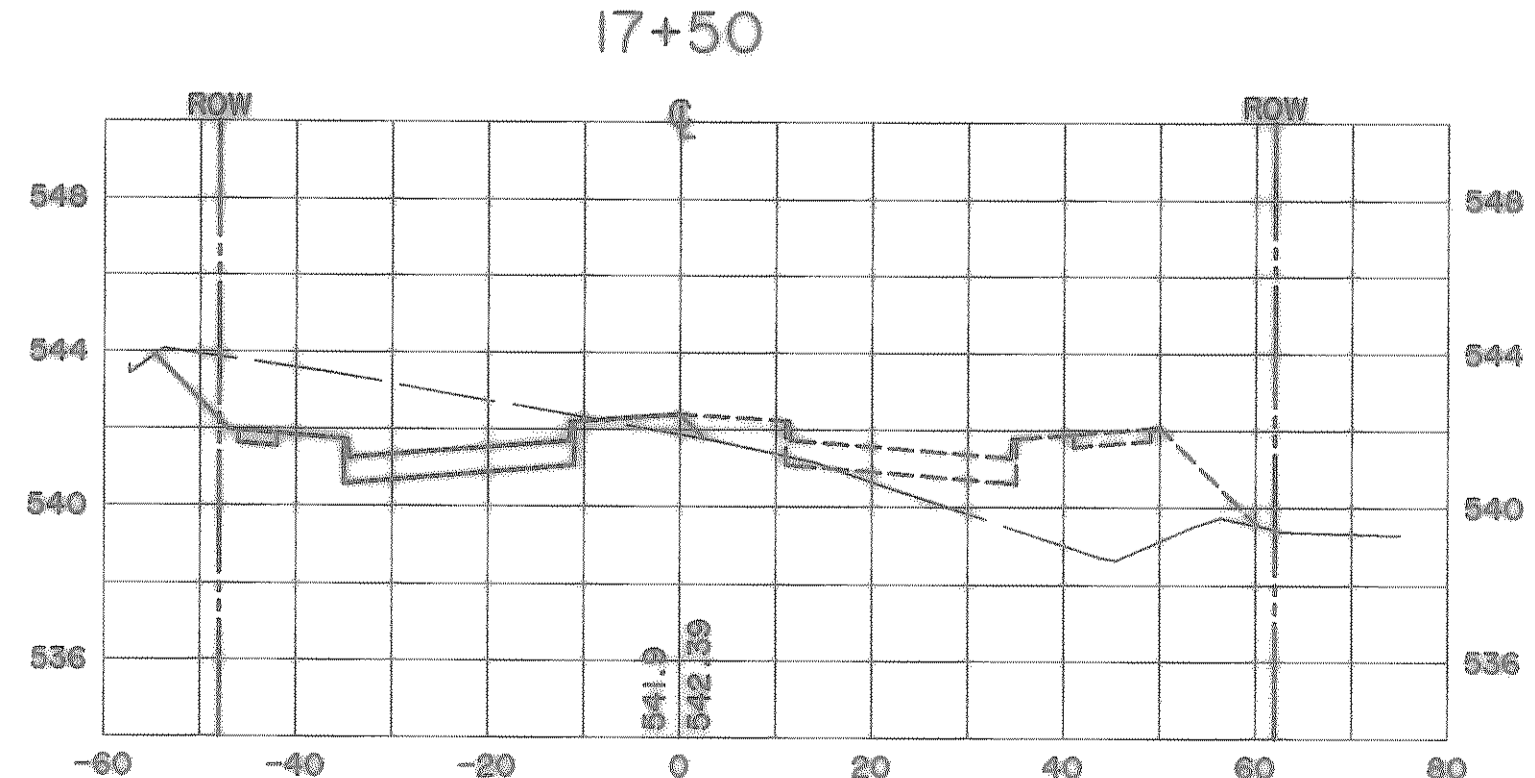
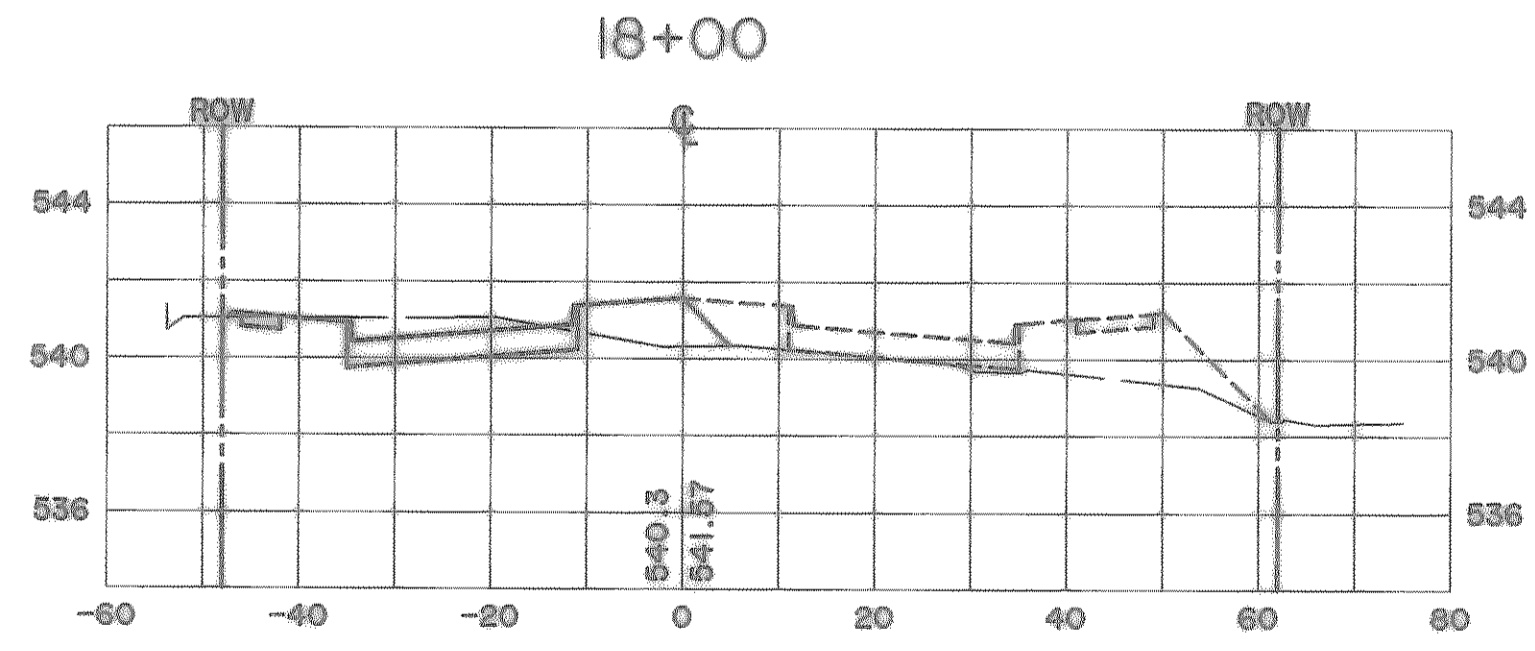
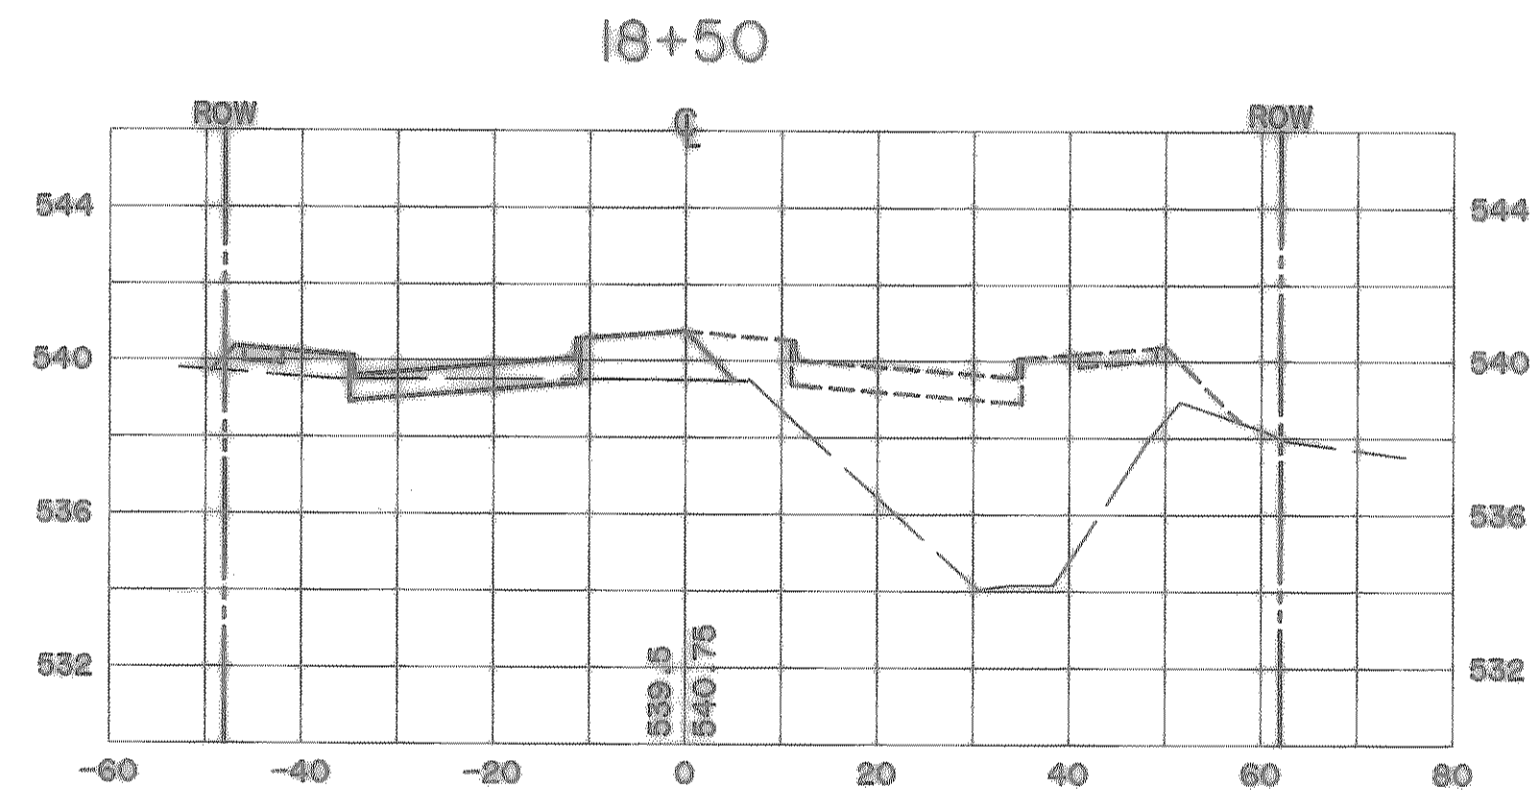
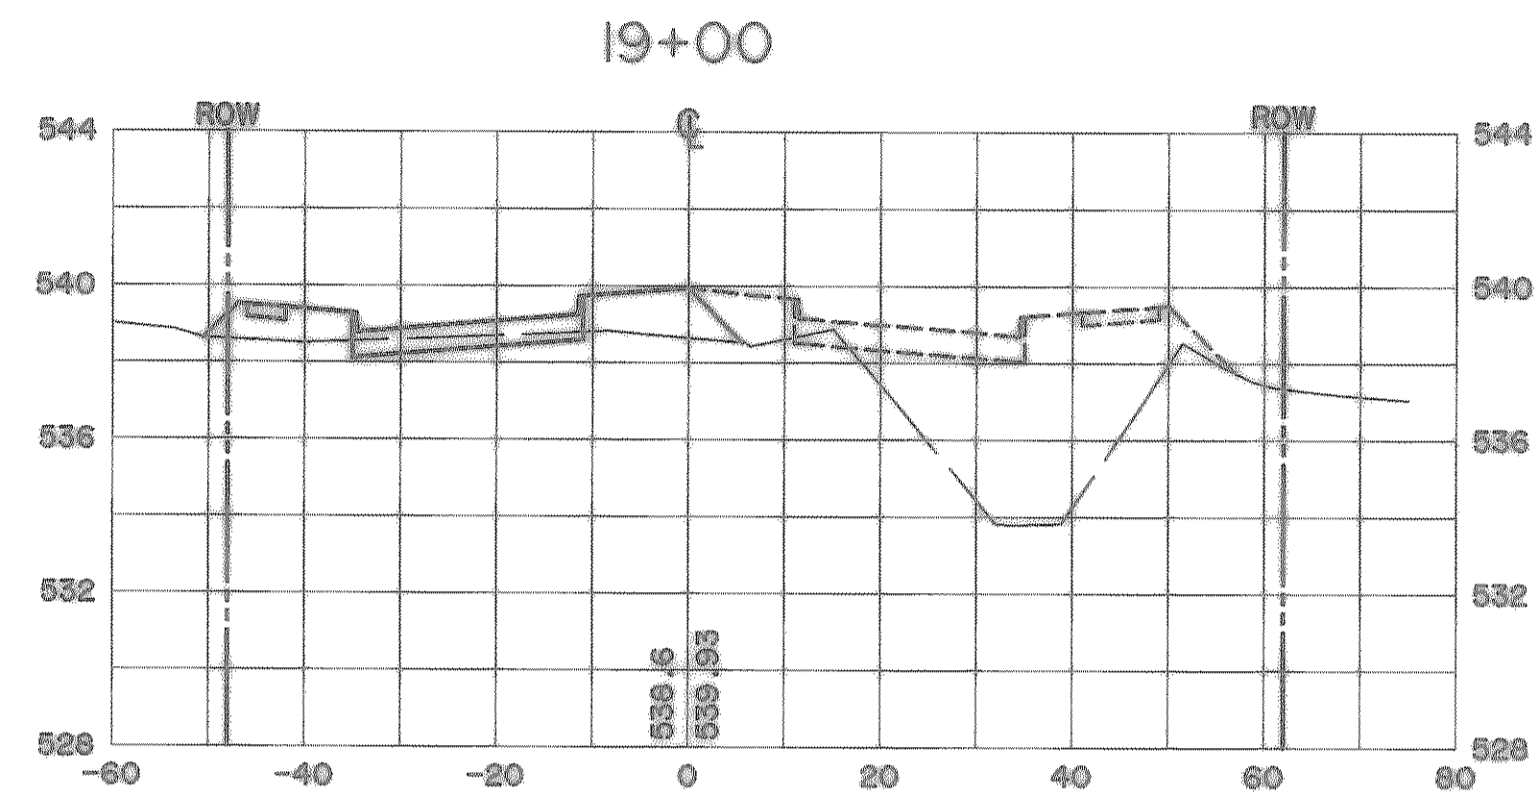
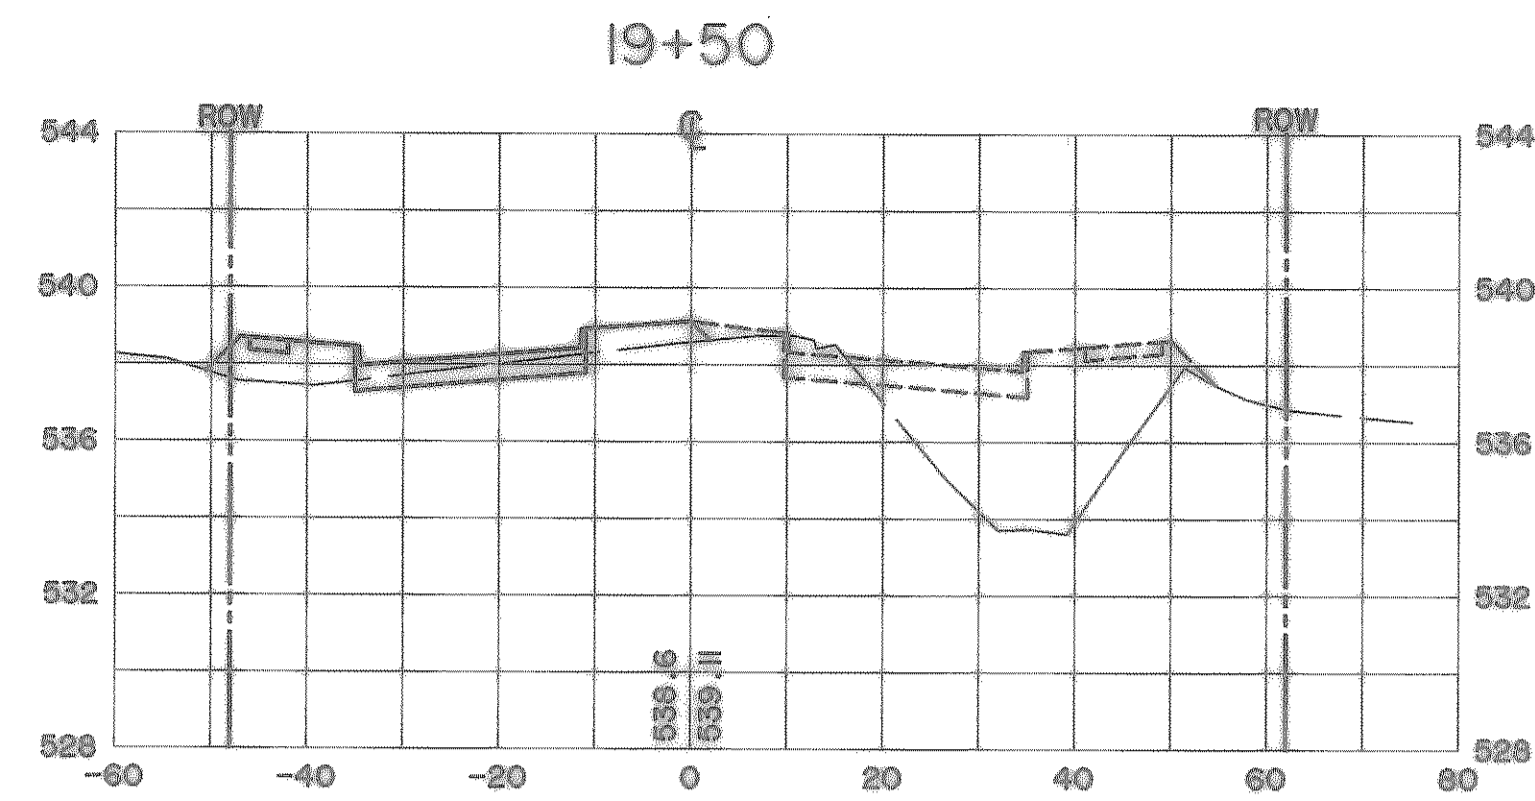
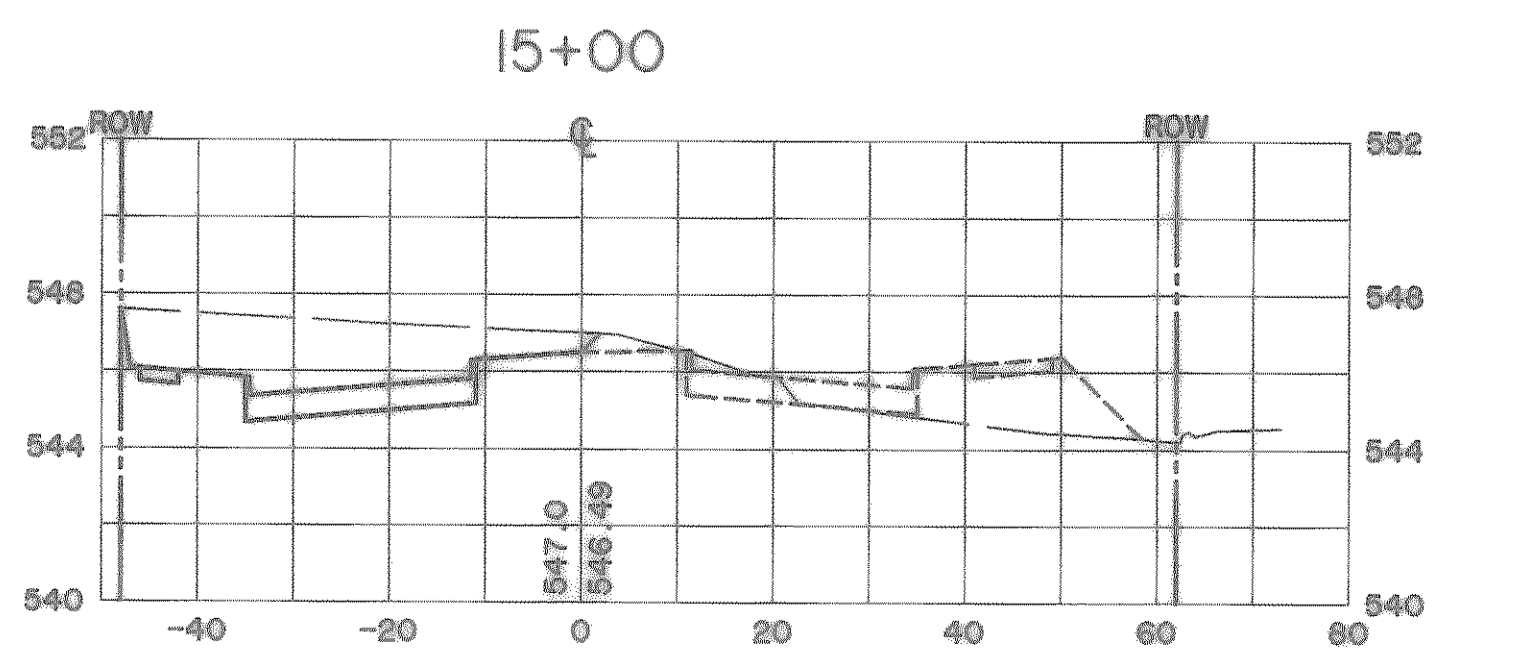
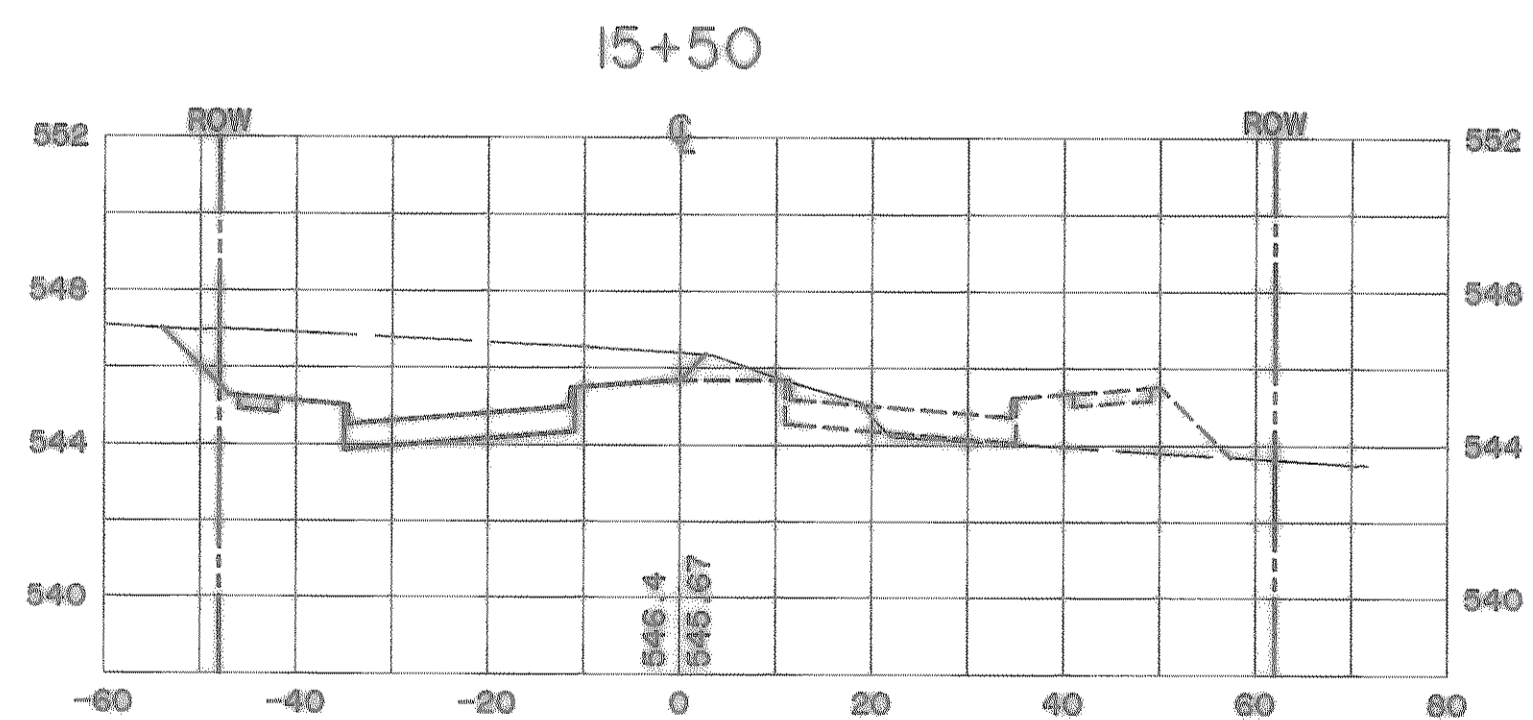
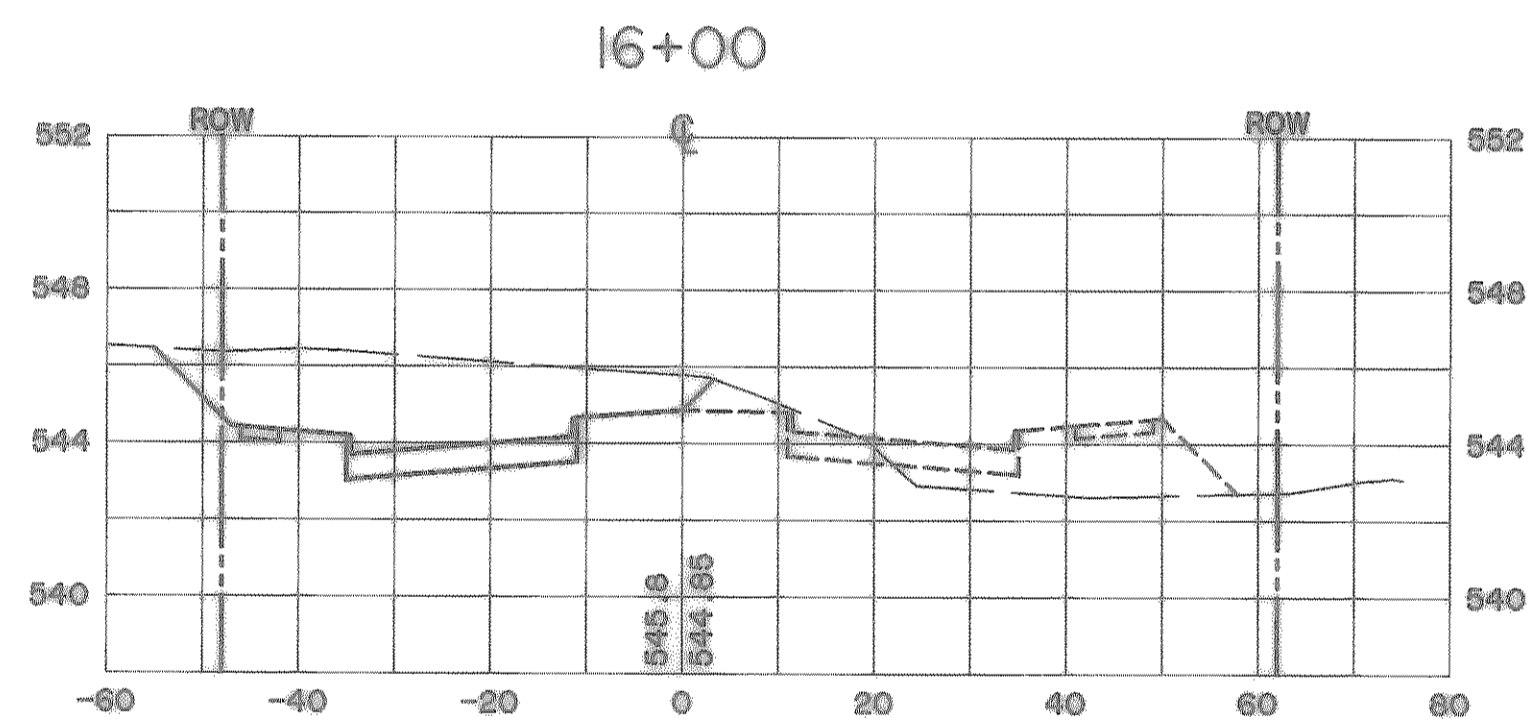
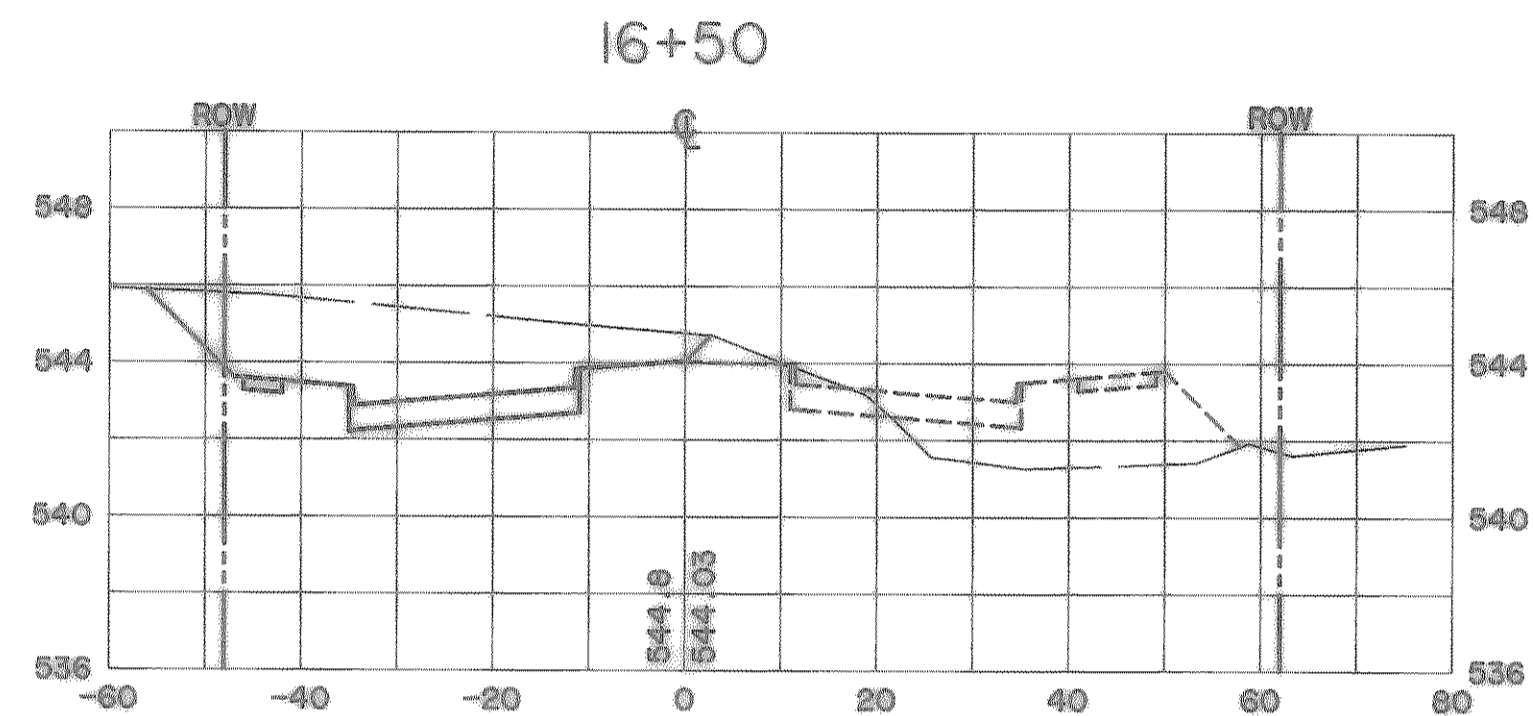



TIME: 11:09 FILE: CROSS4.dwg

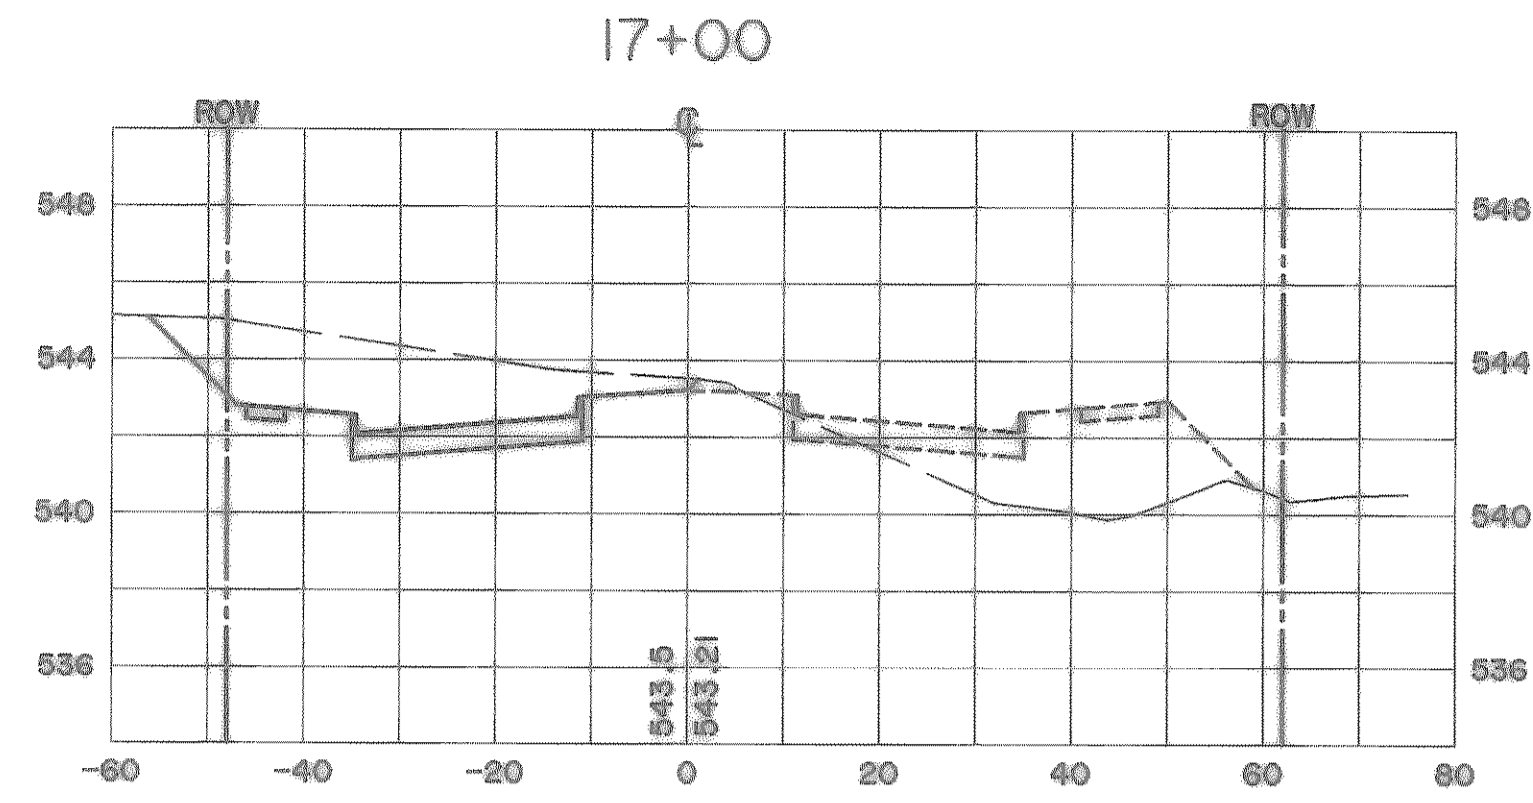

PREPARED BY:  
**VIA WIER & ASSOCIATES, INC.**  
 ENGINEERS SURVEYORS LAND PLANNERS  
 4300 BELLEVUE PLACE SUITE 130 ADDICKS, TEXAS 76018 METRO (817) 467-7700  
 4100 AMH CENTER BLD. SUITE 200 FORT WORTH, TEXAS 76165 METRO (817) 255-9457

**RALPH M. HALL PARKWAY**  
**CITY OF ROCKWALL**  
**ROCKWALL COUNTY, TEXAS**

**PAVING**  
**CROSS SECTIONS**  
**STA 15+00 TO STA 22+00**

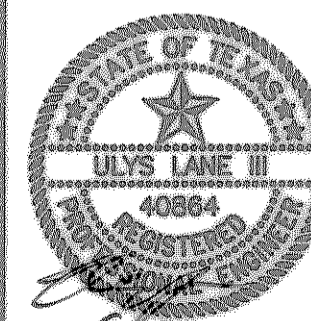

COPYRIGHT ©  
 WIER & ASSOCIATES, INC.  
 LAST SHEET EDIT  
 DATE: 06-25-99  
 WAA: 57057  
**SHEET NO.**  
**43**

**"RECORD PLANS"**  
**06-25-99**