
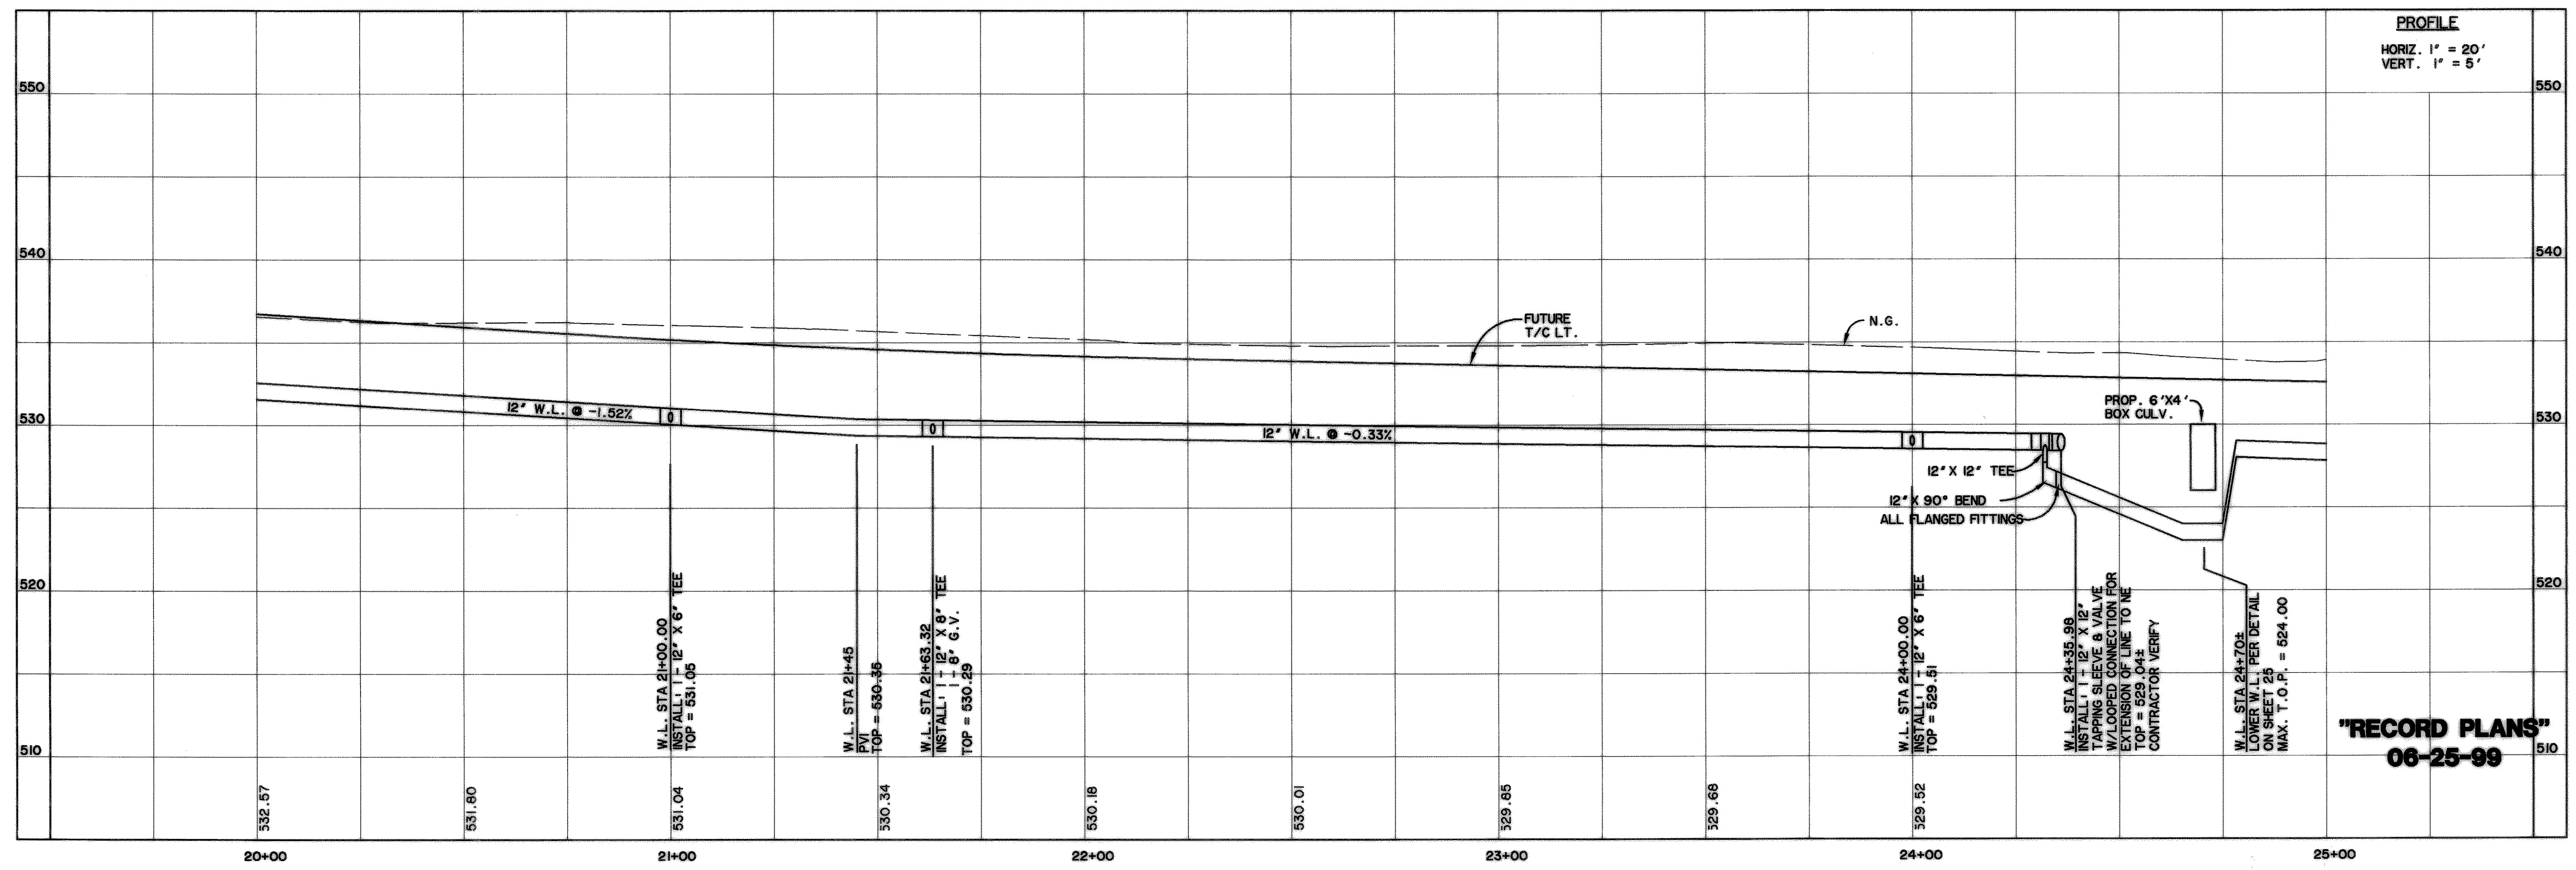


NOTE: USE FLANGED 6" FITTINGS ON FIRE HYDRANT TEES & BENDS.


12" WATER LINE

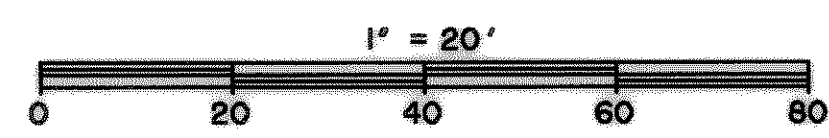

"RECORD PLANS"
06-25-99

TIME: 8:32 FILE: WATERS

PREPARED BY:
WIER & ASSOCIATES, INC.
ENGINEERS SURVEYORS LAND PLANNERS
4300 BELWAY PLACE SUITE 130 ARLINGTON, TEXAS 76018 METRO (817)467-7700
4108 AMON CENTER BLVD. SUITE 200 FORT WORTH, TEXAS 76155 METRO (817)355-9477

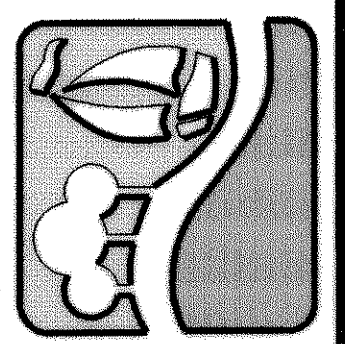

RALPH HALL PARKWAY
CITY OF ROCKWALL
ROCKWALL COUNTY, TEXAS

12" WATER LINE
PLAN & PROFILE
STA 20+00 TO 25+00



COPYRIGHT ©
WIER & ASSOCIATES, INC.
LAST SHEET EDIT
DATE: 06-18-99
WAR 3705
SHEET NO.
29