


CITY OF ROCKWALL, TEXAS

SHEET INDEX


CONSTRUCTION PLANS FOR

PAVING, DRAINAGE AND WATER IMPROVEMENTS

RALPH HALL PARKWAY PHASE 2A HORIZON ROAD TO MIMS ROAD

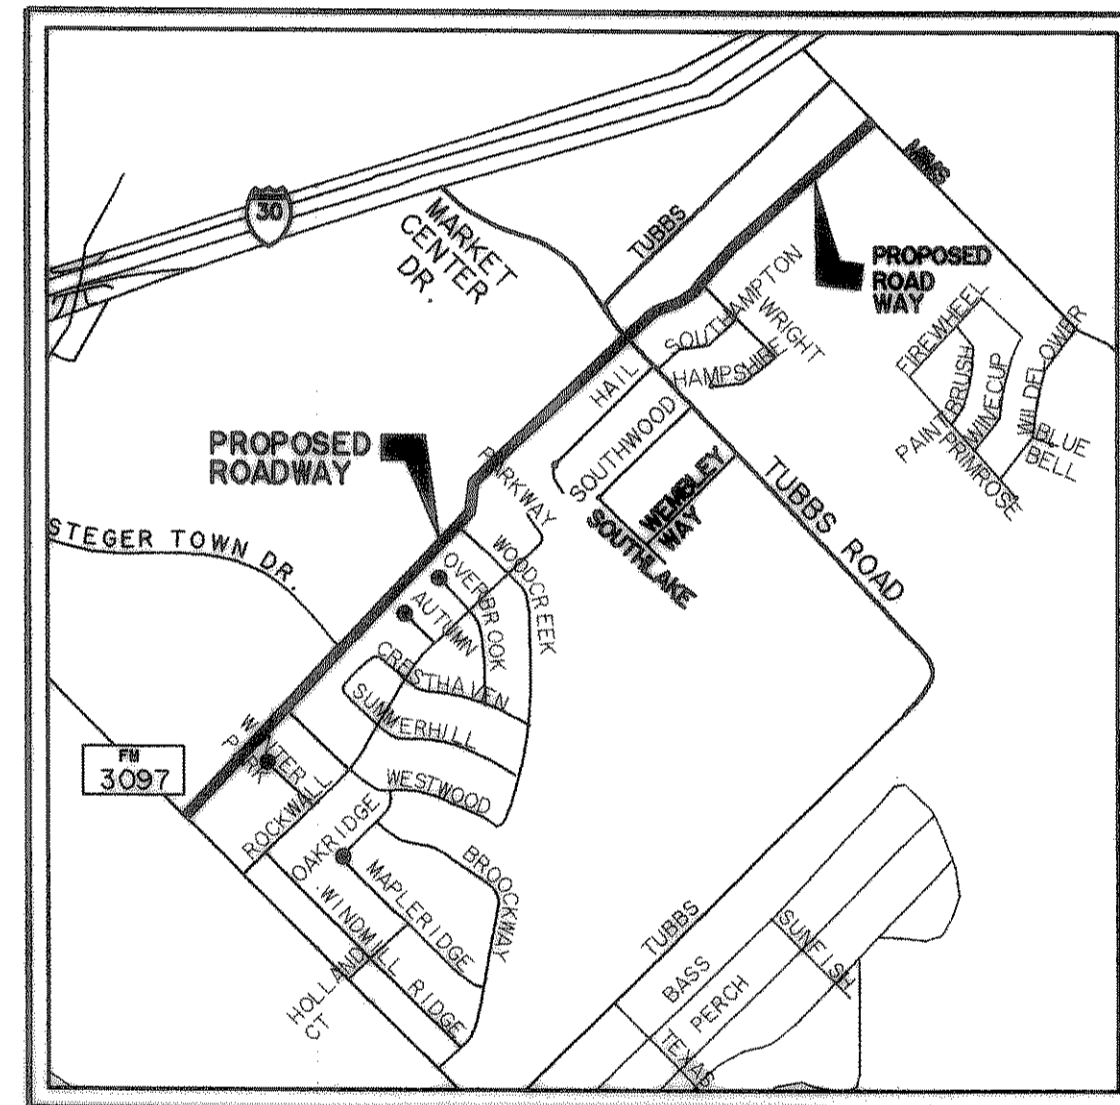

VICINITY MAP

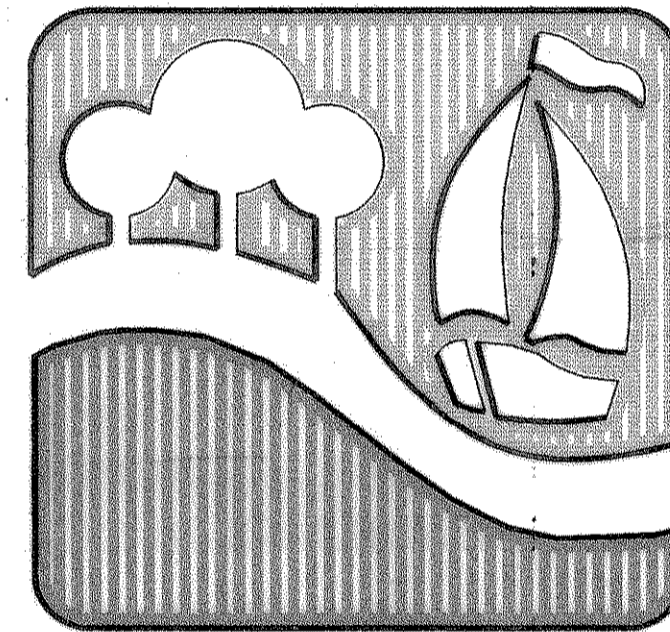

"THE NEW HORIZON"

SCOTT SELF - MAYOR

COUNCILMEMBERS

BILLY MORRIS - MAYOR PRO-TEM

BILL CECIL

RON COLESON

JOHN KING


SAM BUFFINGTON

TERRY RAULSTON

JULIE COUCH - City Manager

PREPARED BY:
WIA WIER & ASSOCIATES, INC.
ENGINEERS SURVEYORS LAND PLANNERS
4300 BELTWAY PLACE SUITE 130 ARLINGTON, TEXAS 76018 METRO (817)467-7700
4108 AMON CARTER BLVD. SUITE 200 FORT WORTH, TEXAS 76155 METRO (817)355-9437

RECORD PLANS
1-15-02

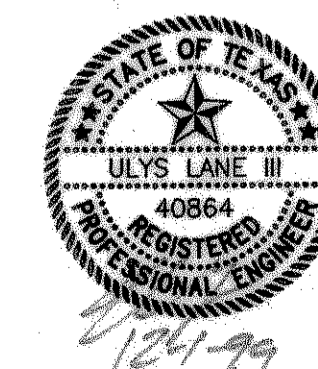

1. GENERAL COVER SHEET
2. TYPICAL SECTIONS STA 0+00 TO 35+75
3. TYPICAL SECTIONS STA 35+75 TO 55+30
- 3A. MIMS ROAD TYPICAL SECTIONS
4. GENERAL NOTES & MISCELLANEOUS DETAILS
- 5A. SHEET QUANTITIES
- 5B. SHEET QUANTITIES
- PAVING PLANS
6. RALPH HALL PARKWAY PAVING PLAN & PROFILE STA 0+00 TO 5+00
7. RALPH HALL PARKWAY PAVING PLAN & PROFILE STA 5+00 TO 10+00
8. RALPH HALL PARKWAY PAVING PLAN & PROFILE STA 10+00 TO 15+00
9. RALPH HALL PARKWAY PAVING PLAN & PROFILE STA 15+00 TO 20+00
10. RALPH HALL PARKWAY PAVING PLAN & PROFILE STA 20+00 TO 25+00
11. RALPH HALL PARKWAY PAVING PLAN & PROFILE STA 25+00 TO 30+00
12. RALPH HALL PARKWAY PAVING PLAN & PROFILE STA 30+00 TO 35+00
13. RALPH HALL PARKWAY PAVING PLAN & PROFILE STA 35+00 TO 40+00
14. RALPH HALL PARKWAY PAVING PLAN & PROFILE STA 40+00 TO 45+00
15. RALPH HALL PARKWAY PAVING PLAN & PROFILE STA 45+00 TO 50+00
16. RALPH HALL PARKWAY PAVING PLAN & PROFILE STA 50+00 TO 55+00
17. RALPH HALL PARKWAY PAVING PLAN & PROFILE STA 55+00 TO 60+00
- 18A. MIMS ROAD PAVING PLAN & PROFILE STA 0+50 TO 5+45
- 18B. MIMS ROAD PAVING PLAN & PROFILE STA 5+45 TO 7+00
19. MIMS ROAD PAVING PLAN & PROFILE STA 7+00 TO 12+00
- DRAINAGE PLANS
20. DRAINAGE AREA MAP SOUTHWEST
21. DRAINAGE AREA MAP NORTHEAST
22. DRAINAGE AREA CALCULATIONS
23. INLET DESIGN CALCULATIONS
24. STORM DRAIN DESIGN CALCULATIONS
25. STORM DRAIN LINE "D" PLAN & PROFILE STA 5+25 TO 8+65
26. STORM DRAIN SYSTEM "G" PLAN & PROFILE STA 0+00 TO 5+00
27. STORM DRAIN SYSTEM "G" PLAN & PROFILE STA 5+00 TO 10+00
28. STORM DRAIN SYSTEM "G" PLAN & PROFILE STA 10+00 TO END
29. STORM DRAIN SYSTEM "K" PLAN & PROFILE STA 0+00 TO 5+50
30. STORM DRAIN SYSTEM "K" PLAN & PROFILE STA 5+50 TO 11+00
31. STORM DRAIN SYSTEM "K" PLAN & PROFILE STA 11+00 TO END
32. STORM DRAIN LATERAL "K-6" PLAN & PROFILE STA 5+00 TO 10+00
33. STORM DRAIN LATERAL "K-6" PLAN & PROFILE STA 10+00 TO END
34. STORM DRAIN LATERAL PROFILES
- WATER LINE PLANS
35. WATER LINE PLAN & PROFILE STA 0+00 TO 5+00
36. WATER LINE PLAN & PROFILE STA 5+00 TO 10+00
37. WATER LINE PLAN & PROFILE STA 10+00 TO 15+00
38. WATER LINE PLAN & PROFILE STA 15+00 TO 20+00
- CONSTRUCTION SEQUENCE PLANS
39. CONSTRUCTION SEQUENCE & EROSION CONTROL PLAN STA 0+00 TO 26+00
40. CONSTRUCTION SEQUENCE & EROSION CONTROL PLAN STA 26+00 TO 52+00
41. CONSTRUCTION SEQUENCE & EROSION CONTROL PLAN STA 52+00 TO 60+00 & MIMS ROAD
42. CONSTRUCTION SEQUENCE NOTES
- STORMWATER POLLUTION PREVENTION
43. STORMWATER POLLUTION PREVENTION PLAN SOUTHWEST
44. STORMWATER POLLUTION PREVENTION PLAN NORTHEAST
45. STORMWATER POLLUTION PREVENTION NOTES
46. STORMWATER POLLUTION PREVENTION DETAILS
47. STORMWATER POLLUTION PREVENTION DETAILS
- PROJECT DETAILS
48. HANDICAP RAMP & SIDEWALK DETAILS
49. STREET SIGN & LANDSCAPE MAINTENANCE RAMP DETAILS
50. STRIPING / PAVEMENT MARKER DETAILS
51. CURB INLET DETAILS
52. STORM DRAIN JUNCTION BOX No. 1, "Y" INLET & "Y" INLET CONVERSION TO JUNCTION BOX DETAILS
53. MIMS ROAD BUTTON LAYOUT, RETAINING WALL AND CHAIN LINK FENCE DETAILS
54. MIMS ROAD STRIPING LAYOUT PLAN
- 55-88. CROSS-SECTIONS