



**ADD ON CURB DETAIL 0+75 TO 3+30**  
N.T.S.

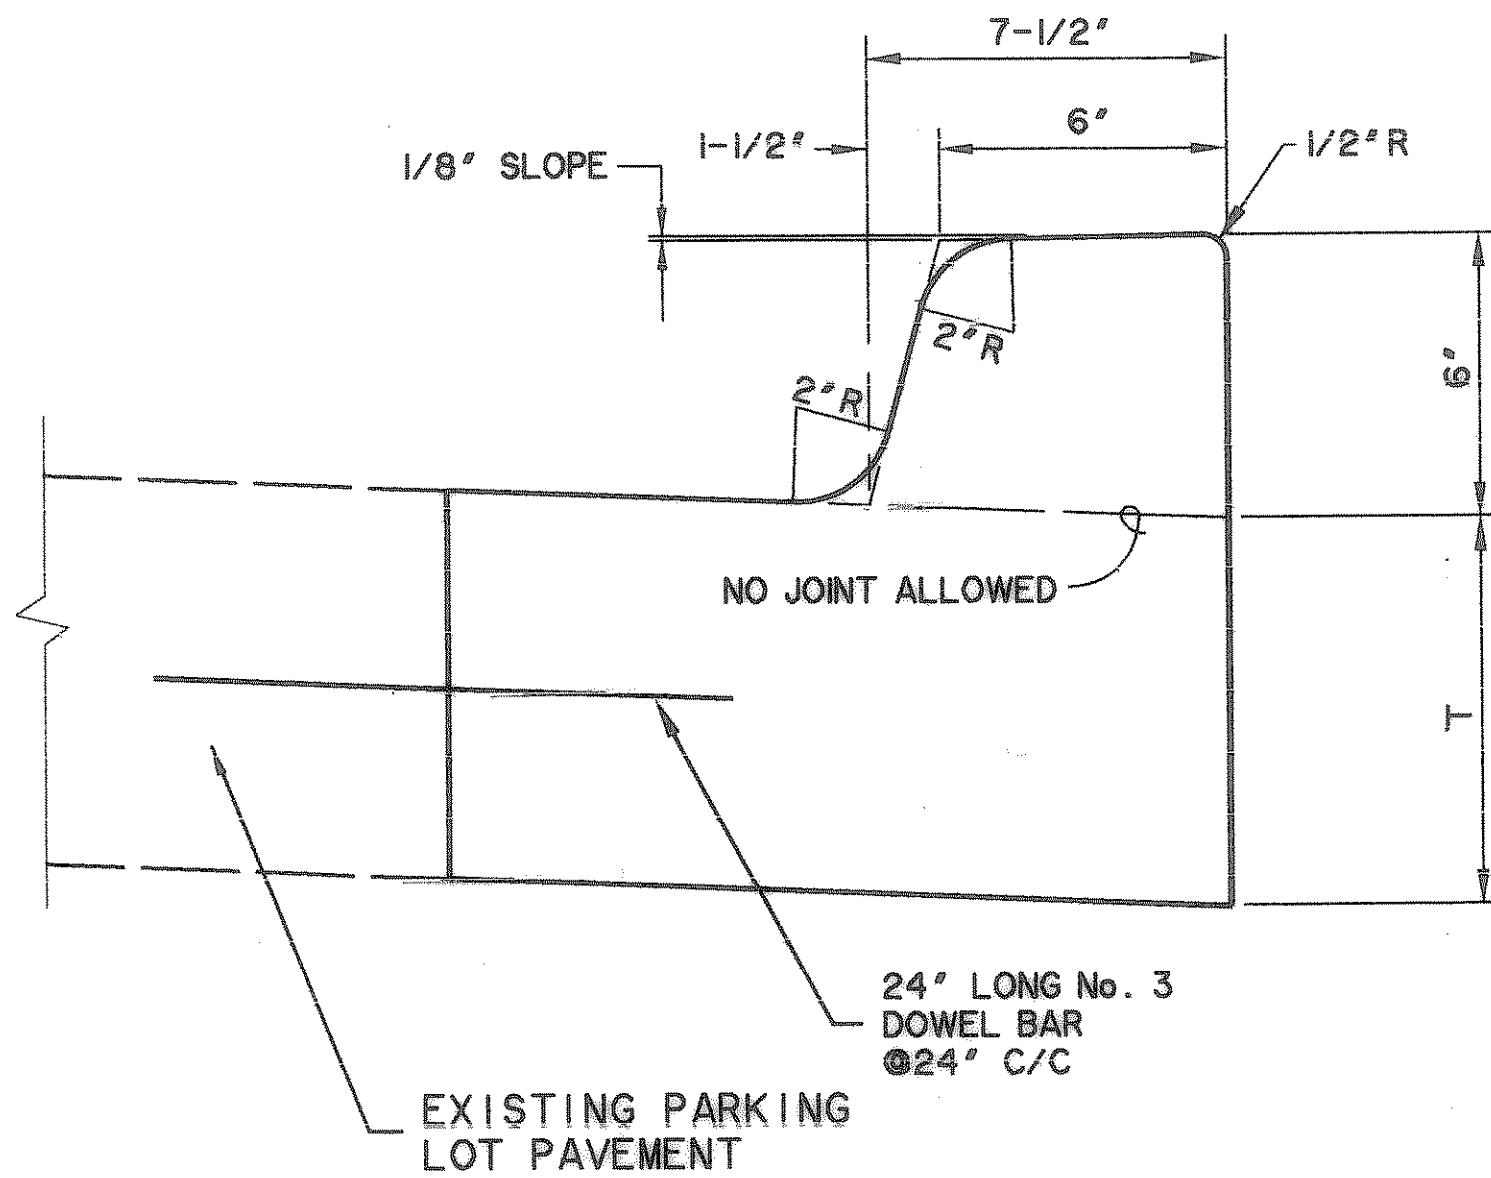


**CURB DETAIL SCHOOL PARKING LOT**  
N.T.S.

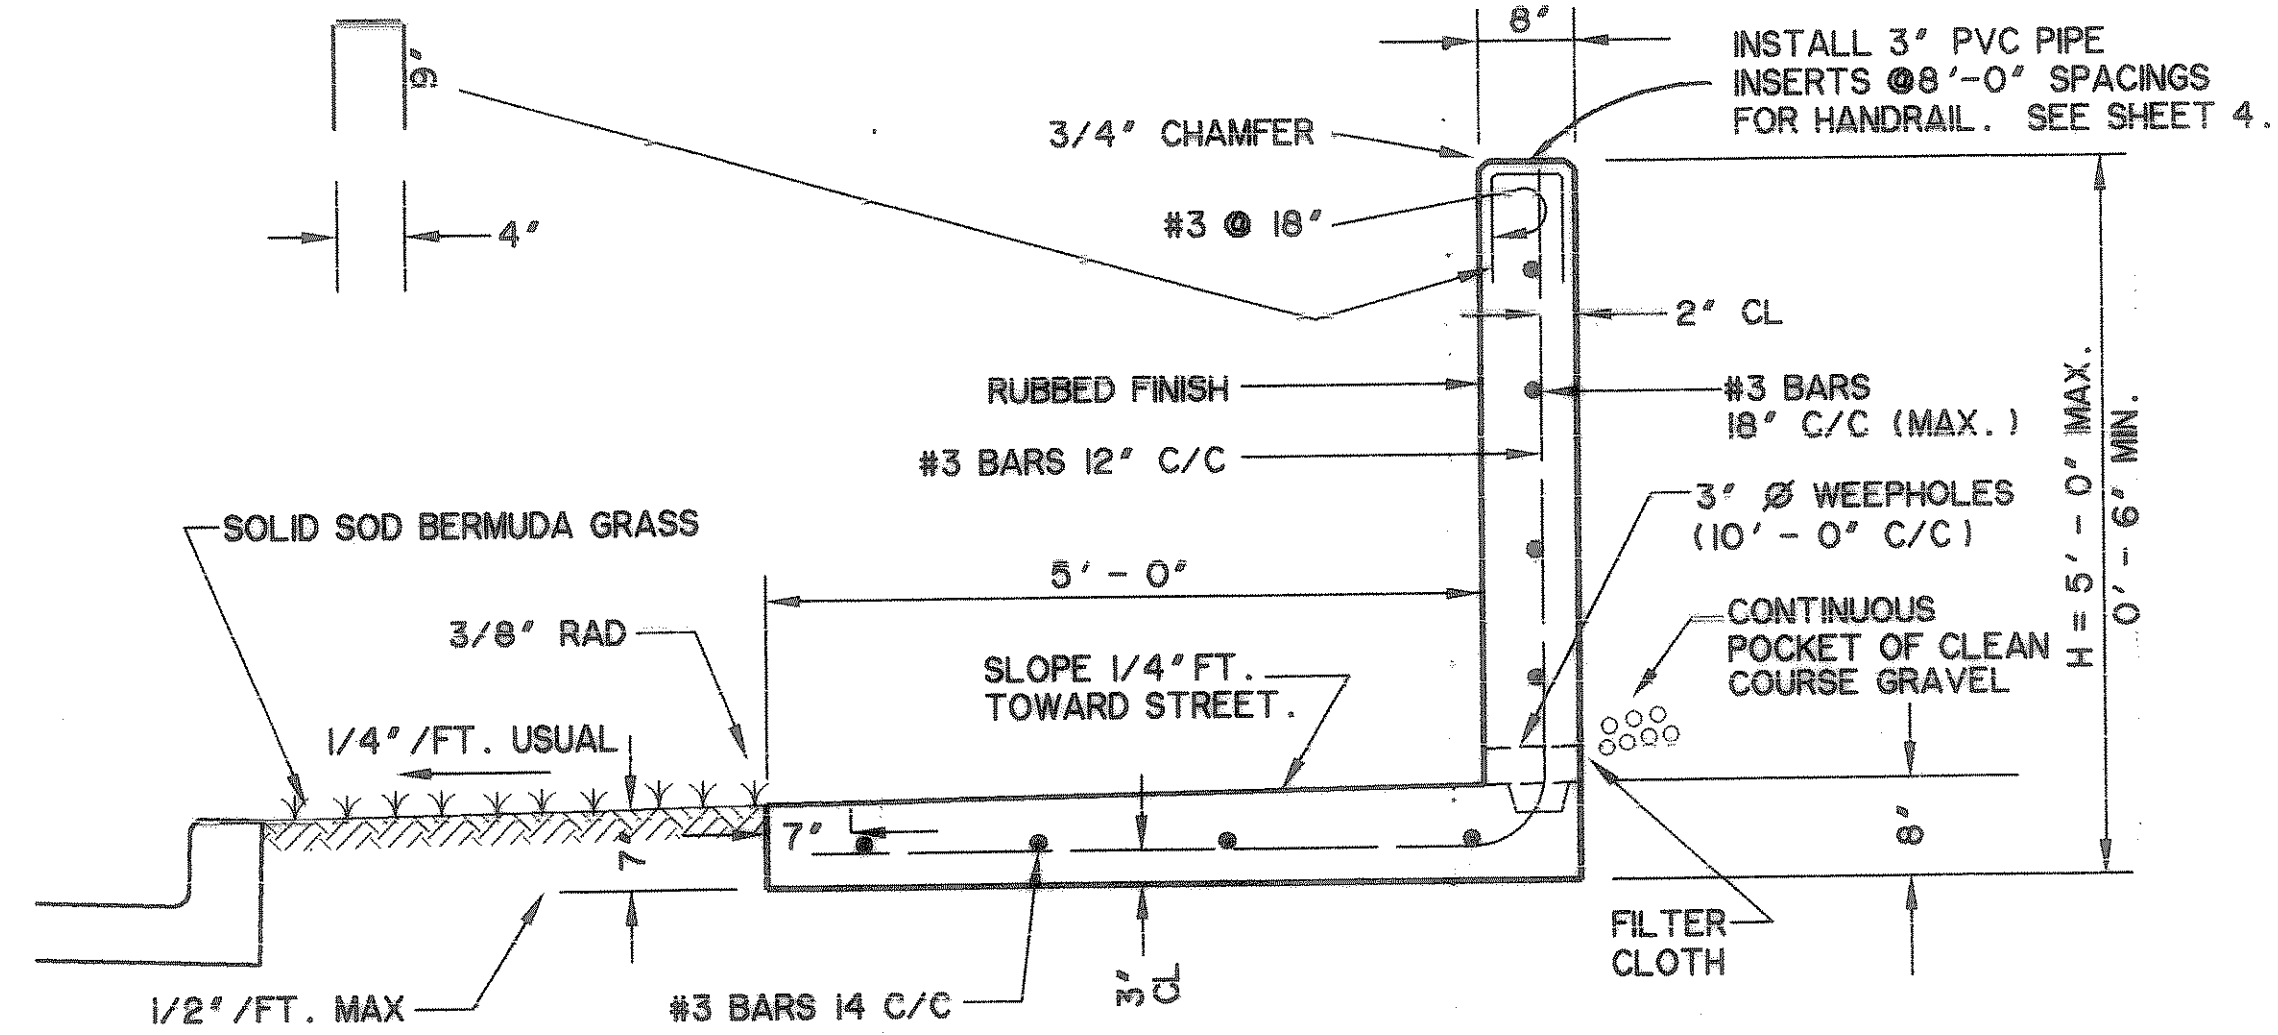


**TYPE 6 RETAINING WALL**

N.T.S.


- GENERAL NOTES:
1. CONCRETE - MINIMUM STRENGTH, 3000 P.S.I. @ 28 DAYS
  2. REINFORCEMENT - ASTM A 36
  3. ALL EXPOSED CONCRETE SHALL HAVE A RUBBED FINISHED SURFACE
  4. SIDEWALKS ADJACENT TO WALLS MUST BE 5' - 0" MIN. WIDTH FROM ALL PORTIONS OF THE WALL.

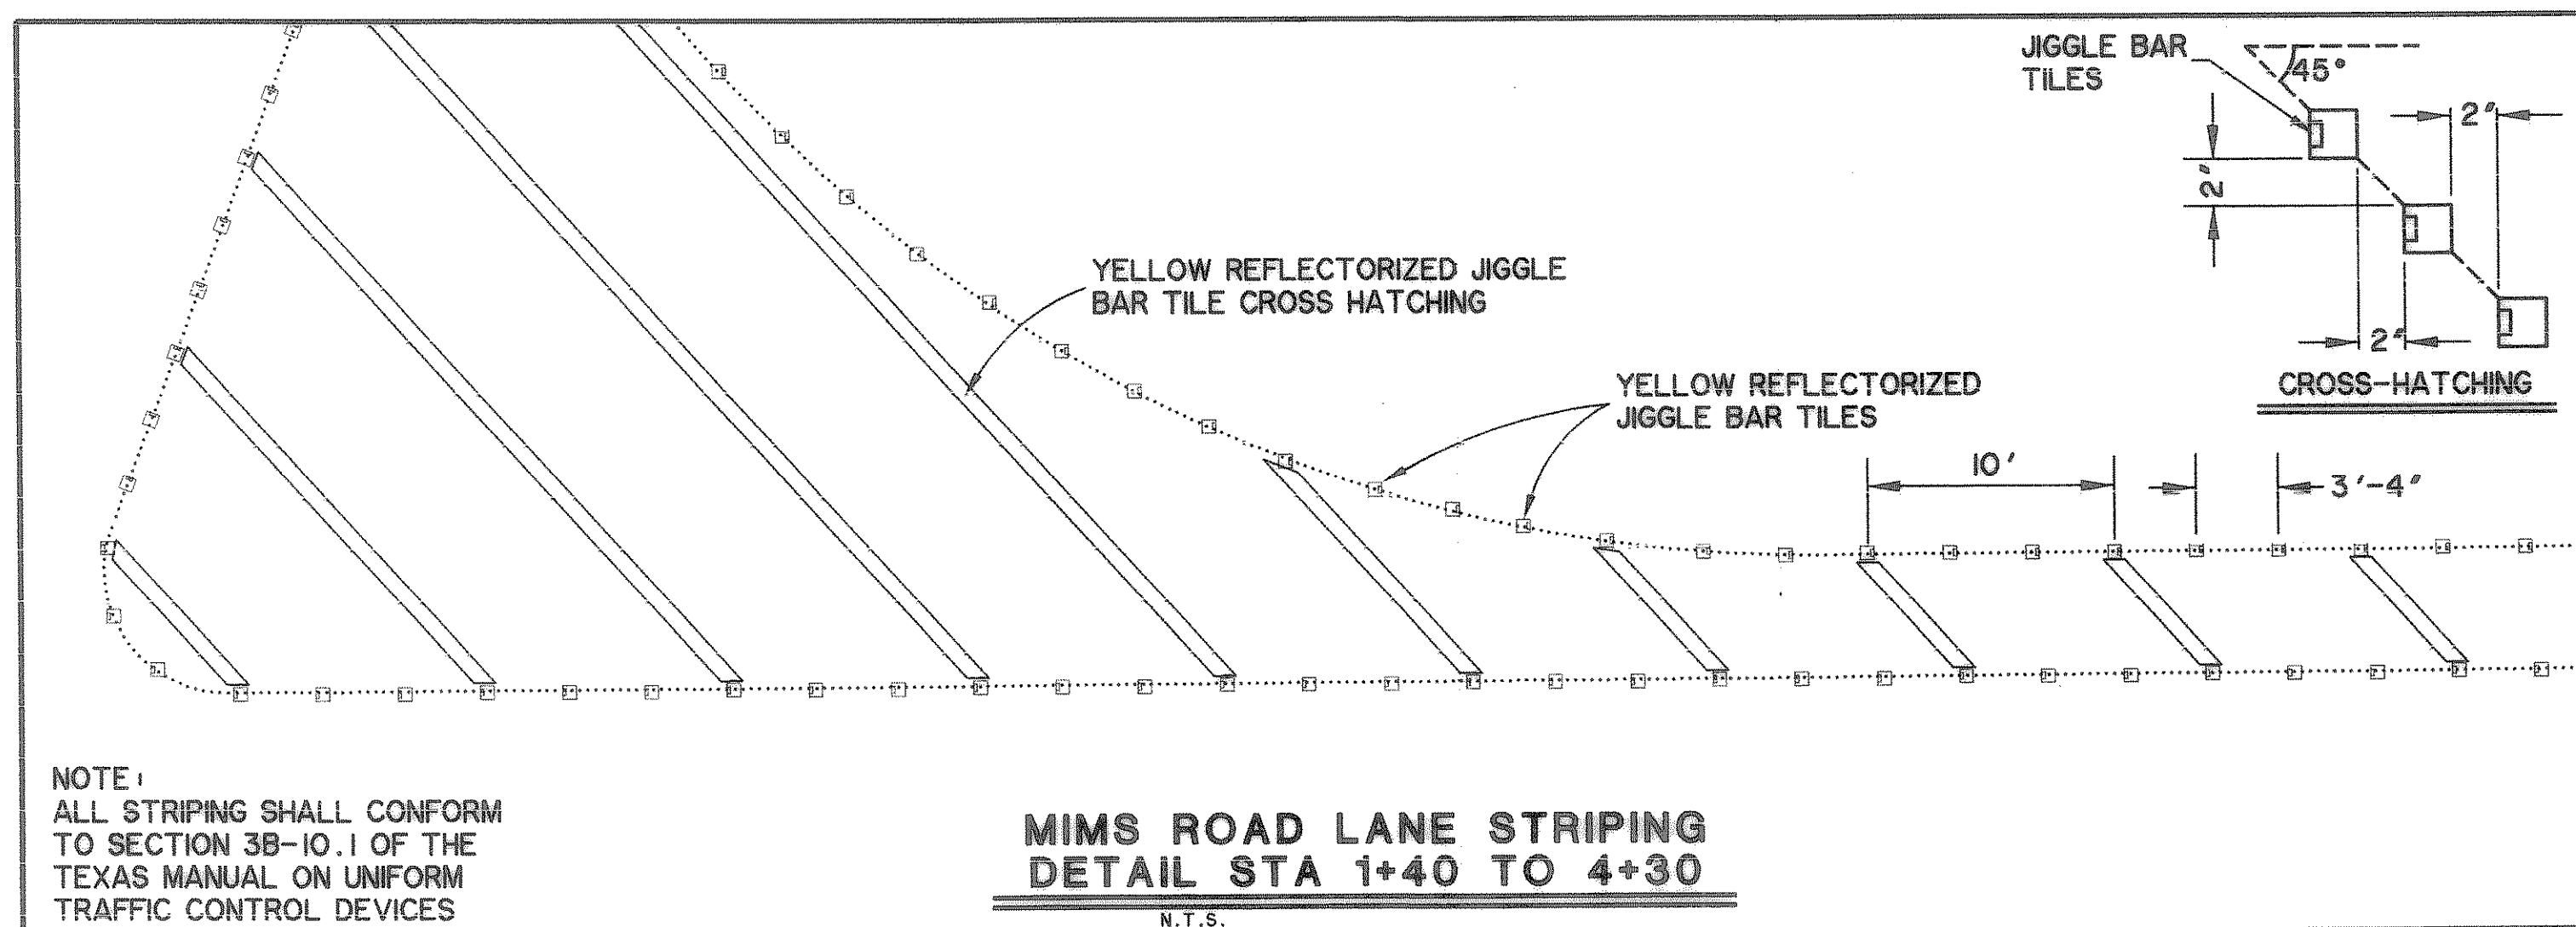


**MIMS ROAD LANE STRIPING  
DETAIL STA 1+40 TO 4+30**  
N.T.S.

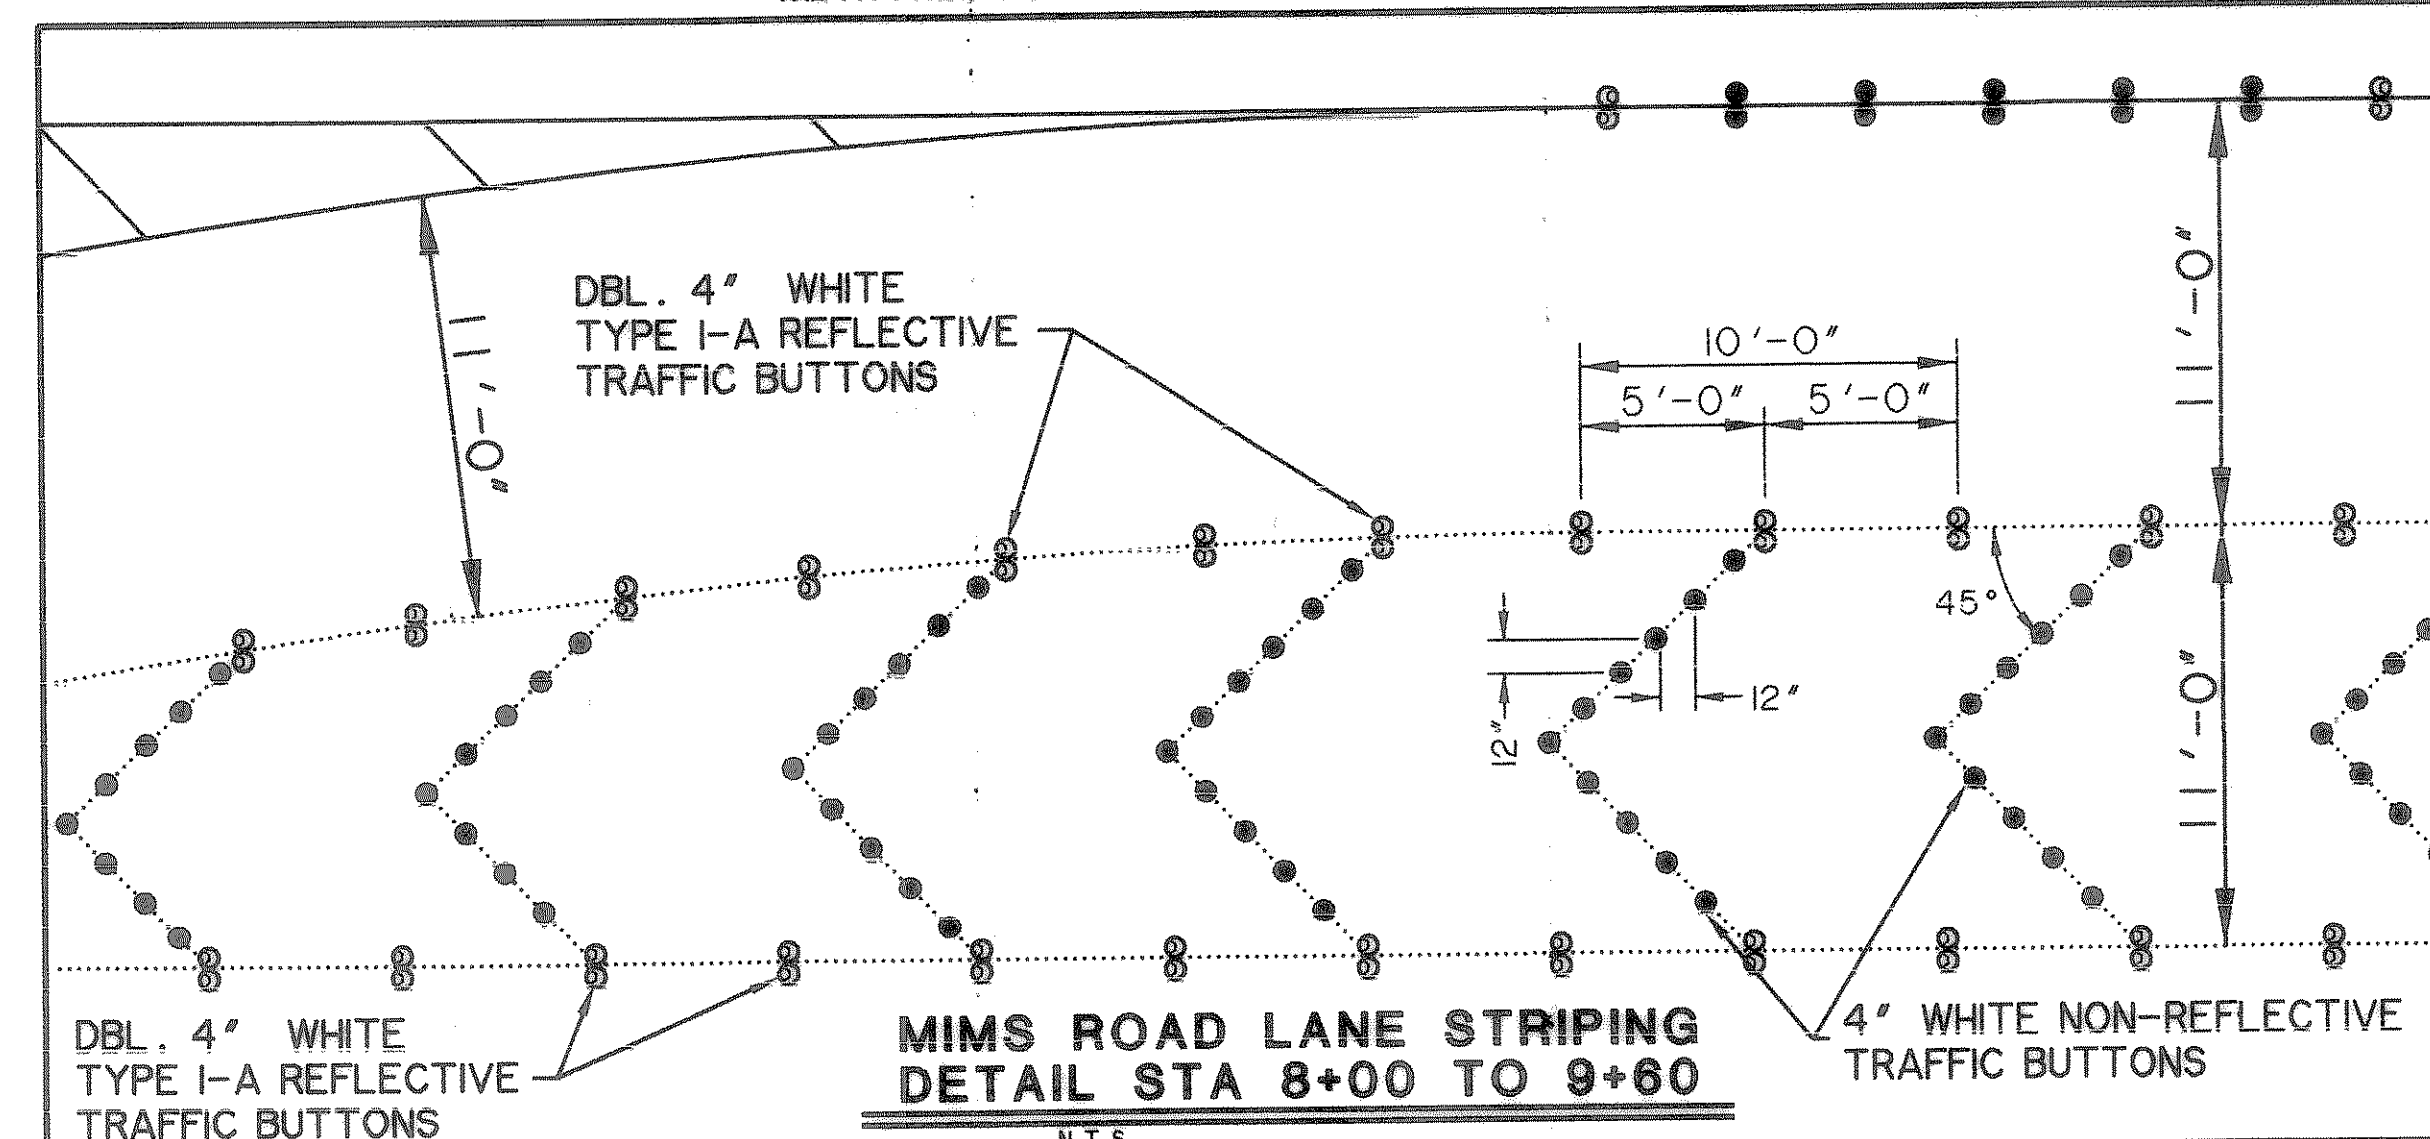


**MIMS ROAD LANE STRIPING  
DETAIL STA 8+00 TO 9+60**  
N.T.S.

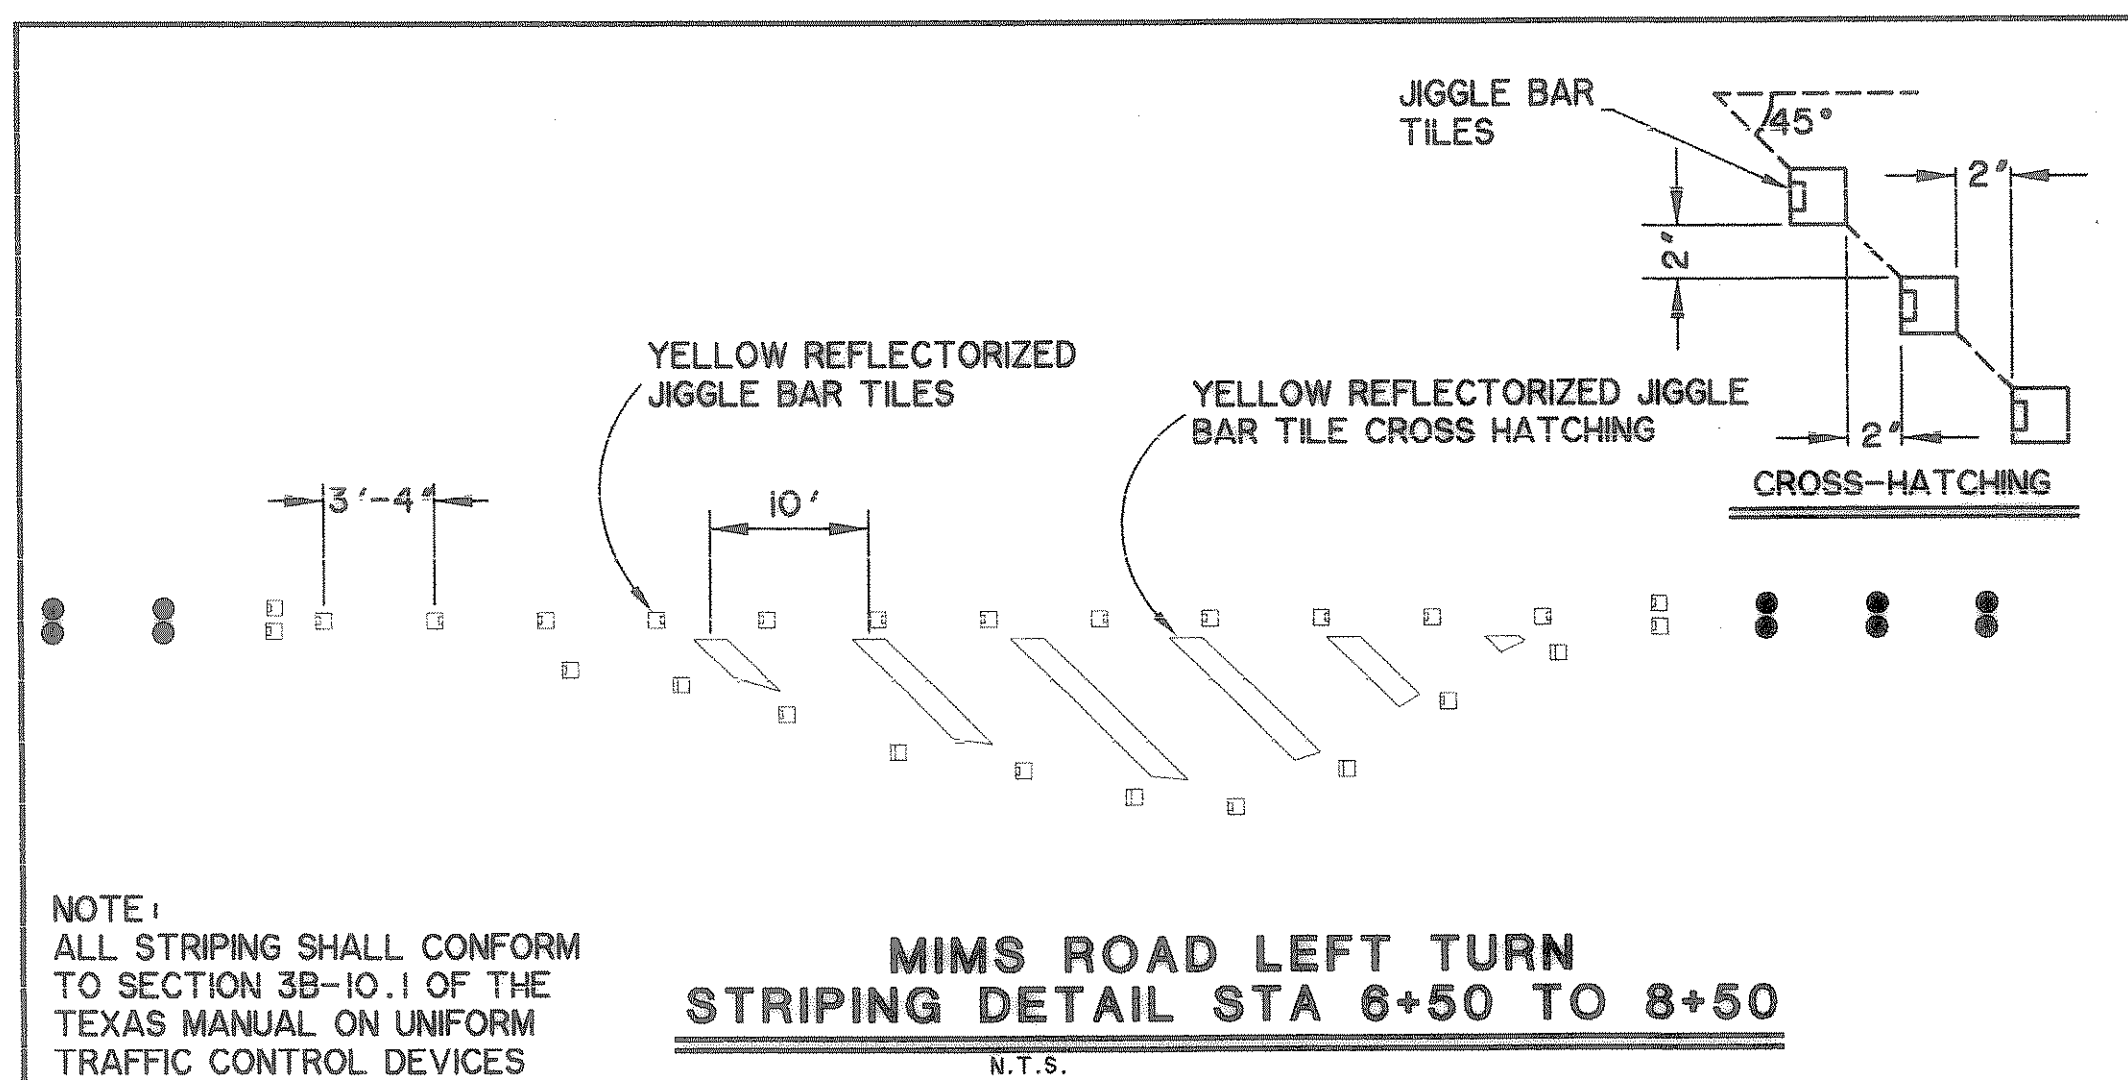

**MIMS ROAD LEFT TURN  
STRIPING DETAIL STA 6+50 TO 8+50**  
N.T.S.

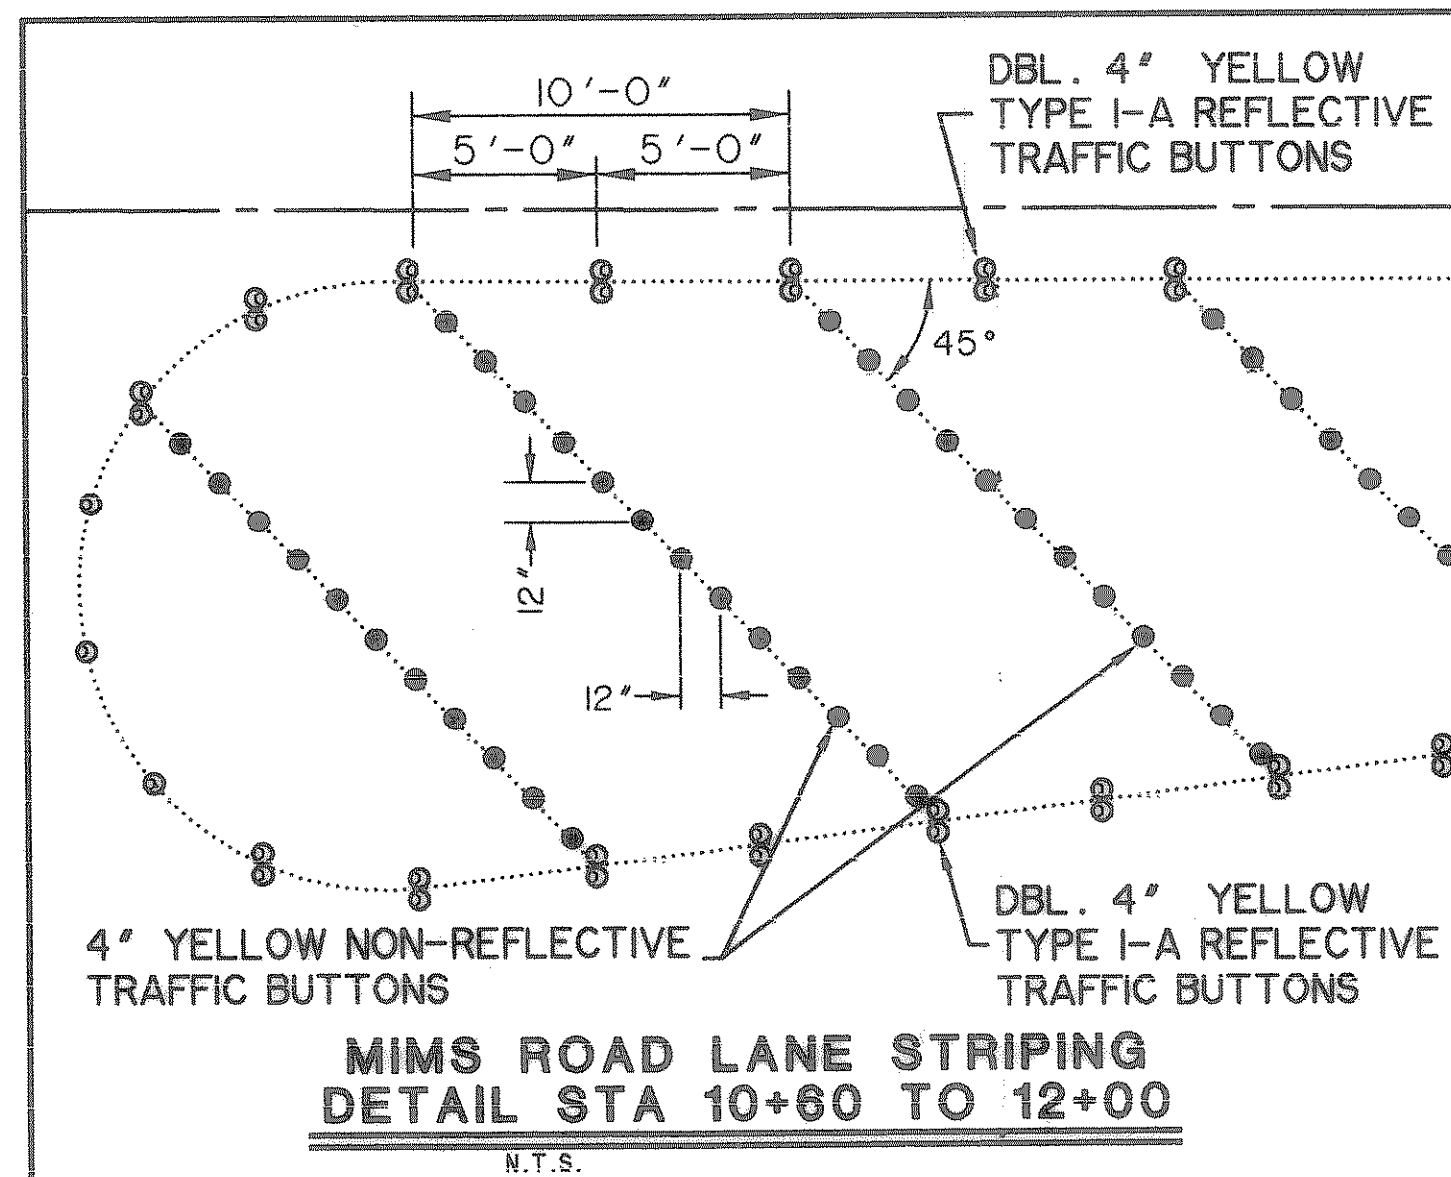


**MIMS ROAD LANE STRIPING  
DETAIL STA 10+60 TO 12+00**  
N.T.S.

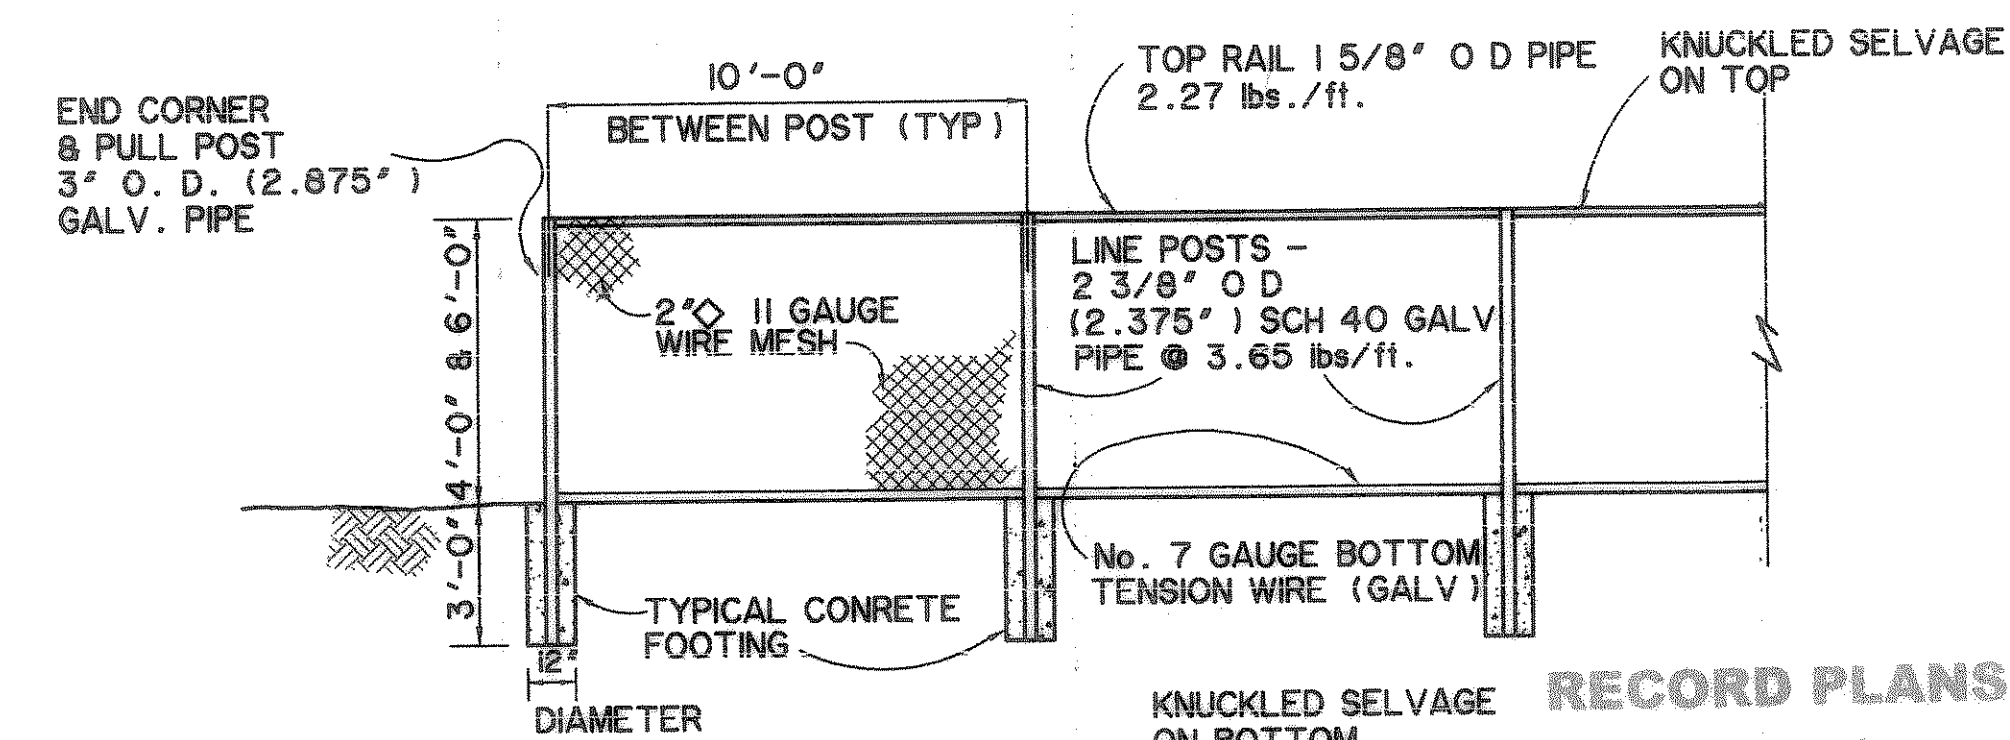


- NOTES:
1. ALL FENCE FABRIC TO BE ON INSIDE OF SCHOOL YARD AREA
  2. 4'-0" HIGH FENCE SHALL BE BLACK COATED WITH BLACK COATED POSTS AND HARDWARE. (ONLY FENCE ALONG TOP OF RETAINING WALL.)
- 4' & 6' HIGH CHAIN LINK FENCE**  
SCALE: 1/4" = 1' - 0"

RECORD PLANS  
1-15-02

PREPARED BY:  
**VIA WIER & ASSOCIATES, INC.**  
ENGINEERS SURVEYORS LAND PLANNERS  
4300 BELLEVUE PLACE SUITE 130 ARLINGTON, TEXAS 76018 METRO (817)467-7700  
4108 MAIN CENTER BLDG. SUITE 200 FORT WORTH, TEXAS 76105 METRO (817)365-9437

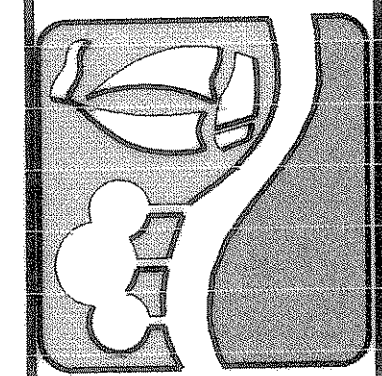

MIMS ROAD BUTTON LAYOUT,  
RETAINING WALL AND  
CHAIN LINK FENCE DETAILS

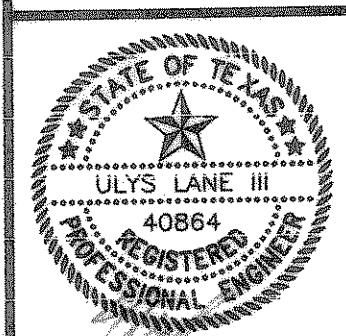

COPYRIGHT ©  
WIER & ASSOCIATES, INC.  
LAST SHEET EDIT  
DATE 1-28-02  
WAK 97057  
**SHEET NO.**  
53

FILE: SDMMDET2.dwg  
TIME: 6:34