

INTERSTATE HIGHWAY No. 30

NOTE: ALL SIGNS TO BE INSTALLED BY CITY FORCES.

STATE OF TEXAS
VOL. 65, PG. 591
D.R.R.C.T.

INSTALL YELLOW TYPE I-A & NON-REFLECTIVE TRAFFIC BUTTONS PER DETAIL SHEET 50.

INSTALL DBL. 4" WHITE REFLECTIVE CHANNELIZING TRAFFIC BUTTONS ON 5' CENTERS

INSTALL LEFT TURN ONLY ARROW

YIELD SIGN R1-2

INSTALL YELLOW TRAFFIC BUTTONS PER DETAIL SHEET 53.

INSTALL LEFT TURN ONLY ARROW

INSTALL YELLOW TYPE I-A & NON-REFLECTIVE TRAFFIC BUTTONS PER DETAIL SHEET 50.

INSTALL DBL. 4" WHITE REFLECTIVE CHANNELIZING TRAFFIC BUTTONS ON 5' CENTERS

INSTALL LEFT TURN ONLY ARROW

MIMS ROAD

MIMS ROAD

LEFT LANE MUST TURN LEFT SIGN R3-7

INSTALL WHITE TYPE I-A & NON-REFLECTIVE TRAFFIC BUTTONS PER DETAIL SHEET 50.

INSTALL YELLOW TRAFFIC BUTTONS PER DETAIL SHEET 53.

INSTALL WHITE TYPE I-A & NON-REFLECTIVE TRAFFIC BUTTONS PER DETAIL SHEET 50.

INSTALL CROSSWALK, STOP BAR PER DETAIL SHEET 50.

STOP SIGN R1-1


ROCKWALL INDEPENDENT SCHOOL DISTRICT
VOL. 1074, PG. 214
D.R.R.C.T.

LOT 4, BLOCK "A" ROCKWALL MARKET CENTER EAST




MATCH LINE STA 7+00

PREPARED BY:
WIA WIER & ASSOCIATES, INC.
ENGINEERS SURVEYORS LAND PLANNERS
4300 BELTWAY PLACE, SUITE 130 ARLINGTON, TEXAS 76016 METRO (817)467-7700
4108 ANON CENTER ROAD, SUITE 200 FORT WORTH, TEXAS 76165 METRO (817)385-4437

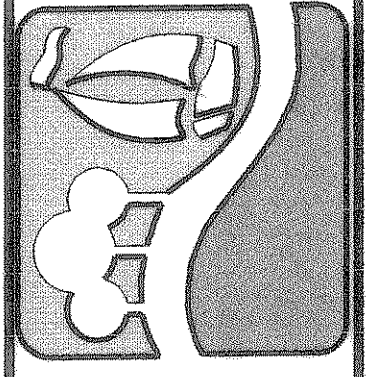

MIMS ROAD STRIPING LAYOUT PLAN

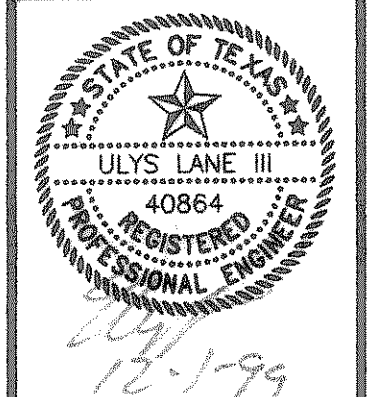

COPYRIGHT © WIER & ASSOCIATES, INC.
LAST SHEET EDIT DATE 11-29-99
WAR 97057
SHEET NO. 54

INSTALL YELLOW TRAFFIC BUTTONS PER DETAIL SHEET 53.

STATE OF TEXAS
VOL. 65, PG. 591
D.R.R.C.T.

INSTALL 8" YELLOW TRAFFIC BUTTONS @ 5' c/c

LEFT LANE MUST TURN LEFT SIGN R3-7

INSTALL WHITE TRAFFIC BUTTONS PER DETAIL SHEET 53.

INSTALL YELLOW TYPE I-A & NON-REFLECTIVE TRAFFIC BUTTONS PER DETAIL SHEET 50.

INSTALL THROUGH ARROW

INSTALL CROSSWALK, STOP BAR PER DETAIL SHEET 50.

STOP SIGN R1-1

INSTALL DBL. 4" WHITE REFLECTIVE CHANNELIZING TRAFFIC BUTTONS @ 5' c/c

PRS REALTY II, LP
VOL. 961, PG. 55
D.R.R.C.T.

MIMS ROAD

MIMS ROAD

INSTALL THROUGH ARROW

INSTALL YELLOW TRAFFIC BUTTONS PER DETAIL SHEET 53.

INSTALL LEFT TURN ONLY ARROW

INSTALL WHITE TYPE I-A & NON-REFLECTIVE TRAFFIC BUTTONS PER DETAIL SHEET 50.

RIGHT LANE MUST TURN LEFT SIGN R3-7

INSTALL DBL. 4" WHITE REFLECTIVE CHANNELIZING TRAFFIC BUTTONS ON 5' CENTERS

INSTALL RIGHT TURN ONLY ARROW

STOP SIGN R1-1

INSTALL CROSSWALK, STOP BAR PER DETAIL SHEET 50.

STOP SIGN R1-1

INSTALL RIGHT TURN ONLY ARROW

INSTALL LEFT TURN ONLY ARROW

SHEPHERD PLACE HOMES, INC.
VOL. 1289, PG. 150
D.R.R.C.T.

RECORD PLANS
1-15-02



TIME 116.116 FILE 1 STRIP1.dwg