



NO.	RADIUS	DELTA	ARC	TANGENT	CHORD	BEARING
1106	30.00	86°05'29"	45.08	28.02	40.95	S 88°54'19"E
1107	30.00	87°51'59"	46.01	28.90	41.63	S 01°55'35"E
1108	20.00	89°53'49"	31.38	19.96	28.26	N 00°54'40"W
1130	100.00	67°48'03"	118.33	67.20	111.55	N 86°56'01"E
1131	50.00	110°18'45"	96.27	71.82	82.07	N 04°00'35"W
1132	20.00	82°47'59"	28.90	17.63	26.45	S 85°40'59"W


INTERSTATE HIGHWAY No 30

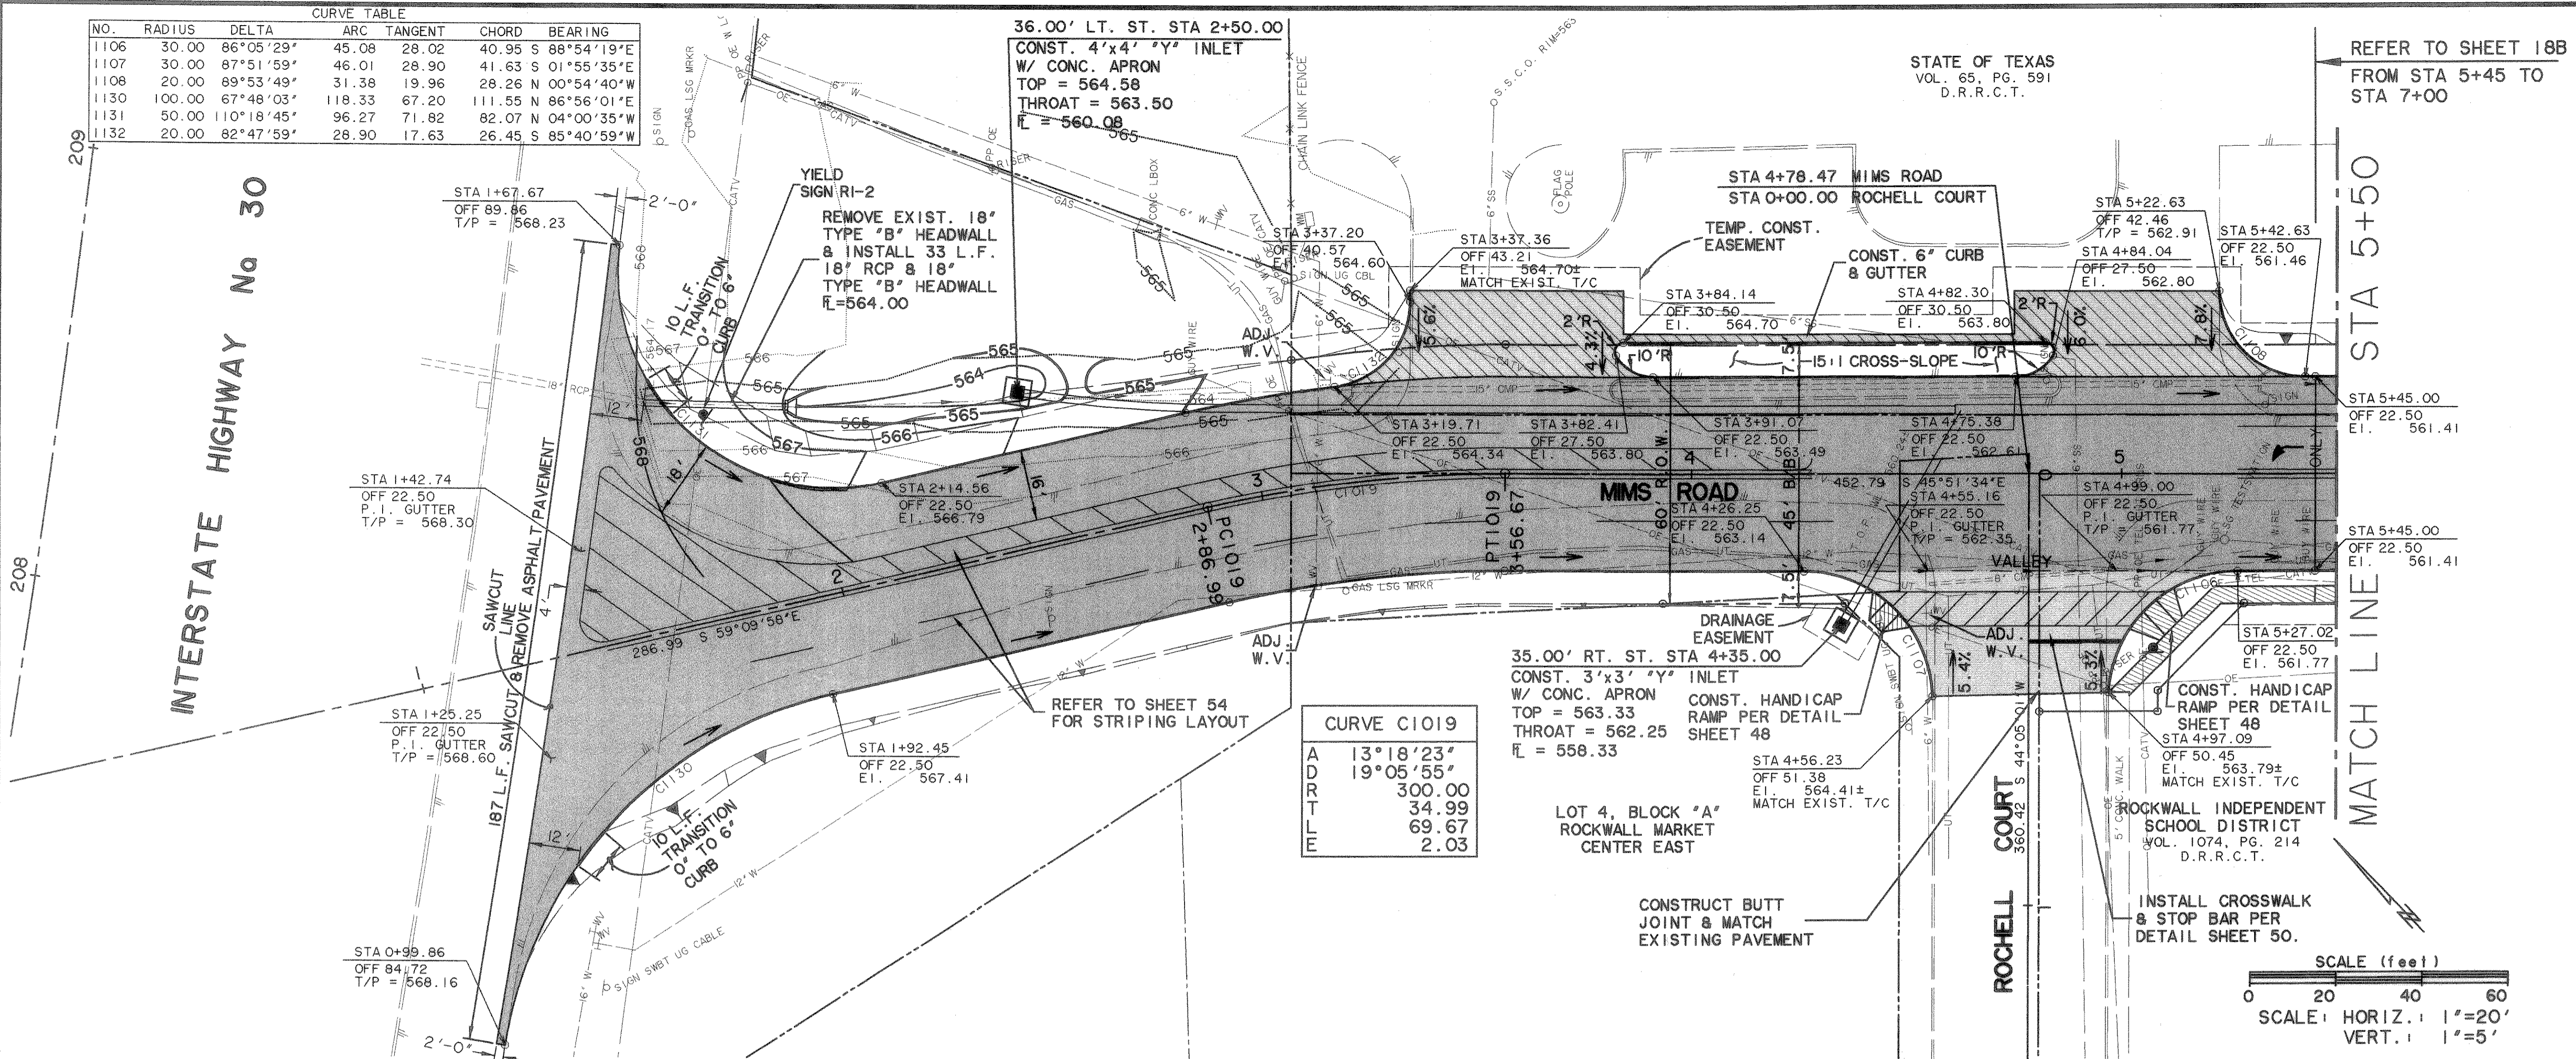


CURVE C1019	
A	13°18'23"
D	19°05'55"
R	300.00
T	34.99
E	69.67
L	2.03

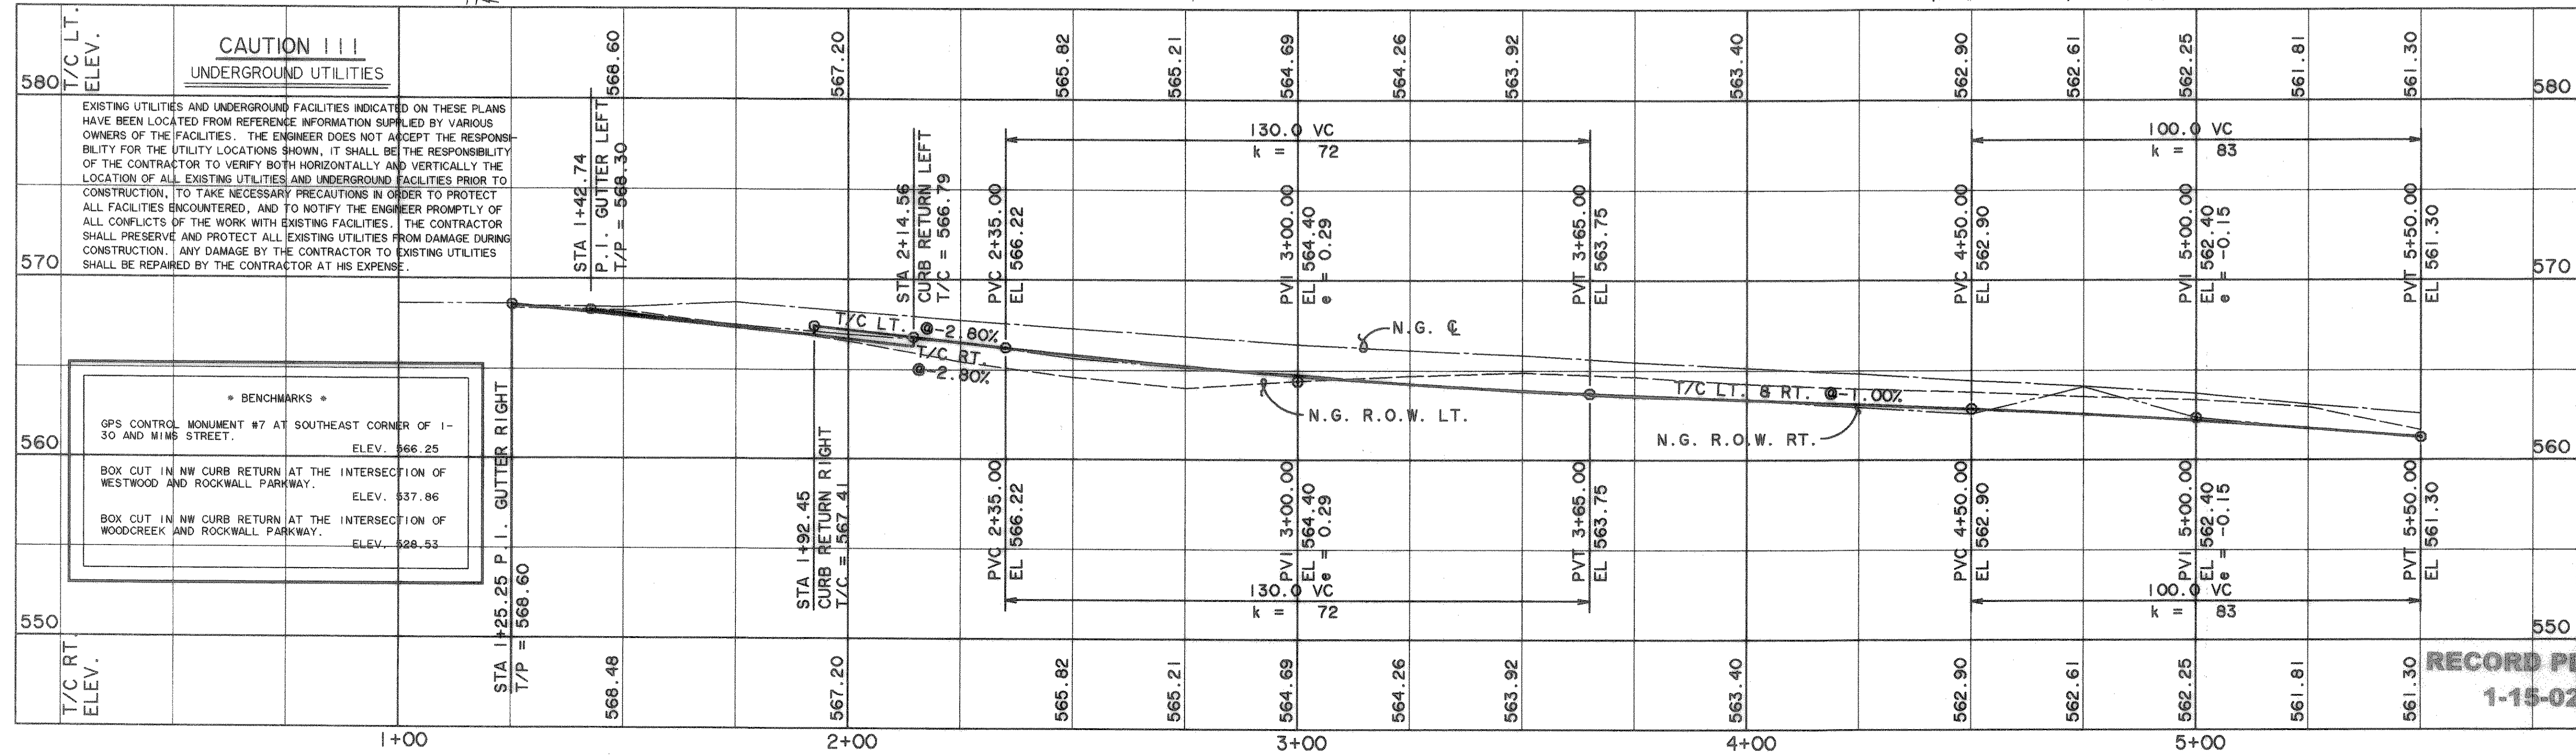

PREPARED BY:  
**VIA WIER & ASSOCIATES, INC.**  
 ENGINEERS SURVEYORS LAND PLANNERS  
 4310 BELWAY PLACE SUITE 130 ARLINGTON, TEXAS 76018 METRO (817)467-7700  
 4108 AMON CENTER BLD. SUITE 200 FORT WORTH, TEXAS 76105 METRO (817)355-9437

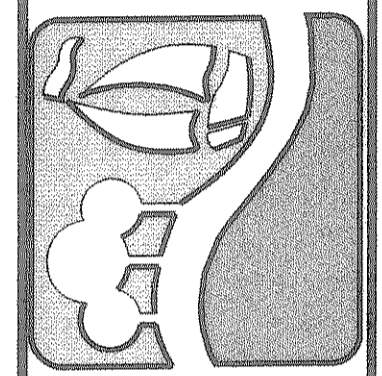

MIMS ROAD  
 PAVING PLAN & PROFILE  
 STA 0+50 TO 5+45

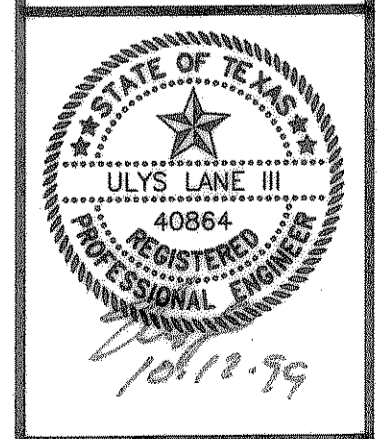

COPYRIGHT ©  
 WIER & ASSOCIATES, INC.  
 LAST SHEET EDIT  
 DATE 10-1-99  
 WA# 97057  
 SHEET NO.  
 18A

TIME: 6:30  
 FILE: PAVE33.dwg