

* BENCHMARKS *

GPS CONTROL MONUMENT #7 AT SOUTHEAST CORNER OF 1-30 AND MIMS STREET. ELEV. 566.25

BOX CUT IN NW CURB RETURN AT THE INTERSECTION OF WESTWOOD AND ROCKWALL PARKWAY. ELEV. 537.86

BOX CUT IN NW CURB RETURN AT THE INTERSECTION OF WOODCREEK AND ROCKWALL PARKWAY. ELEV. 528.53


CAUTION !!!
UNDERGROUND UTILITIES

EXISTING UTILITIES AND UNDERGROUND FACILITIES INDICATED ON THESE PLANS HAVE BEEN LOCATED FROM REFERENCE INFORMATION SUPPLIED BY VARIOUS OWNERS OF THE FACILITIES. THE ENGINEER DOES NOT ACCEPT THE RESPONSIBILITY FOR THE UTILITY LOCATIONS SHOWN. IT SHALL BE THE RESPONSIBILITY OF THE CONTRACTOR TO VERIFY BOTH HORIZONTALLY AND VERTICALLY THE LOCATION OF ALL EXISTING UTILITIES AND UNDERGROUND FACILITIES PRIOR TO CONSTRUCTION, TO TAKE NECESSARY PRECAUTIONS IN ORDER TO PROTECT ALL FACILITIES ENCOUNTERED, AND TO NOTIFY THE ENGINEER PROMPTLY OF ALL CONFLICTS OF THE WORK WITH EXISTING FACILITIES. THE CONTRACTOR SHALL PRESERVE AND PROTECT ALL EXISTING UTILITIES FROM DAMAGE DURING CONSTRUCTION. ANY DAMAGE BY THE CONTRACTOR TO EXISTING UTILITIES SHALL BE REPAIRED BY THE CONTRACTOR AT HIS EXPENSE.

PRS REALTY II, LP
VOL. 961, PG. 55
D.R.R.C.T.

PREPARED BY:
WIM WIER & ASSOCIATES, INC.
ENGINEERS SURVEYORS LAND PLANNERS
4300 BELLEVUE PLACE SUITE 130 ARLINGTON, TEXAS 76016 METRO (817)467-7700
4108 AMON CARTER BLVD. SUITE 200 FORT WORTH, TEXAS 76155 METRO (817)355-9457

MATCH LINE STA 7+00


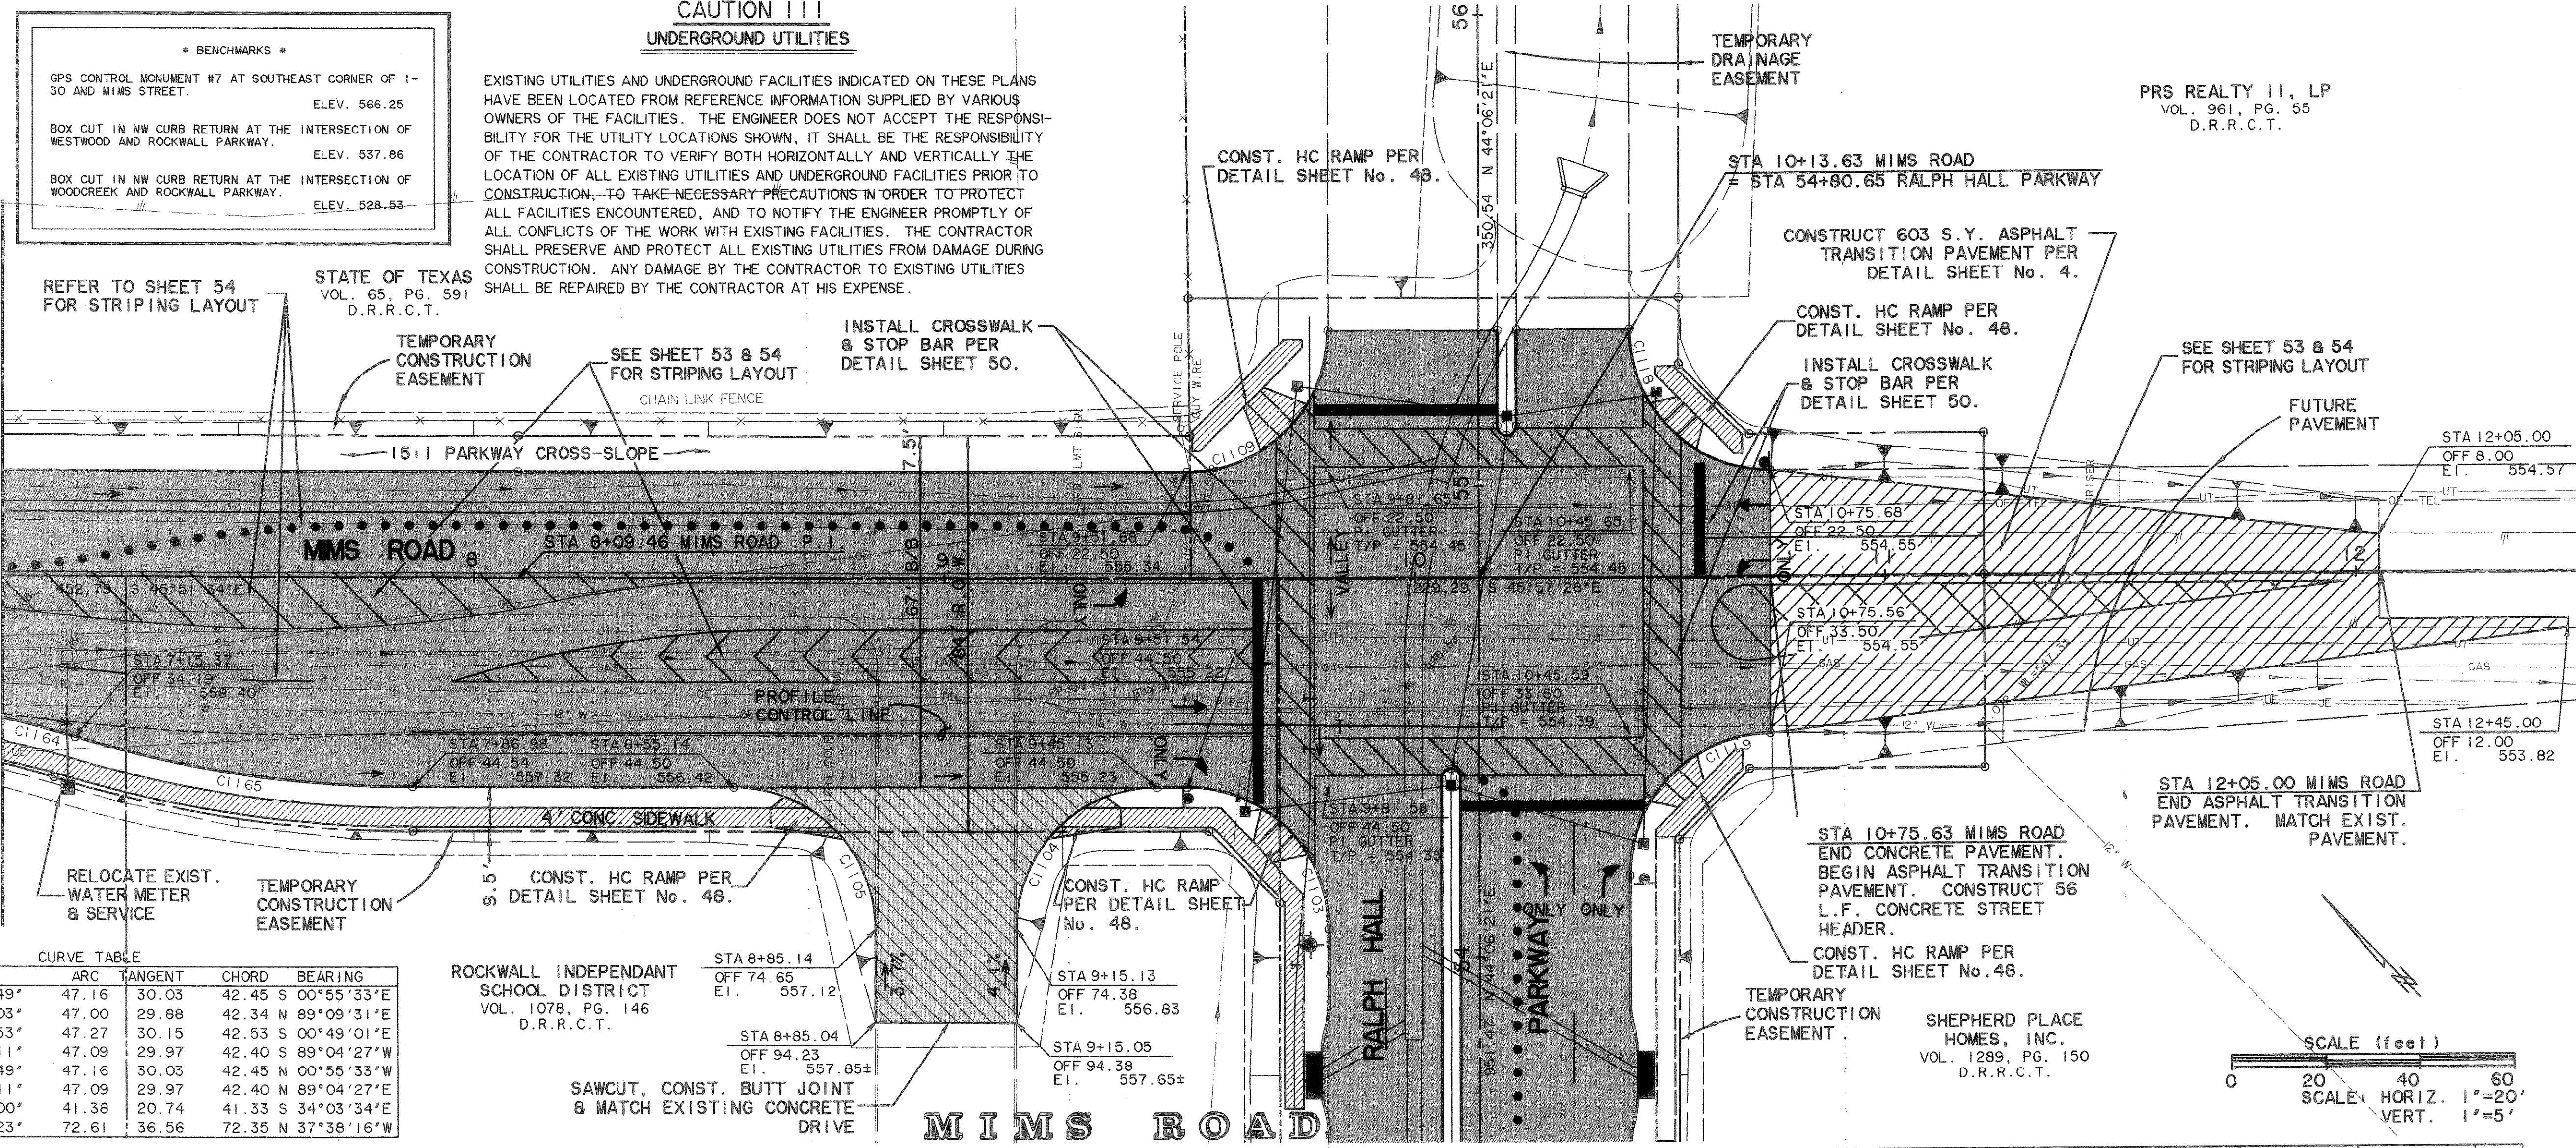


CURVE TABLE

NO.	RADIUS	DELTA	ARC TANGENT	CHORD BEARING	
1103	30.00	90°03'49"	47.16	30.03	42.45 S 00°55'33"E
1104	30.00	89°46'03"	47.00	29.86	42.34 N 89°09'31"E
1105	30.00	90°16'53"	47.27	30.15	42.53 S 00°49'01"E
1109	30.00	89°56'11"	47.09	29.97	42.40 S 89°04'27"W
1118	30.00	90°03'49"	47.16	30.03	42.45 N 00°55'33"W
1119	30.00	89°56'11"	47.09	29.97	42.40 N 89°04'27"E
1164	250.00	09°29'00"	41.38	20.74	41.33 S 34°03'34"E
1165	250.00	16°38'23"	72.61	36.56	72.35 N 37°38'16"W

ROCKWALL INDEPENDENT SCHOOL DISTRICT
VOL. 1078, PG. 146
D.R.R.C.T.

SHEPHERD PLACE HOMES, INC.
VOL. 1289, PG. 150
D.R.R.C.T.

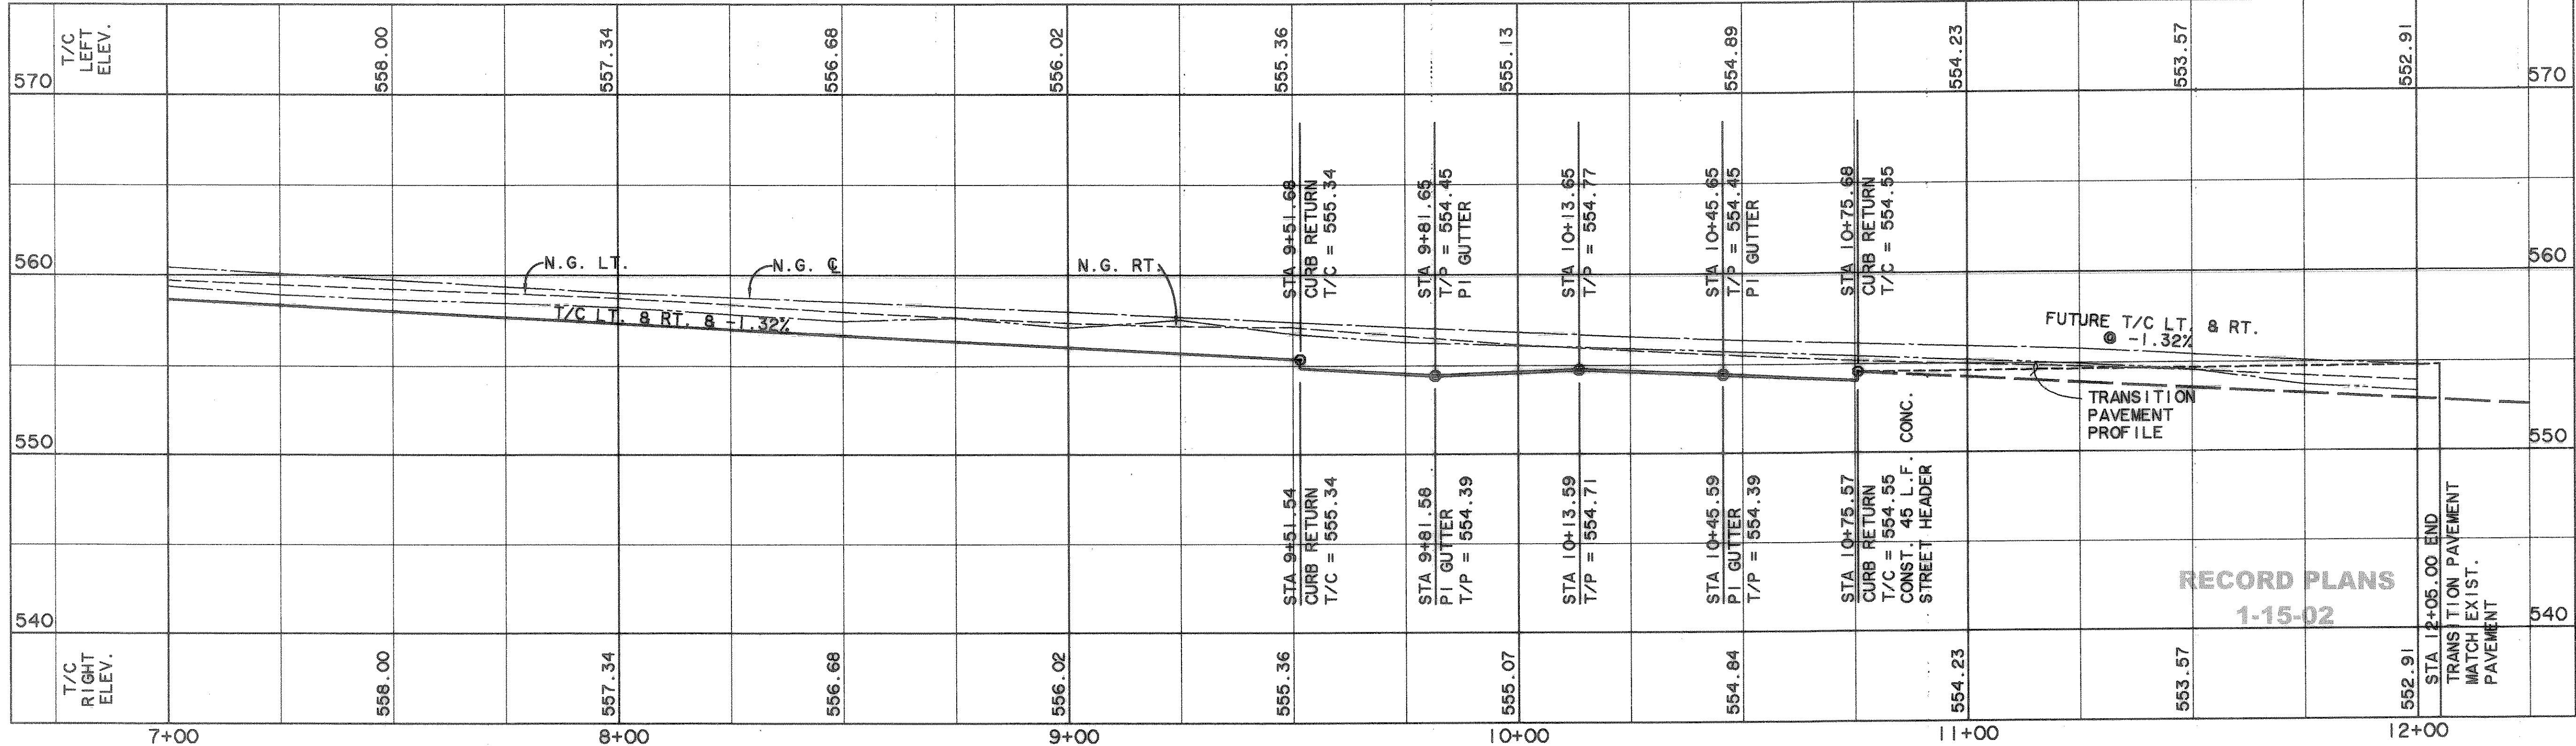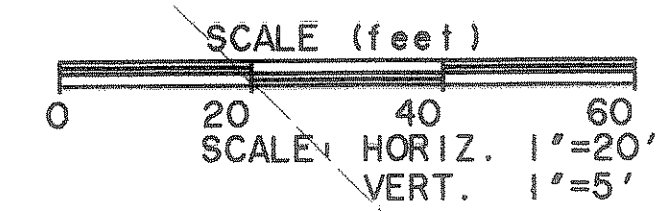

RECORD PLANS
1-15-02

MIMS ROAD
PAVING PLAN & PROFILE
STA 7+00 TO 12+00



COPYRIGHT ©
WIER & ASSOCIATES, INC.
LAST SHEET EDIT
DATE 11-24-99
WA# 97057

SHEET NO.
10

TIME 13:06 FILE:PAYE24.dwg