







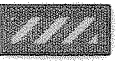

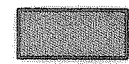

CONSTRUCTION PHASING LEGEND

- | | |
|----------------------------------------------------------------------------------------------------------|----------------------------------------------------------------------------------------------------------------------|
|  PHASE "A" CONSTRUCTION |  PHASE "F" CONSTRUCTION |
|  PHASE "B" CONSTRUCTION |  TEMPORARY ASPHALT WIDENING |
|  PHASE "C" CONSTRUCTION |  DENOTES INLET TREATMENT |
|  PHASE "D" CONSTRUCTION |  DENOTES UN-REINFORCED SILT FENCE |
|  PHASE "E" CONSTRUCTION |  DENOTES REINFORCED SILT FENCE |

LOT 1, BLOCK "B"
HOME DEPOT ROCKWALL ADDN.

PHASE "B" STORM DRAIN CONSTRUCTION.
PROVIDE PHASE I & II INLET
TREATMENT, MAINTAIN UNTIL PARKWAYS
ARE SEEDDED.

PROVIDE INLET TREATMENT AT EXISTING
"Y" INLET. MAINTAIN UNTIL BERM/SWALE
IS SEEDDED.

RW MARKETCENTER
ASSOCIATES, LTD.

CONSTRUCT BERM/SWALE
TO EXISTING INLET @
TUBBS & MARKET CENTER
STREET

PROVIDE TEMPORARY INLET TREATMENT ON
EXISTING "Y" INLET UNTIL CONVERSION
TO JUNCTION BOX IS COMPLETE.




PHASE "A" STORM DRAIN CONSTRUCTION.
PROVIDE PHASE I & II INLET
TREATMENT, MAINTAIN UNTIL PARKWAYS
ARE SEEDDED.

INSTALL 50 L.F. REINFORCED SILT
FENCE. PHASE "C" CONSTRUCTION
MAINTAIN UNTIL SLOPES ARE SEEDDED.




INSTALL 720 L.F. REINFORCED
SILT FENCE ALONG EXISTING CHAIN
LINK FENCE. PHASE "C" CONSTRUCTION
MAINTAIN UNTIL SLOPES ARE SEEDDED.

PROVIDE PHASE II INLET
TREATMENT FOR EXISTING INLET

MATCH LINE STA 26+00

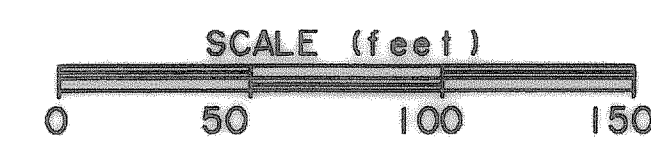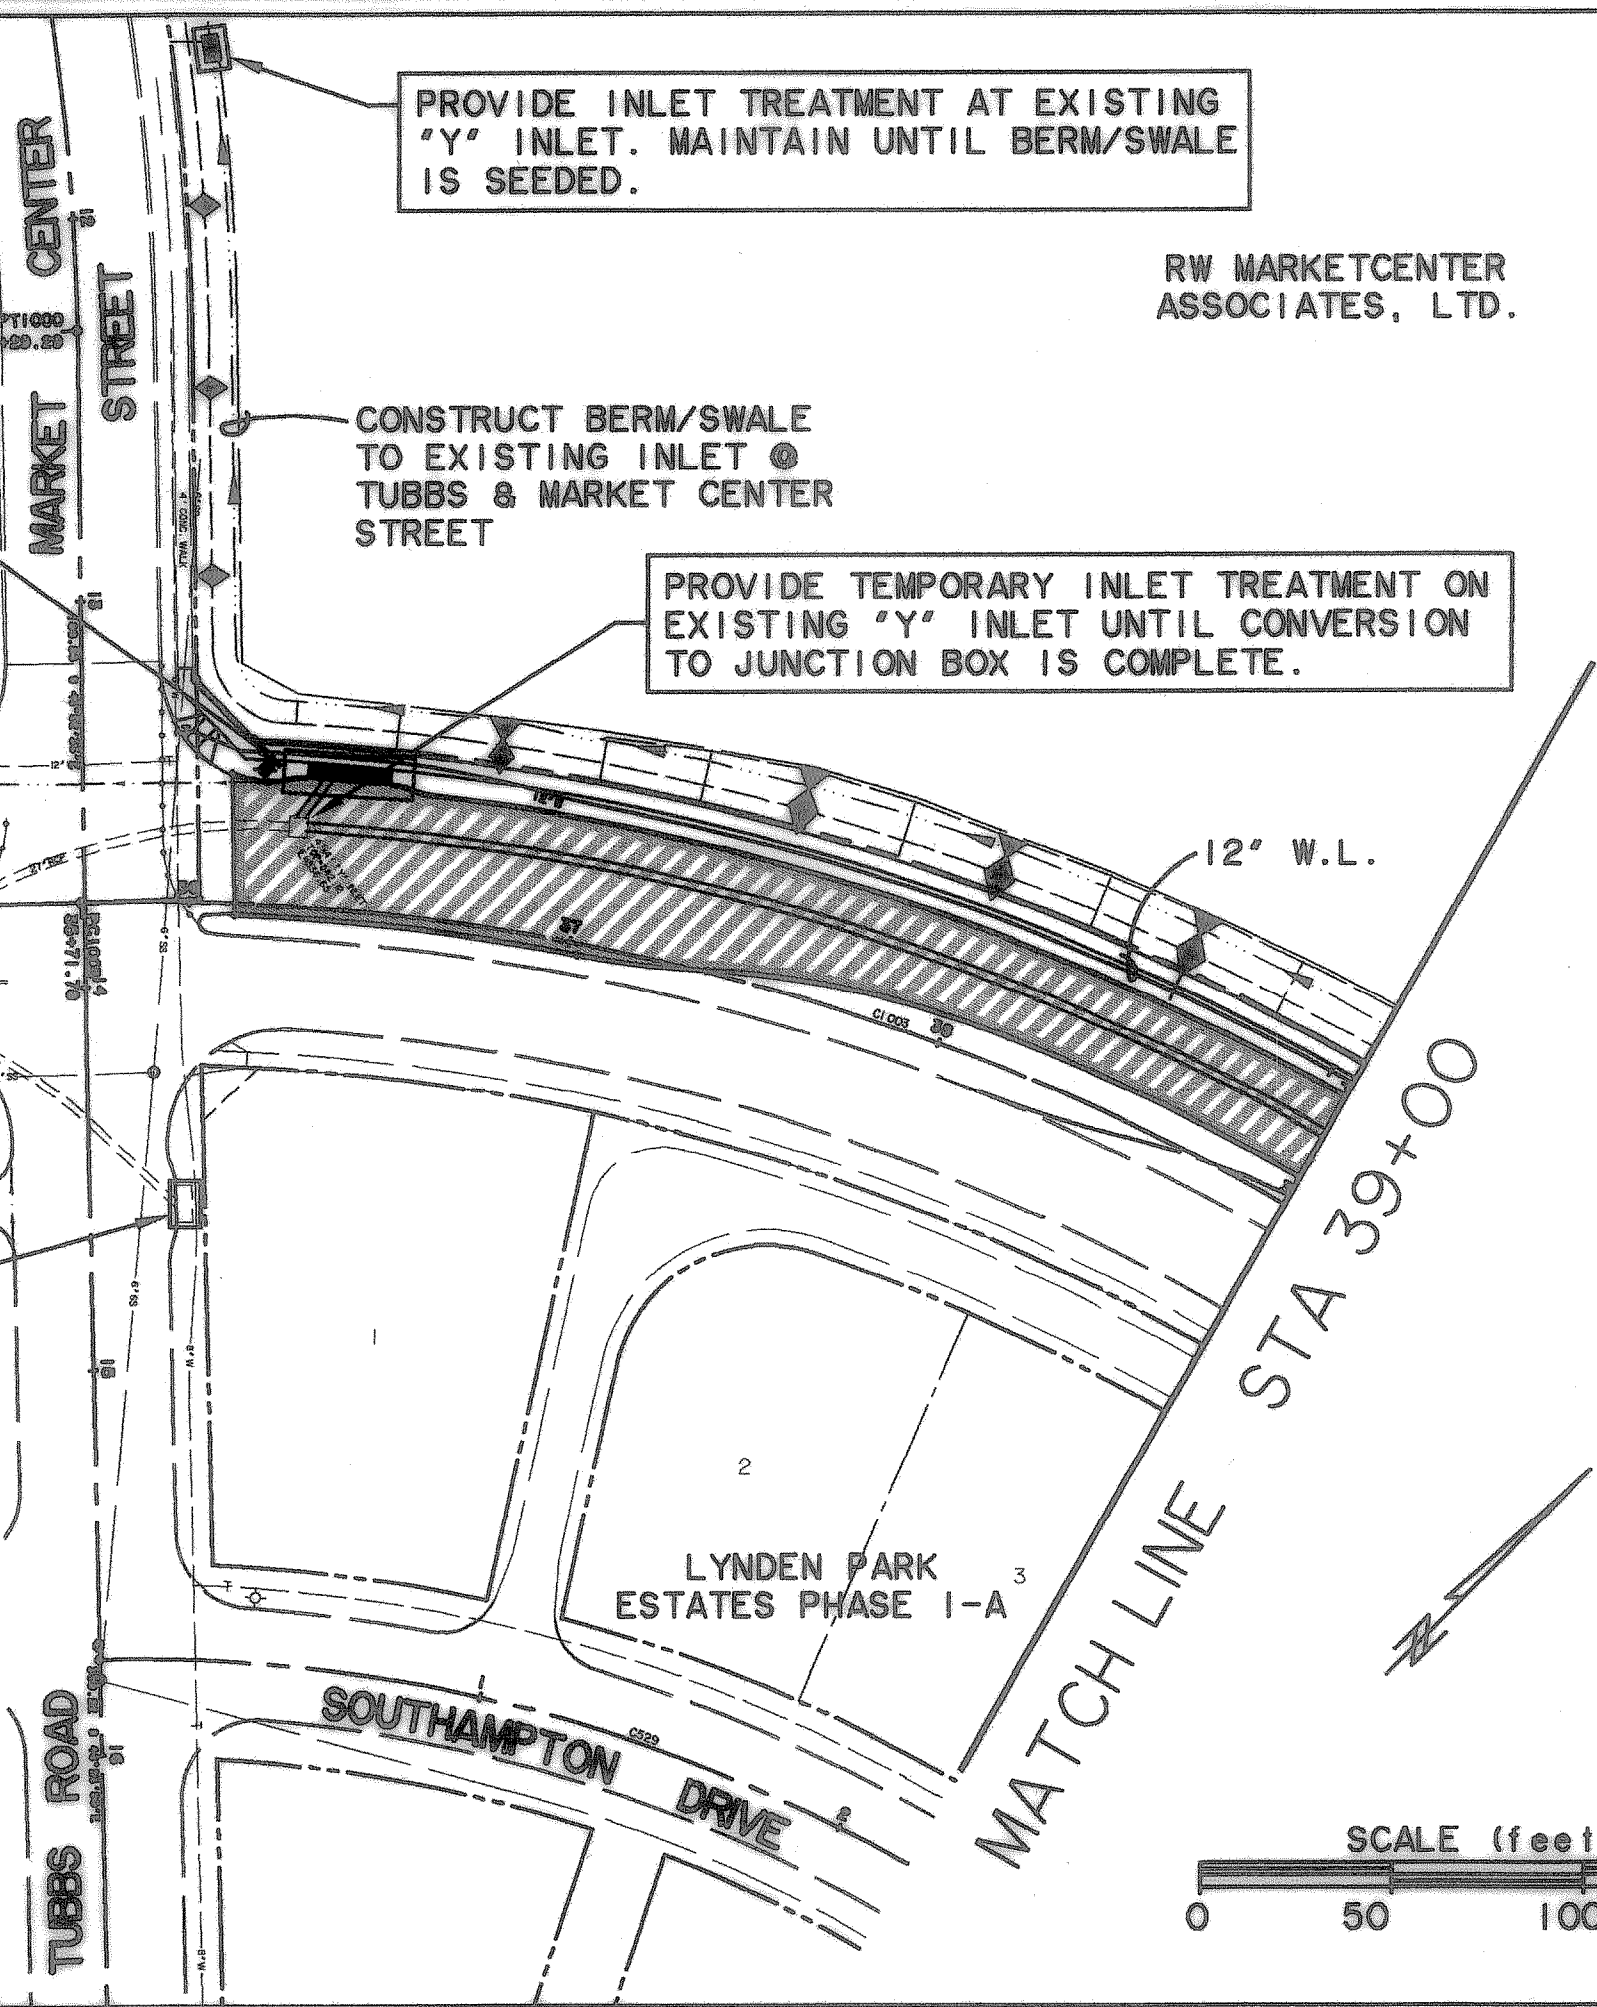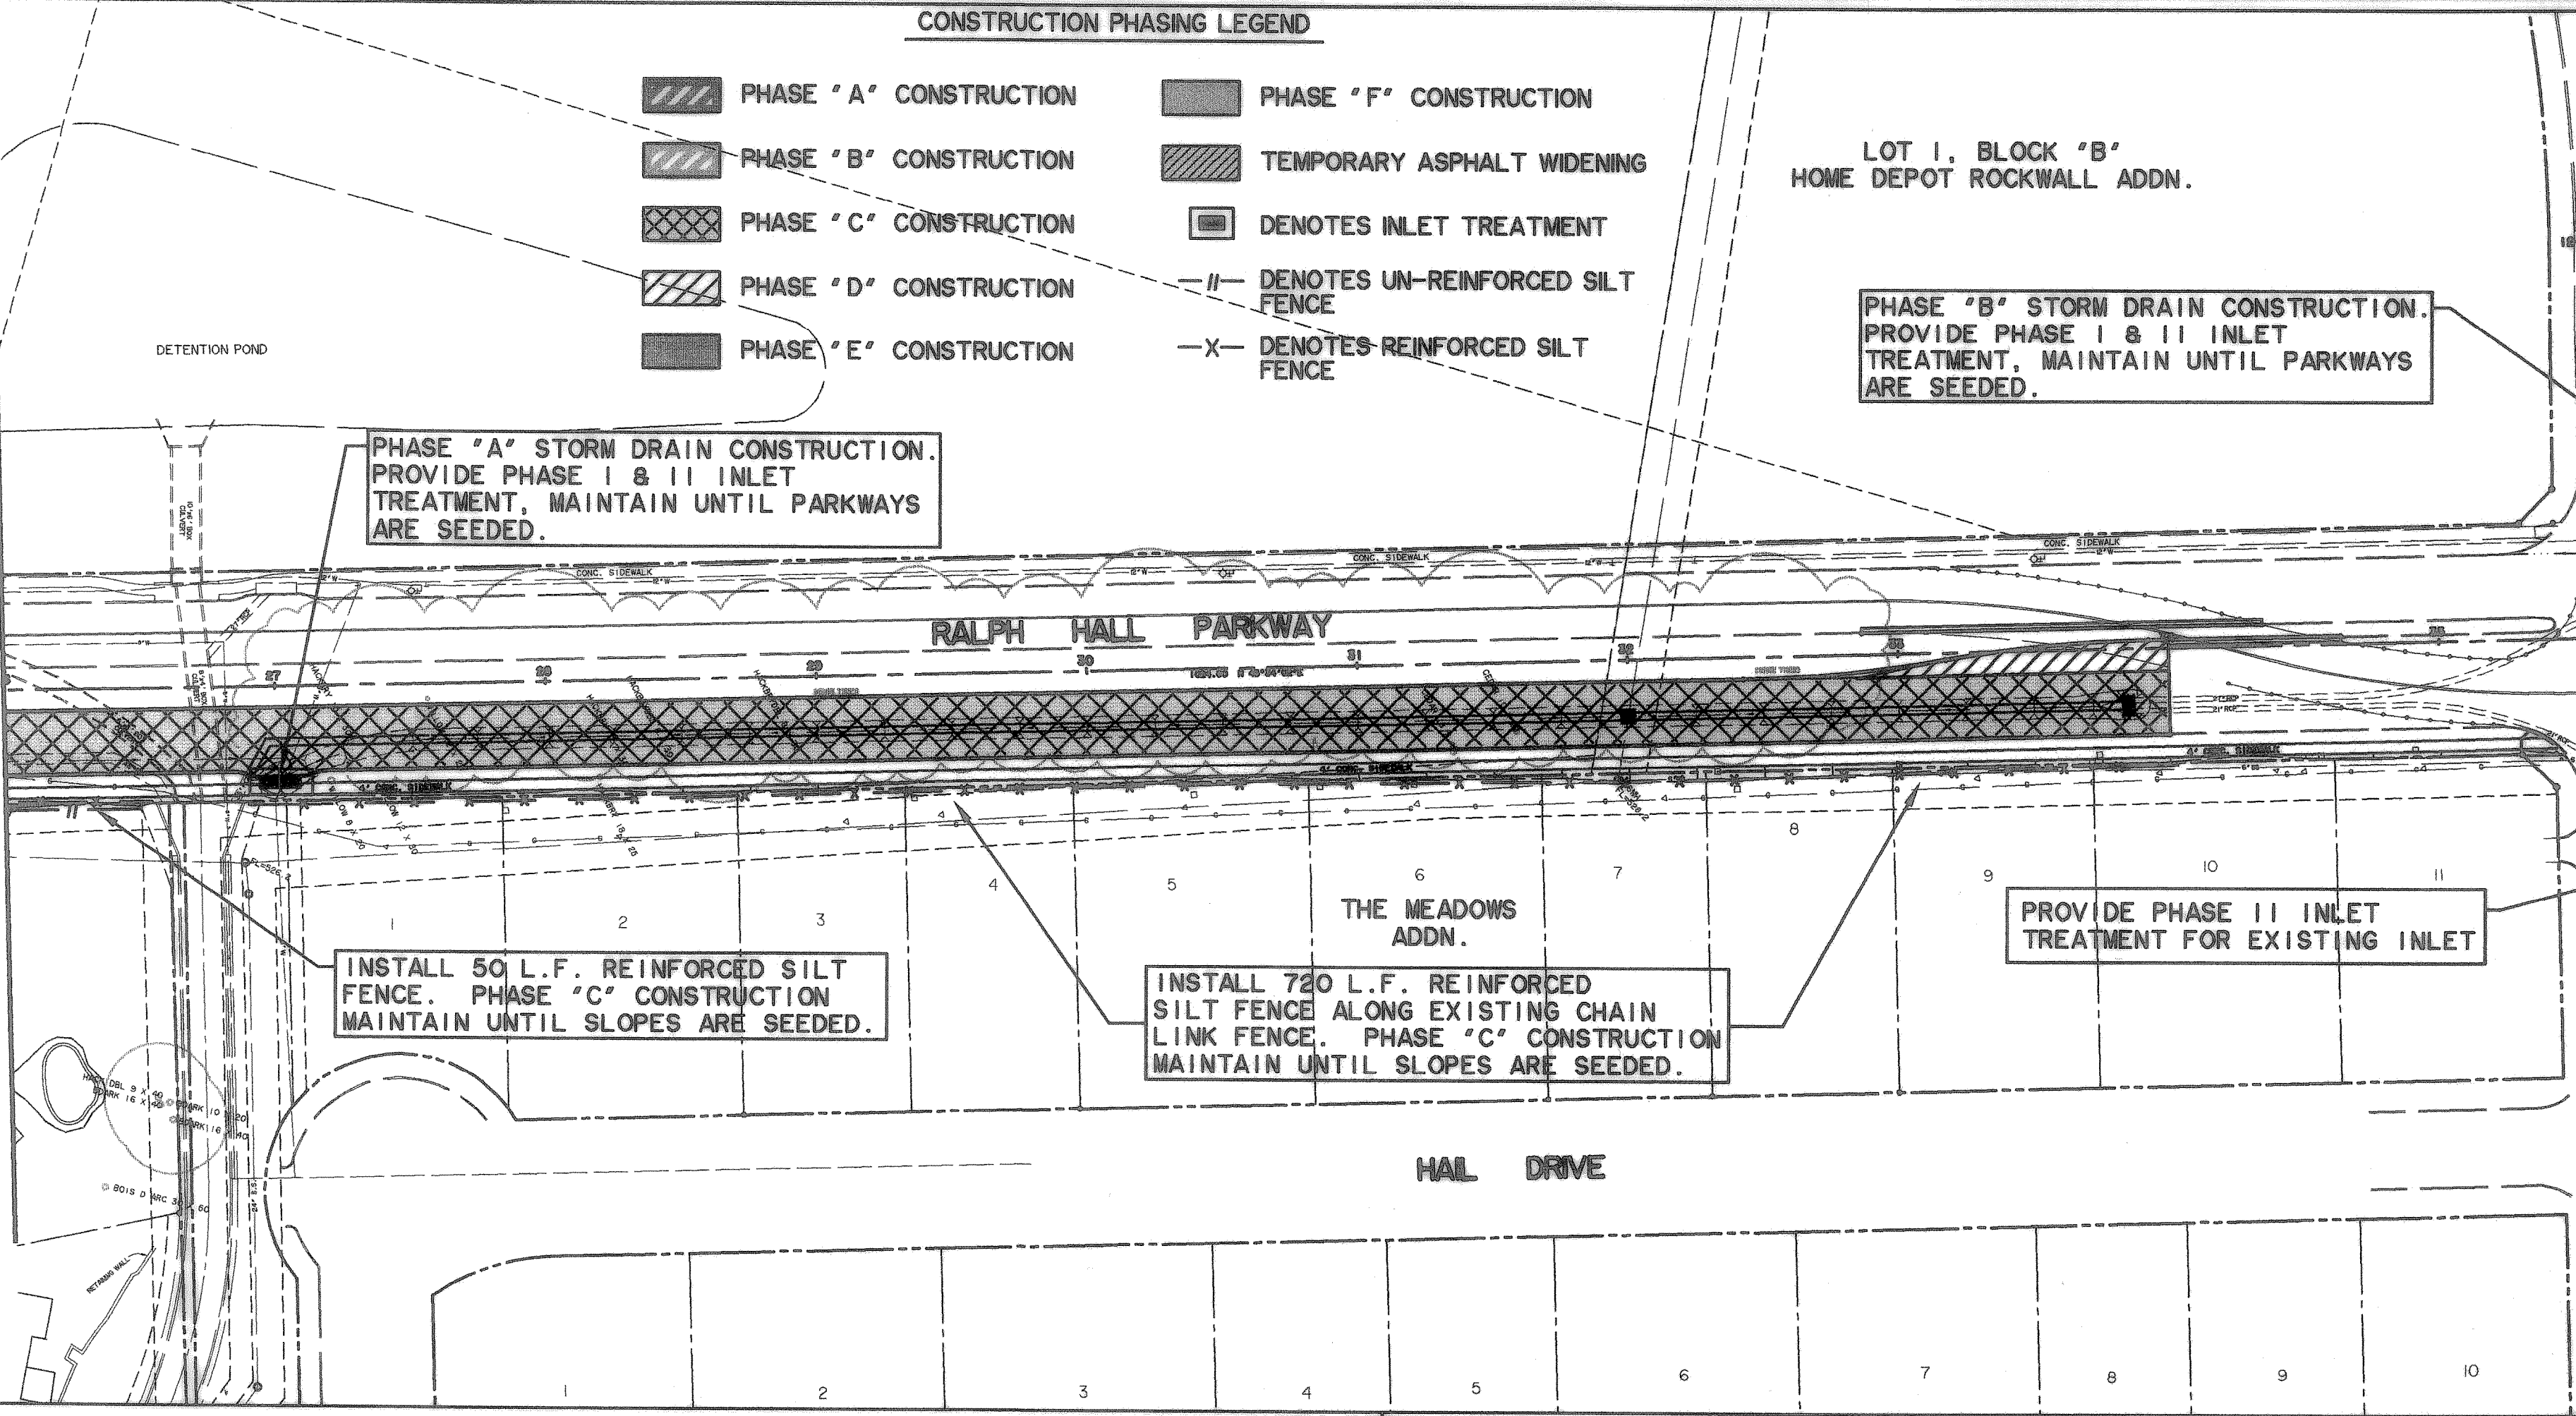

- NOTES:
- REFER TO SHEET 42 FOR CONSTRUCTION SEQUENCING NOTES.
 - PHASE "A" CONSTRUCTION PHASE SHALL BE SUBSTANTIALLY COMPLETE & OPEN TO TRAFFIC PRIOR TO BEGINNING SUBSEQUENT PHASES.
 - PHASES "C" & "D" SHALL NOT BE STARTED UNTIL PHASES "A" & "B" ARE SUBSTANTIALLY COMPLETE & OPEN TO TRAFFIC.
 - PHASES "E" & "F" SHALL NOT BEGIN PRIOR TO JUNE 10th, 2000, AFTER END OF SCHOOL YEAR.

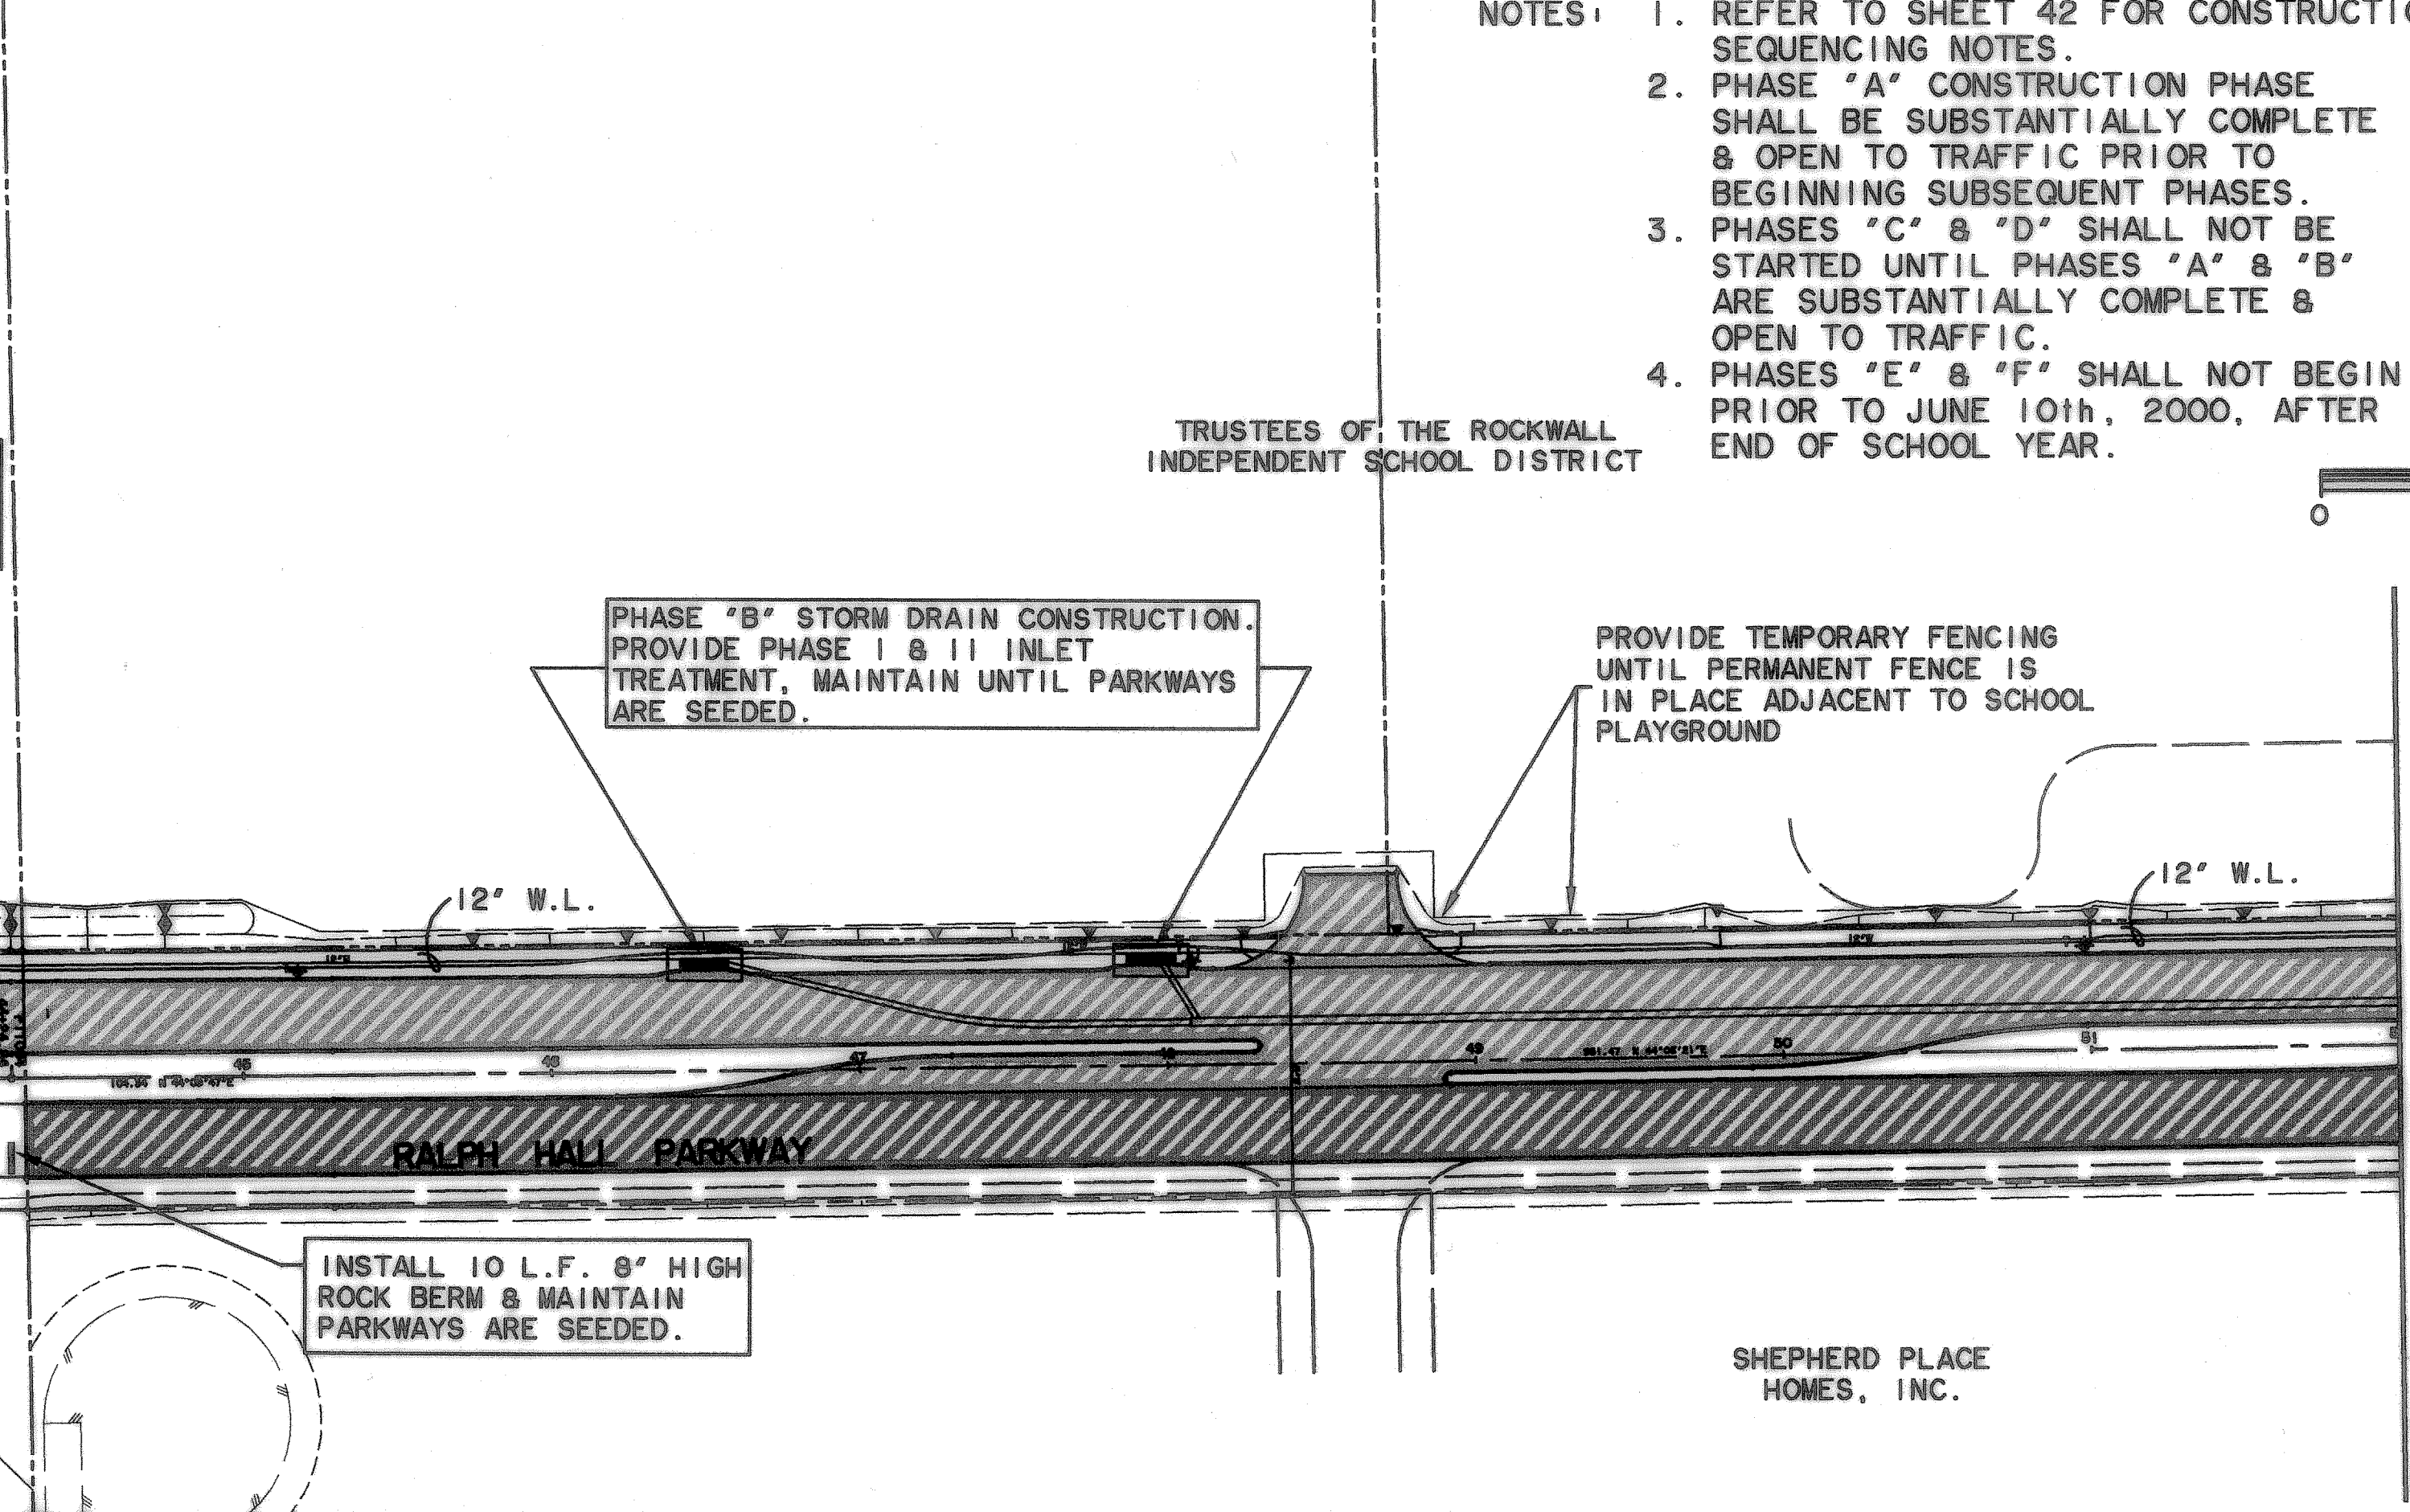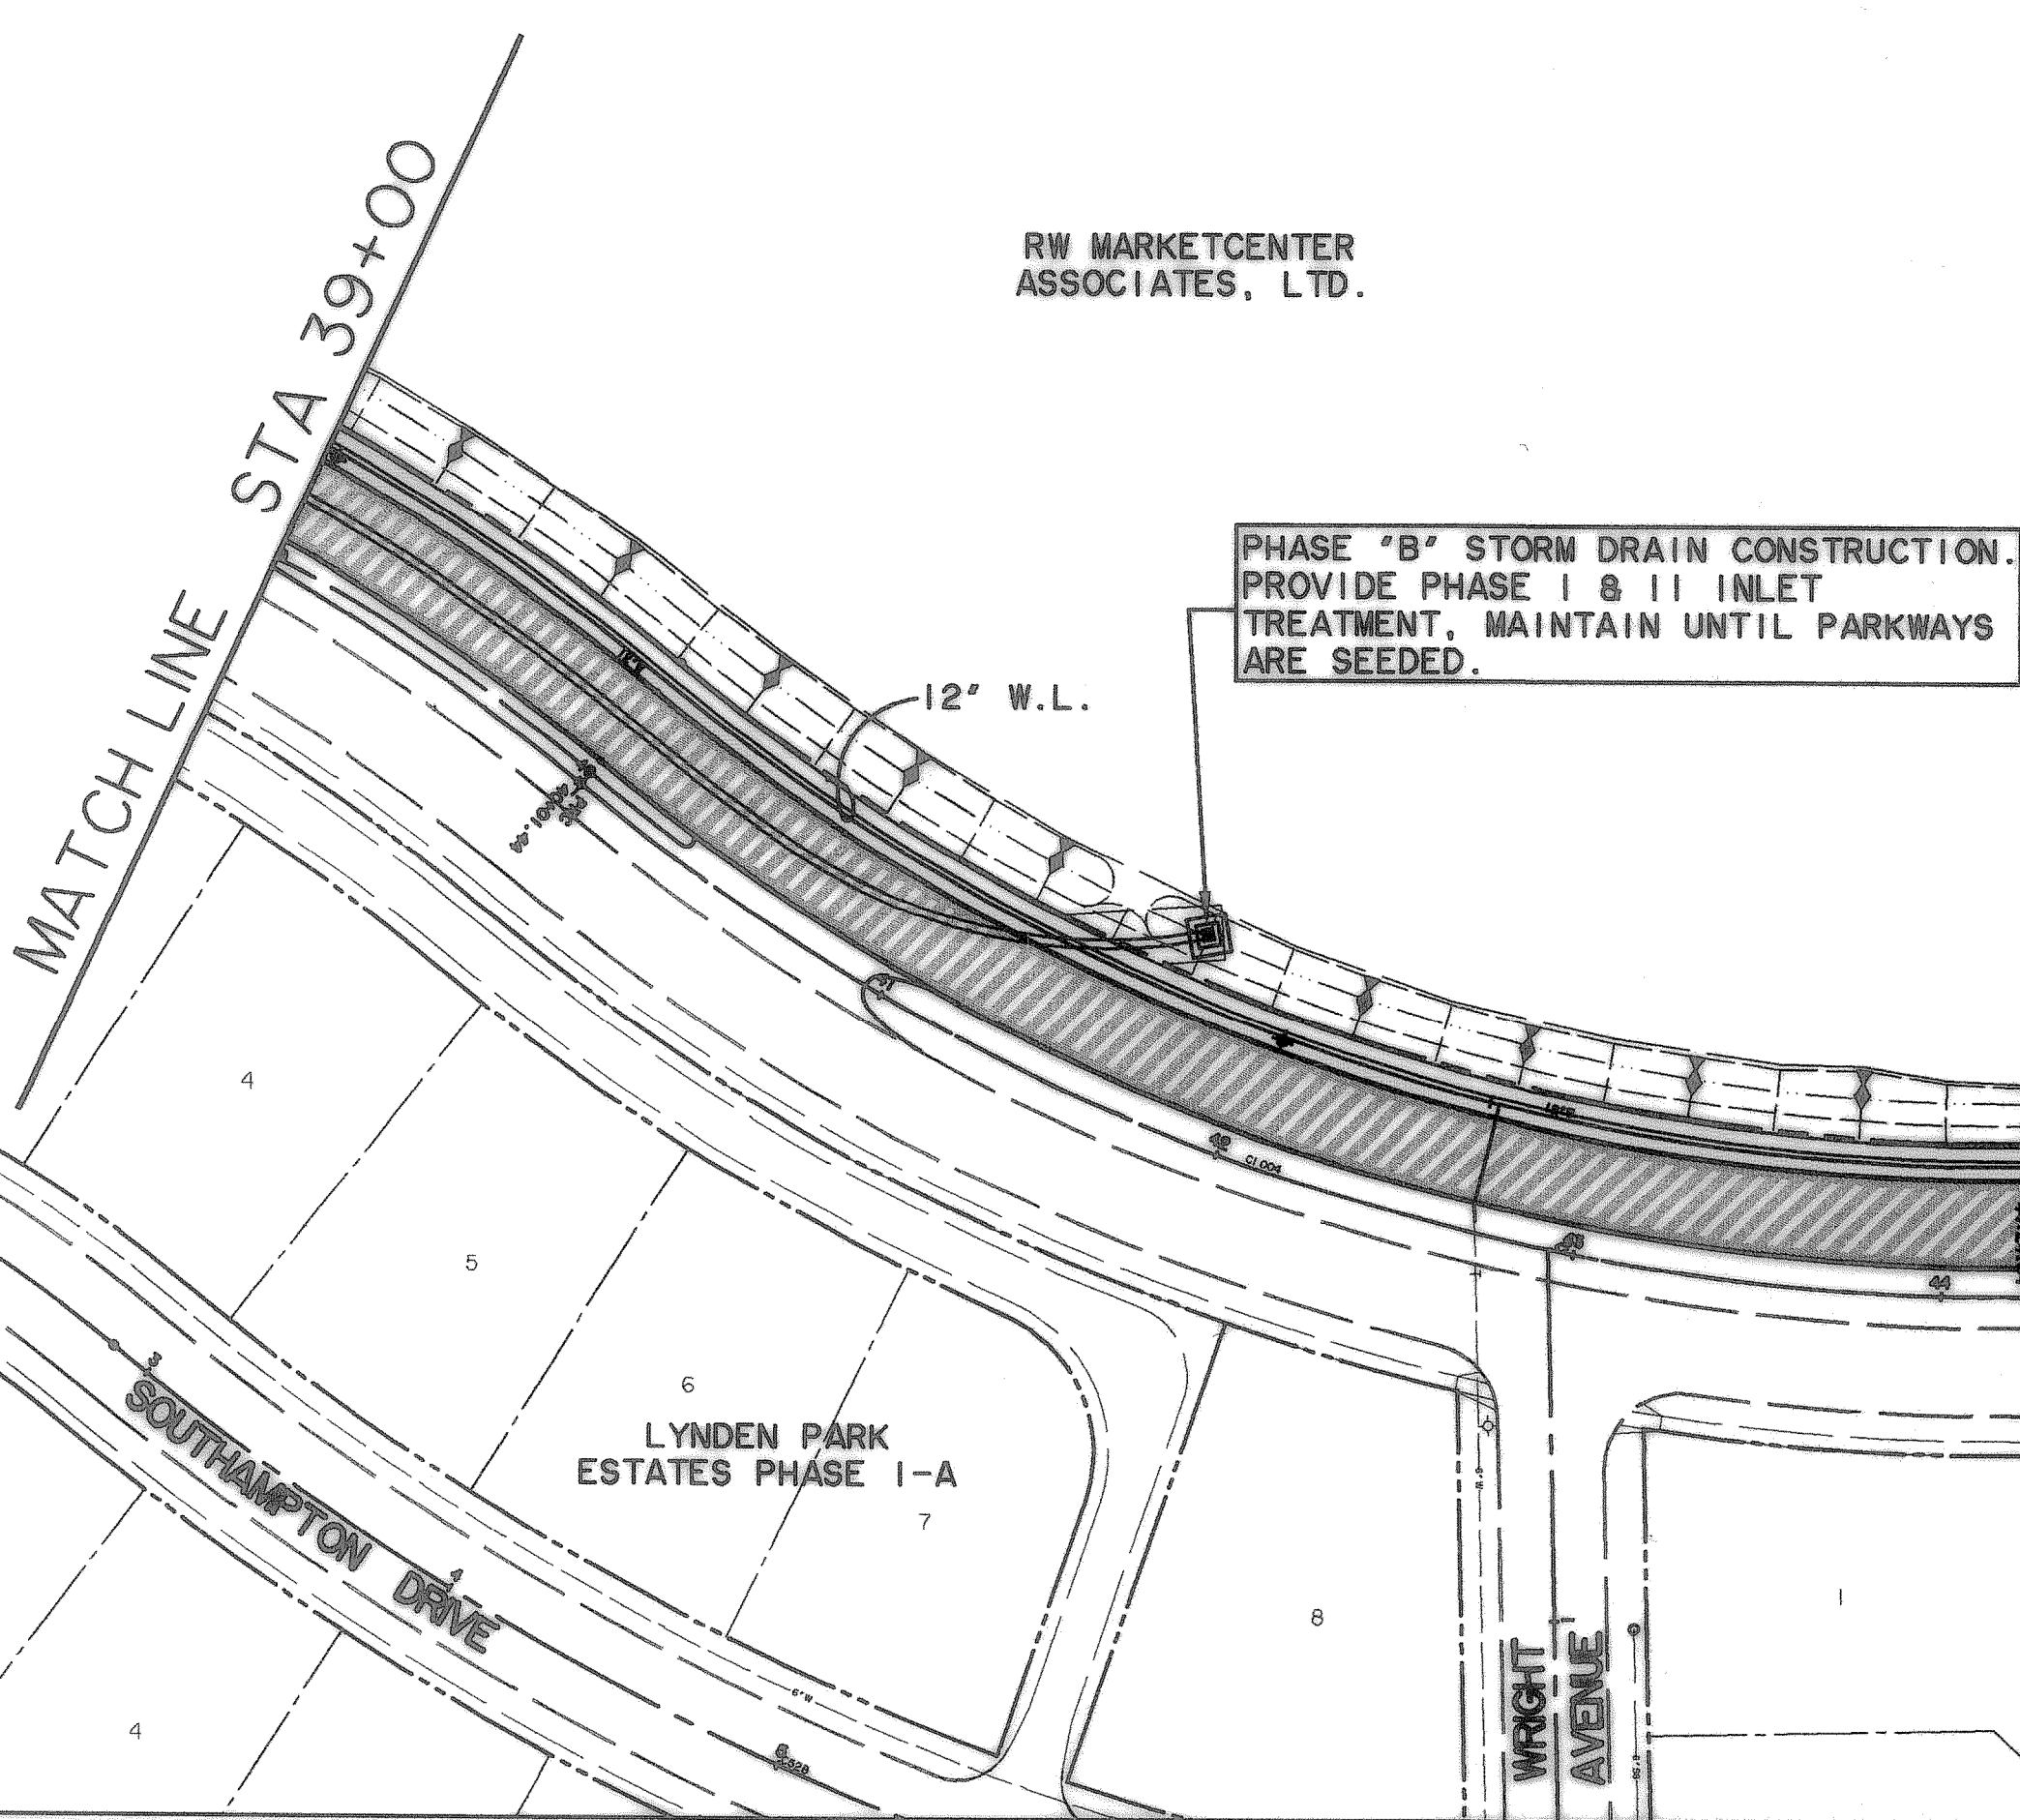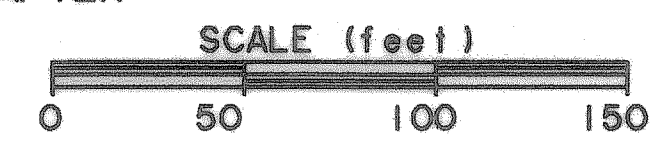

PHASE "B" STORM DRAIN CONSTRUCTION.
PROVIDE PHASE I & II INLET
TREATMENT, MAINTAIN UNTIL PARKWAYS
ARE SEEDDED.

PHASE "B" STORM DRAIN CONSTRUCTION.
PROVIDE PHASE I & II INLET
TREATMENT, MAINTAIN UNTIL PARKWAYS
ARE SEEDDED.

PROVIDE TEMPORARY FENCING
UNTIL PERMANENT FENCE IS
IN PLACE ADJACENT TO SCHOOL
PLAYGROUND

INSTALL 10 L.F. 8" HIGH
ROCK BERM & MAINTAIN
PARKWAYS ARE SEEDDED.

RW MARKETCENTER
ASSOCIATES, LTD.


TRUSTEES OF THE ROCKWALL
INDEPENDENT SCHOOL DISTRICT

SHEPHERD PLACE
HOMES, INC.


MATCH LINE STA 52+00

RECORD PLANS
1-15-02

PREPARED BY:
VIA WIER & ASSOCIATES, INC.
ENGINEERS SURVEYORS LAND PLANNERS
4300 BETHWAY PLACE SUITE 110 ARLINGTON, TEXAS 76010 METRO (817) 467-7700
4100 AUBURN CENTER BLVD. SUITE 200 FORT WORTH, TEXAS 76155 METRO (817) 355-9457

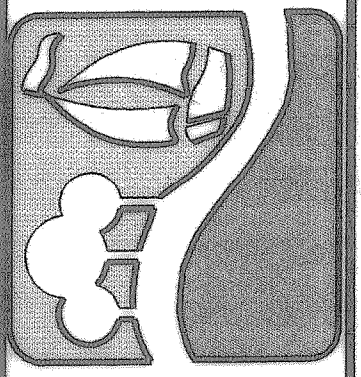

CONSTRUCTION SEQUENCE
& EROSION CONTROL PLAN
STA 26+00 TO 52+00

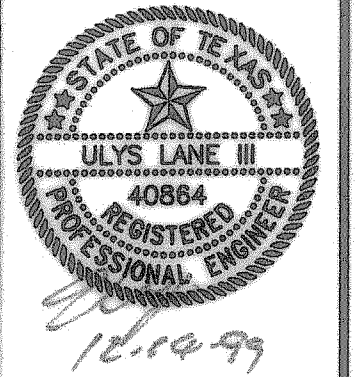

COPYRIGHT ©
WIER & ASSOCIATES, INC.
LAST SHEET EDIT
DATE 12-14-99
WAB 97057
SHEET NO.
40

TIME 16:28 FILE 1 TRAFFIC2.dwg