

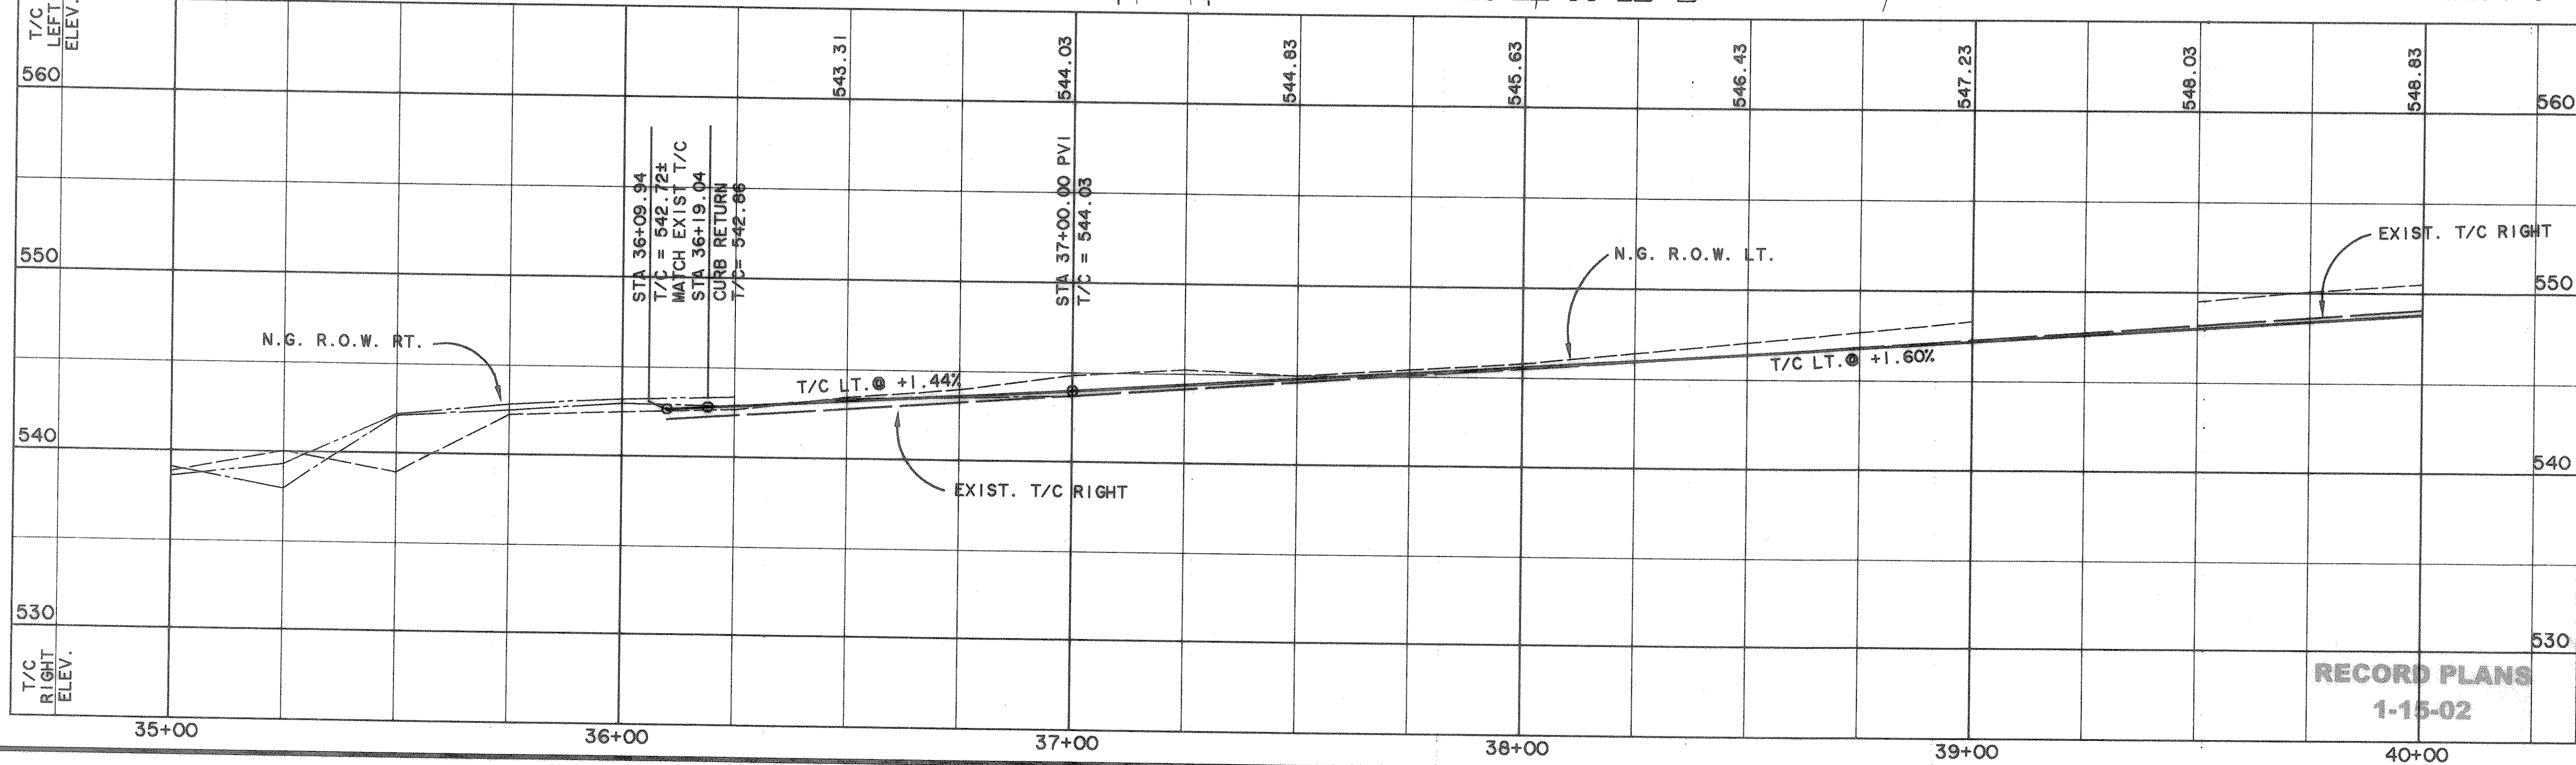
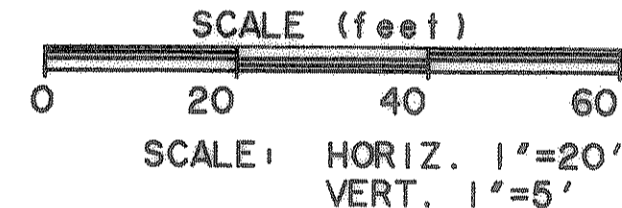


NO.	RADIUS	DELTA	ARC TANGENT	CHORD	BEARING
1100	30.00	18°39'58"	9.77	4.93	9.73 S 57°23'39"W
1124	250.00	07°46'30"	33.93	16.99	33.90 S 52°07'31"W
1125	250.00	18°35'26"	81.12	40.92	80.76 N 57°31'58"E


CURVE C1003	
A	40°51'38"
D	09°30'36"
R	602.48
T	224.42
L	429.66
E	40.44

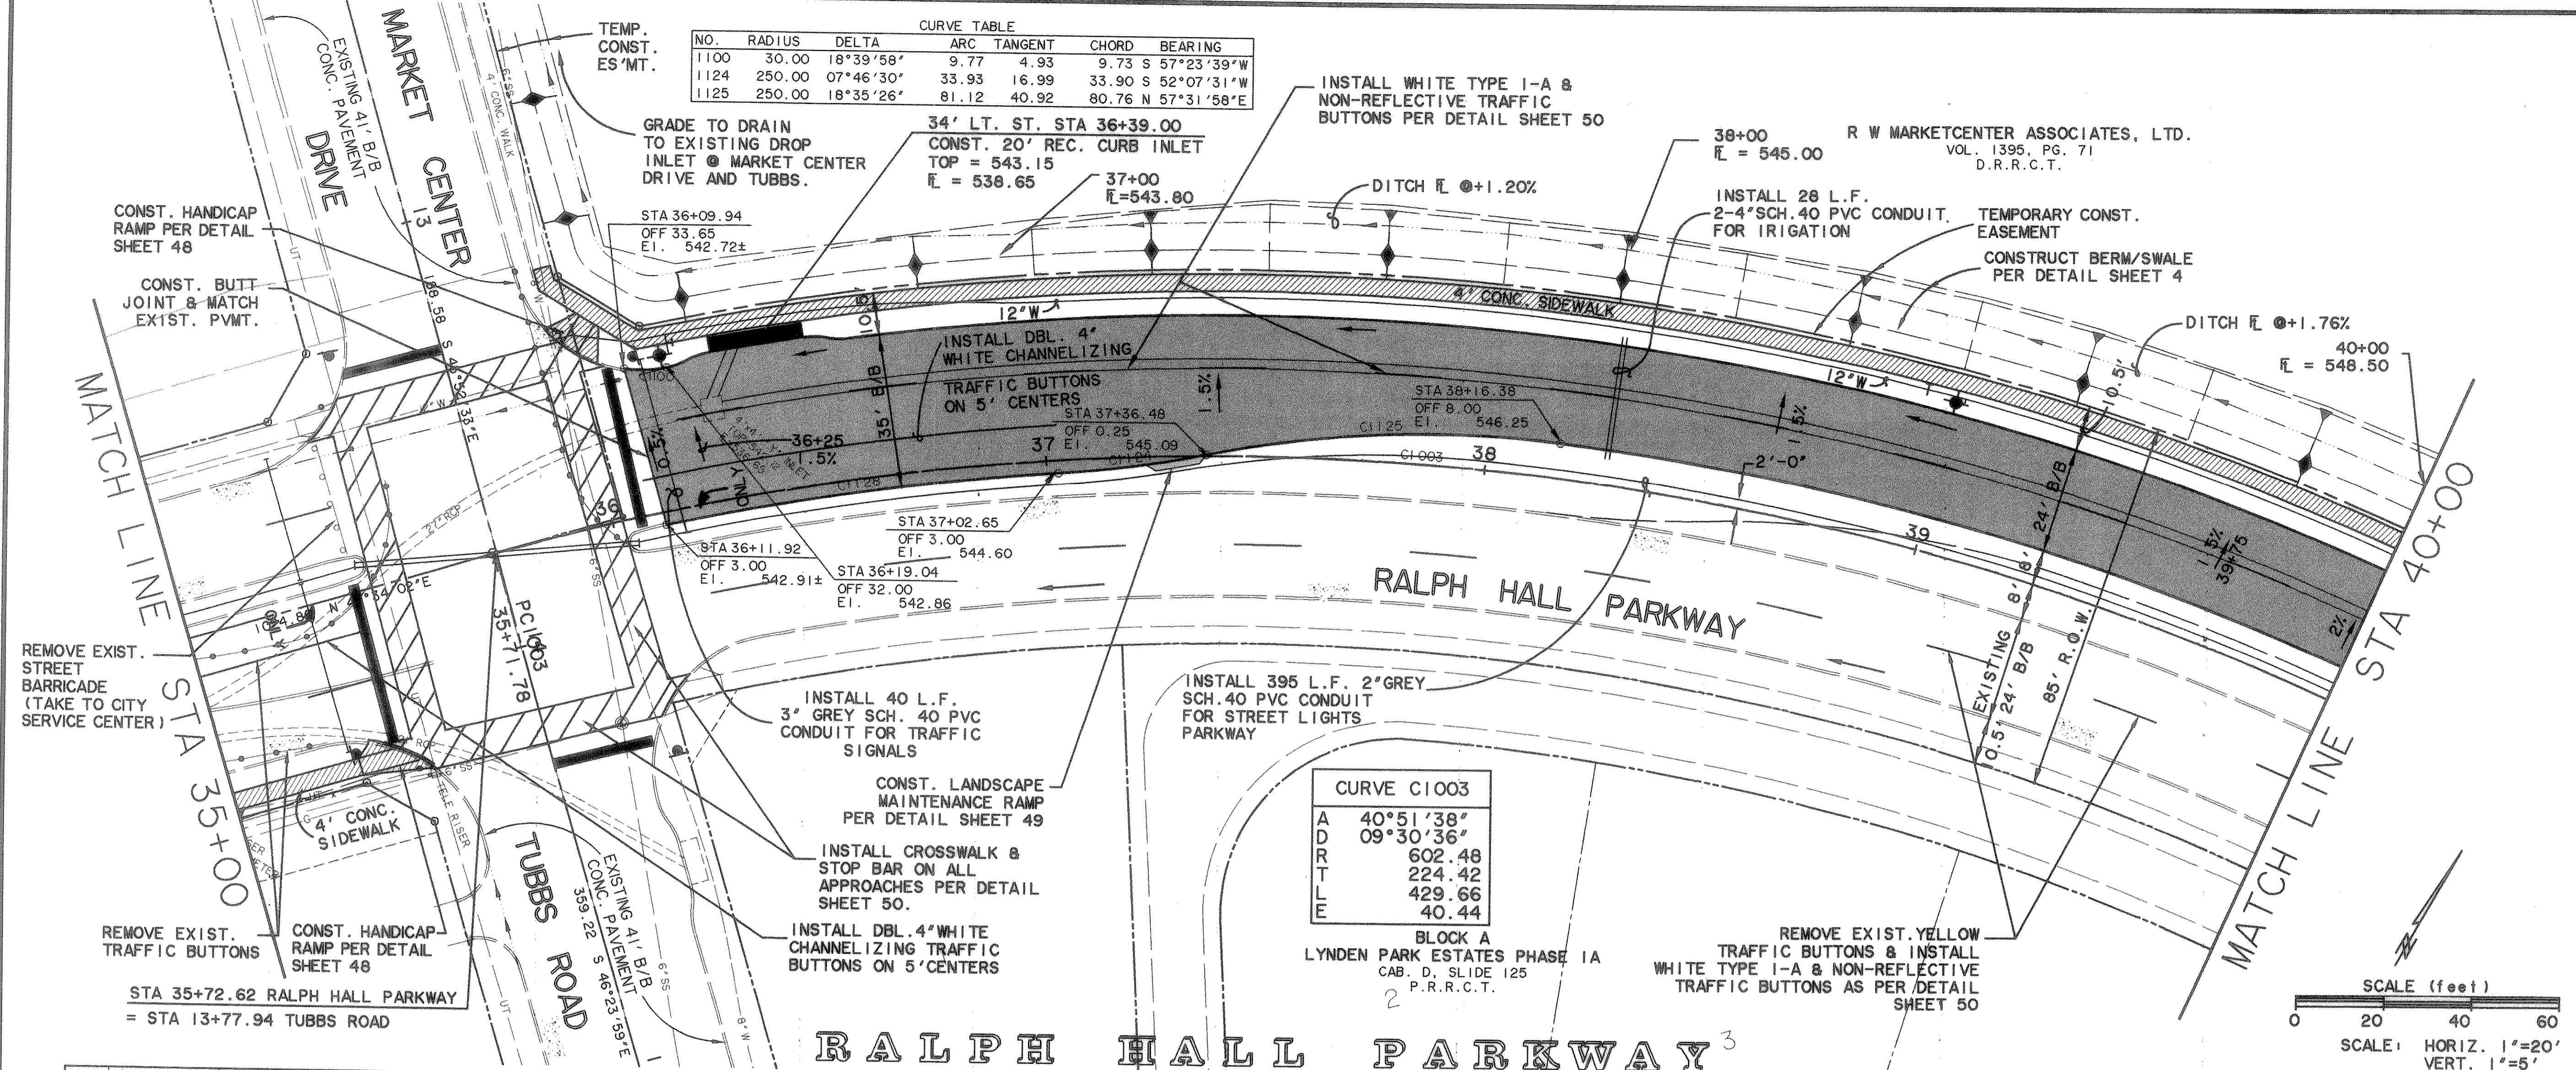

PREPARED BY:
VIA WIER & ASSOCIATES, INC.
 ENGINEERS SURVEYORS LAND PLANNERS
 4300 BELTWAY PLACE SUITE 130 ARLINGTON, TEXAS 76018 METRO (817)467-7700
 4108 AMAN CENTER BLVD. SUITE 200 FORT WORTH, TEXAS 76155 METRO (817)355-9477

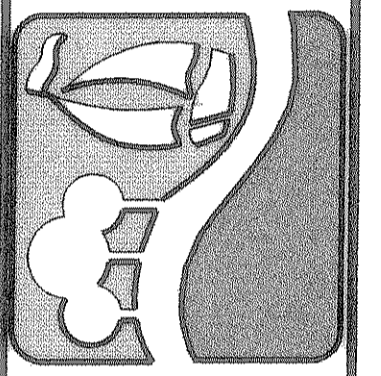

RALPH HALL PARKWAY
 PAVING PLAN & PROFILE
 STA 35+00 TO 40+00

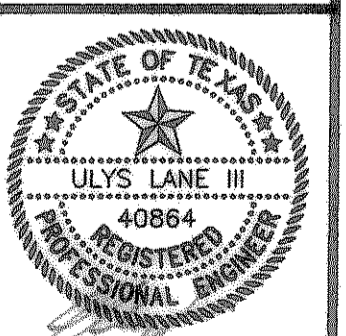

RECORD PLANS
 1-15-02
 SHEET NO. 13

TIME 8:10 FILE:PAVE18.dwg