

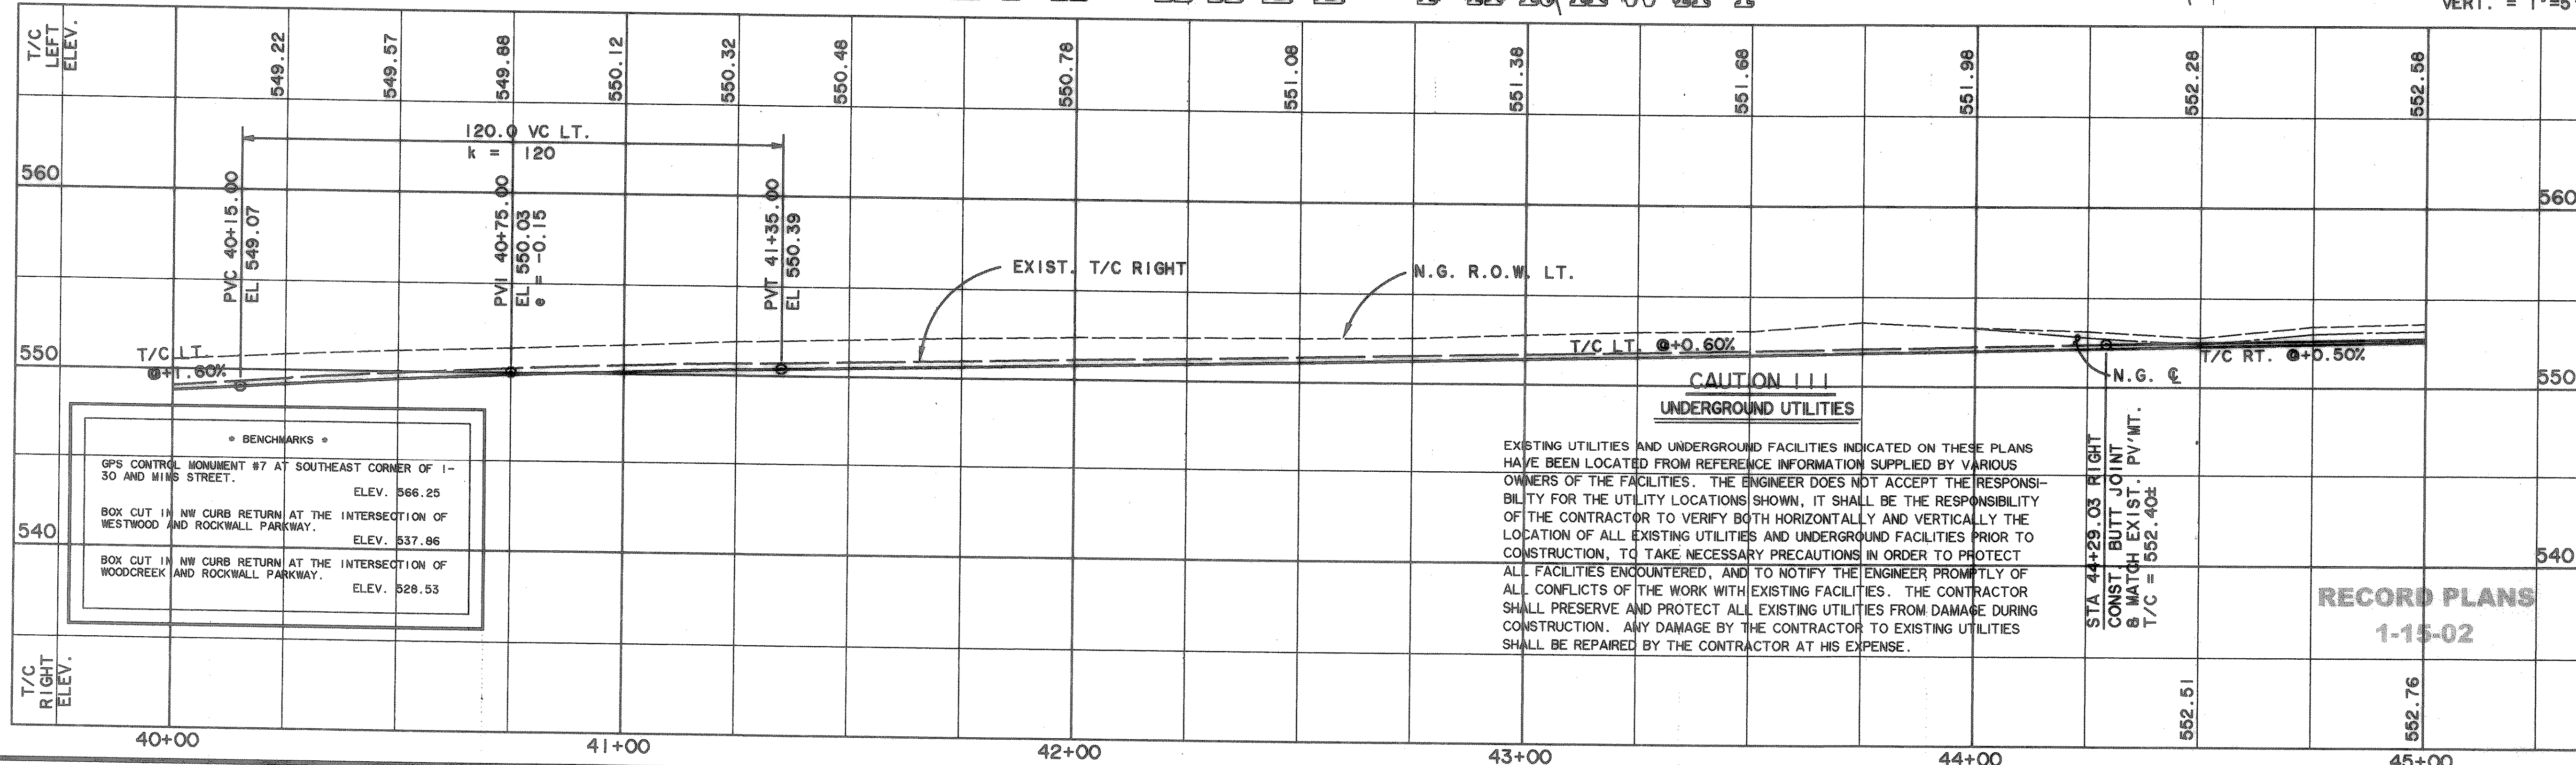
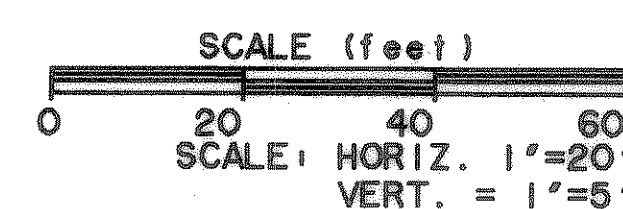


CURVE C1003	
A	40°51'38"
D	09°30'36"
R	602.48
T	224.42
L	429.66
E	40.44


CURVE C1004	
A	40°15'53"
D	09°30'36"
R	602.48
T	220.86
L	423.39
E	39.21

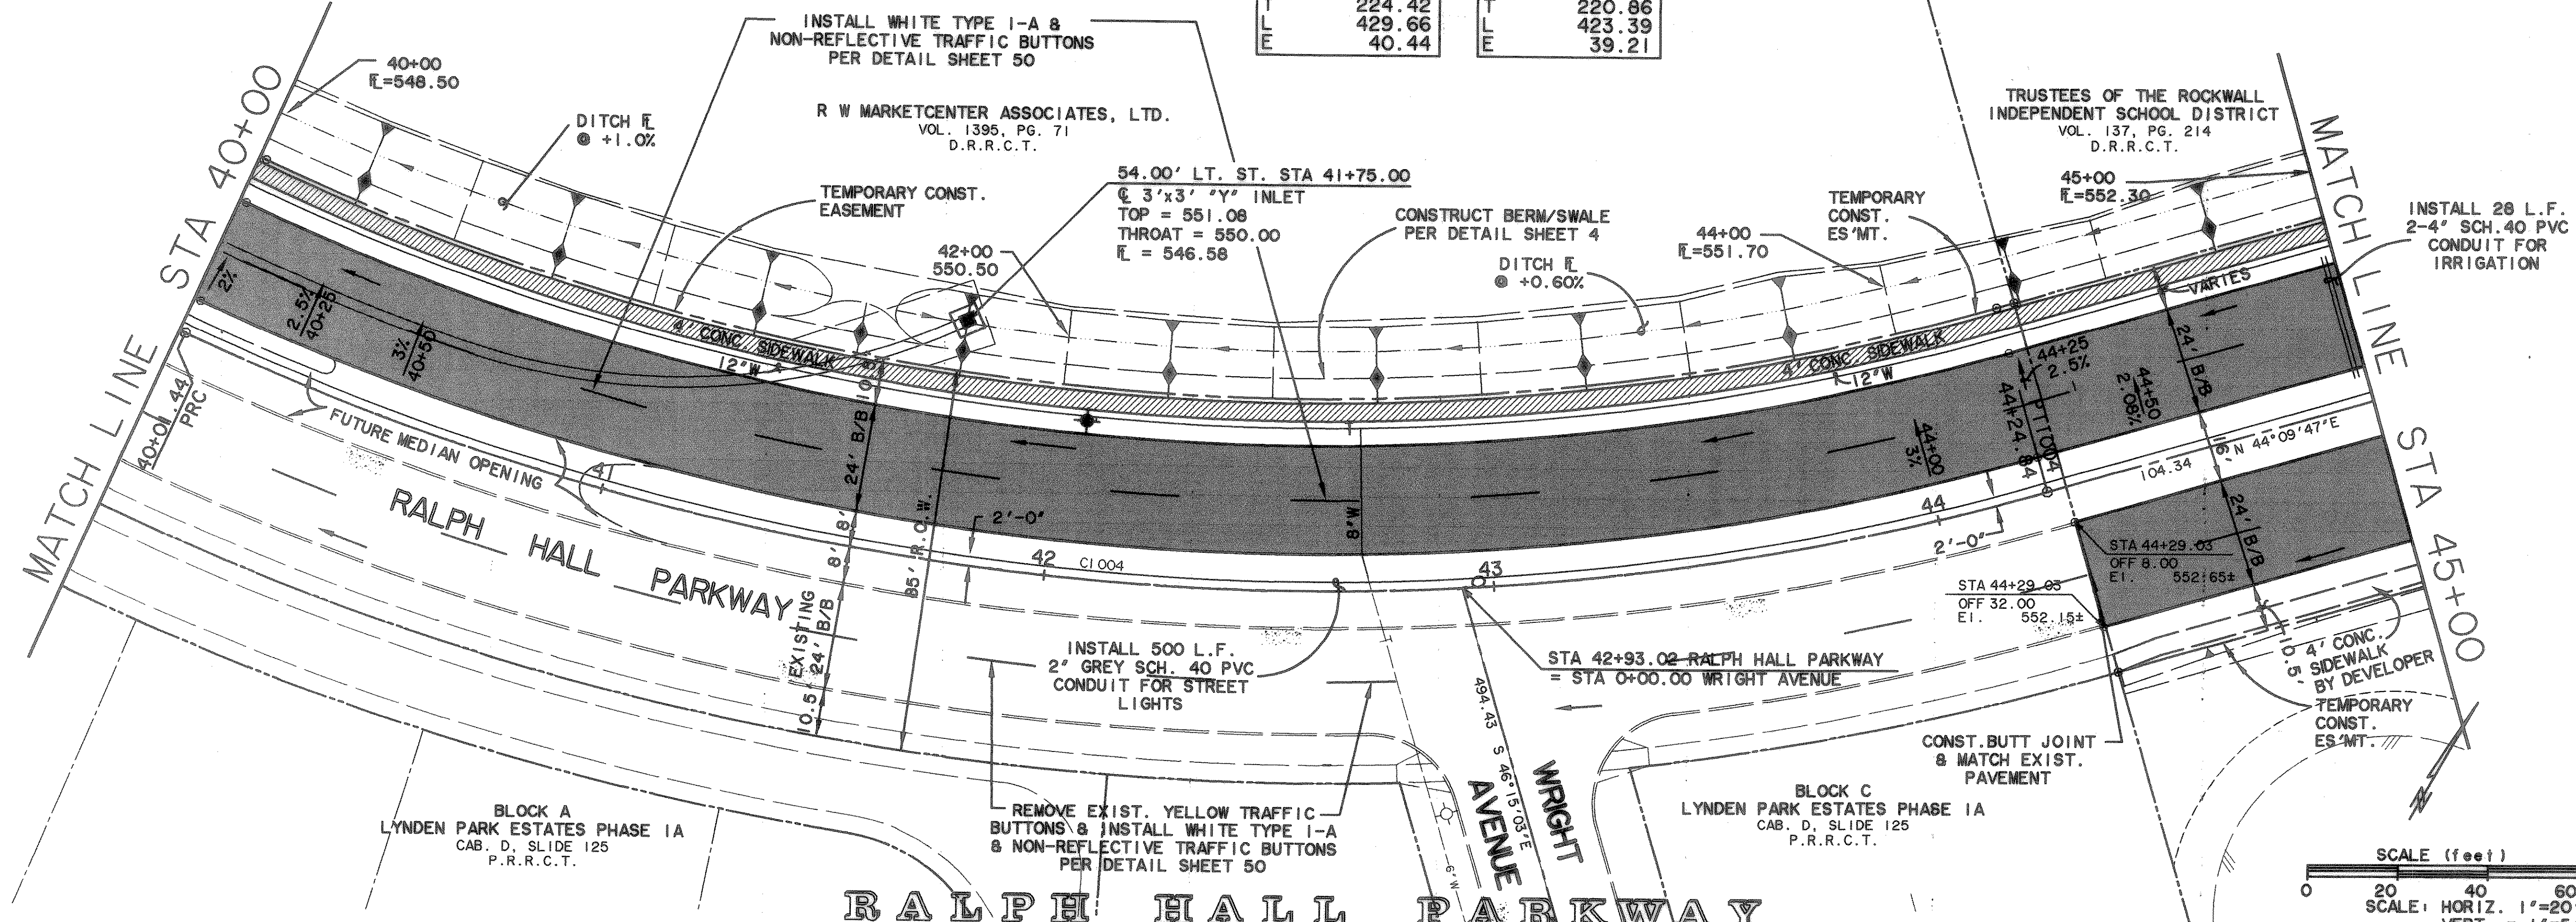

PREPARED BY:
VIA WIER & ASSOCIATES, INC.
 ENGINEERS SURVEYORS LAND PLANNERS
 4300 BELWAY PLACE, SUITE 130 ARLINGTON, TEXAS 76010 METRO (817)461-7700
 4108 AMON CENTER BLDG. SUITE 200 FORT WORTH, TEXAS 76103 METRO (817)355-9437

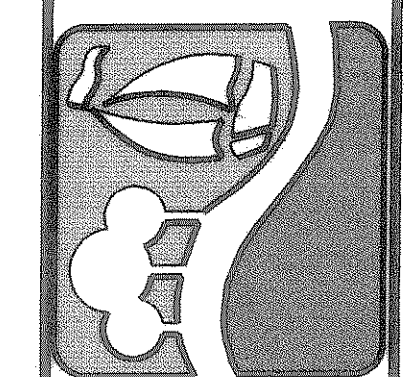

**RALPH HALL PARKWAY
 PAVING PLAN & PROFILE
 STA 40+00 TO 45+00**

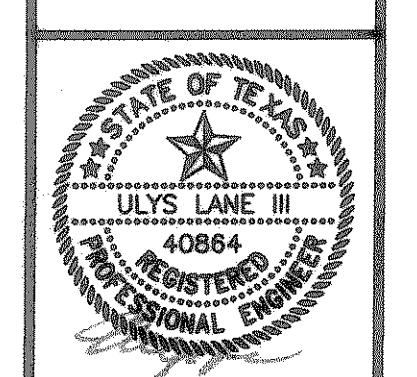

RECORD PLANS
 1-15-02
 4-10-99
 COPYRIGHT ©
 WIER & ASSOCIATES, INC.
 LAST SHEET EDIT
 DATE 06-09-99
 WA# 97067
SHEET NO. 14

TIME 08:18 FILE:PAVE09.dwg