



CURVE TABLE						
NO.	RADIUS	DELTA	ARC	TANGENT	CHORD	BEARING
1103	30.00	90°03'49"	47.16	30.03	42.45	S 00°55'33"E
1119	30.00	89°56'11"	47.09	29.97	42.40	N 89°04'27"E
1122	250.00	12°34'41"	54.88	27.55	54.77	N 37°49'01"E
1123	250.00	12°34'41"	54.88	27.55	54.77	S 37°49'01"W
1153	250.00	12°34'41"	54.88	27.55	54.77	S 37°49'01"W
1154	250.00	12°34'41"	54.88	27.55	54.77	N 37°49'01"E

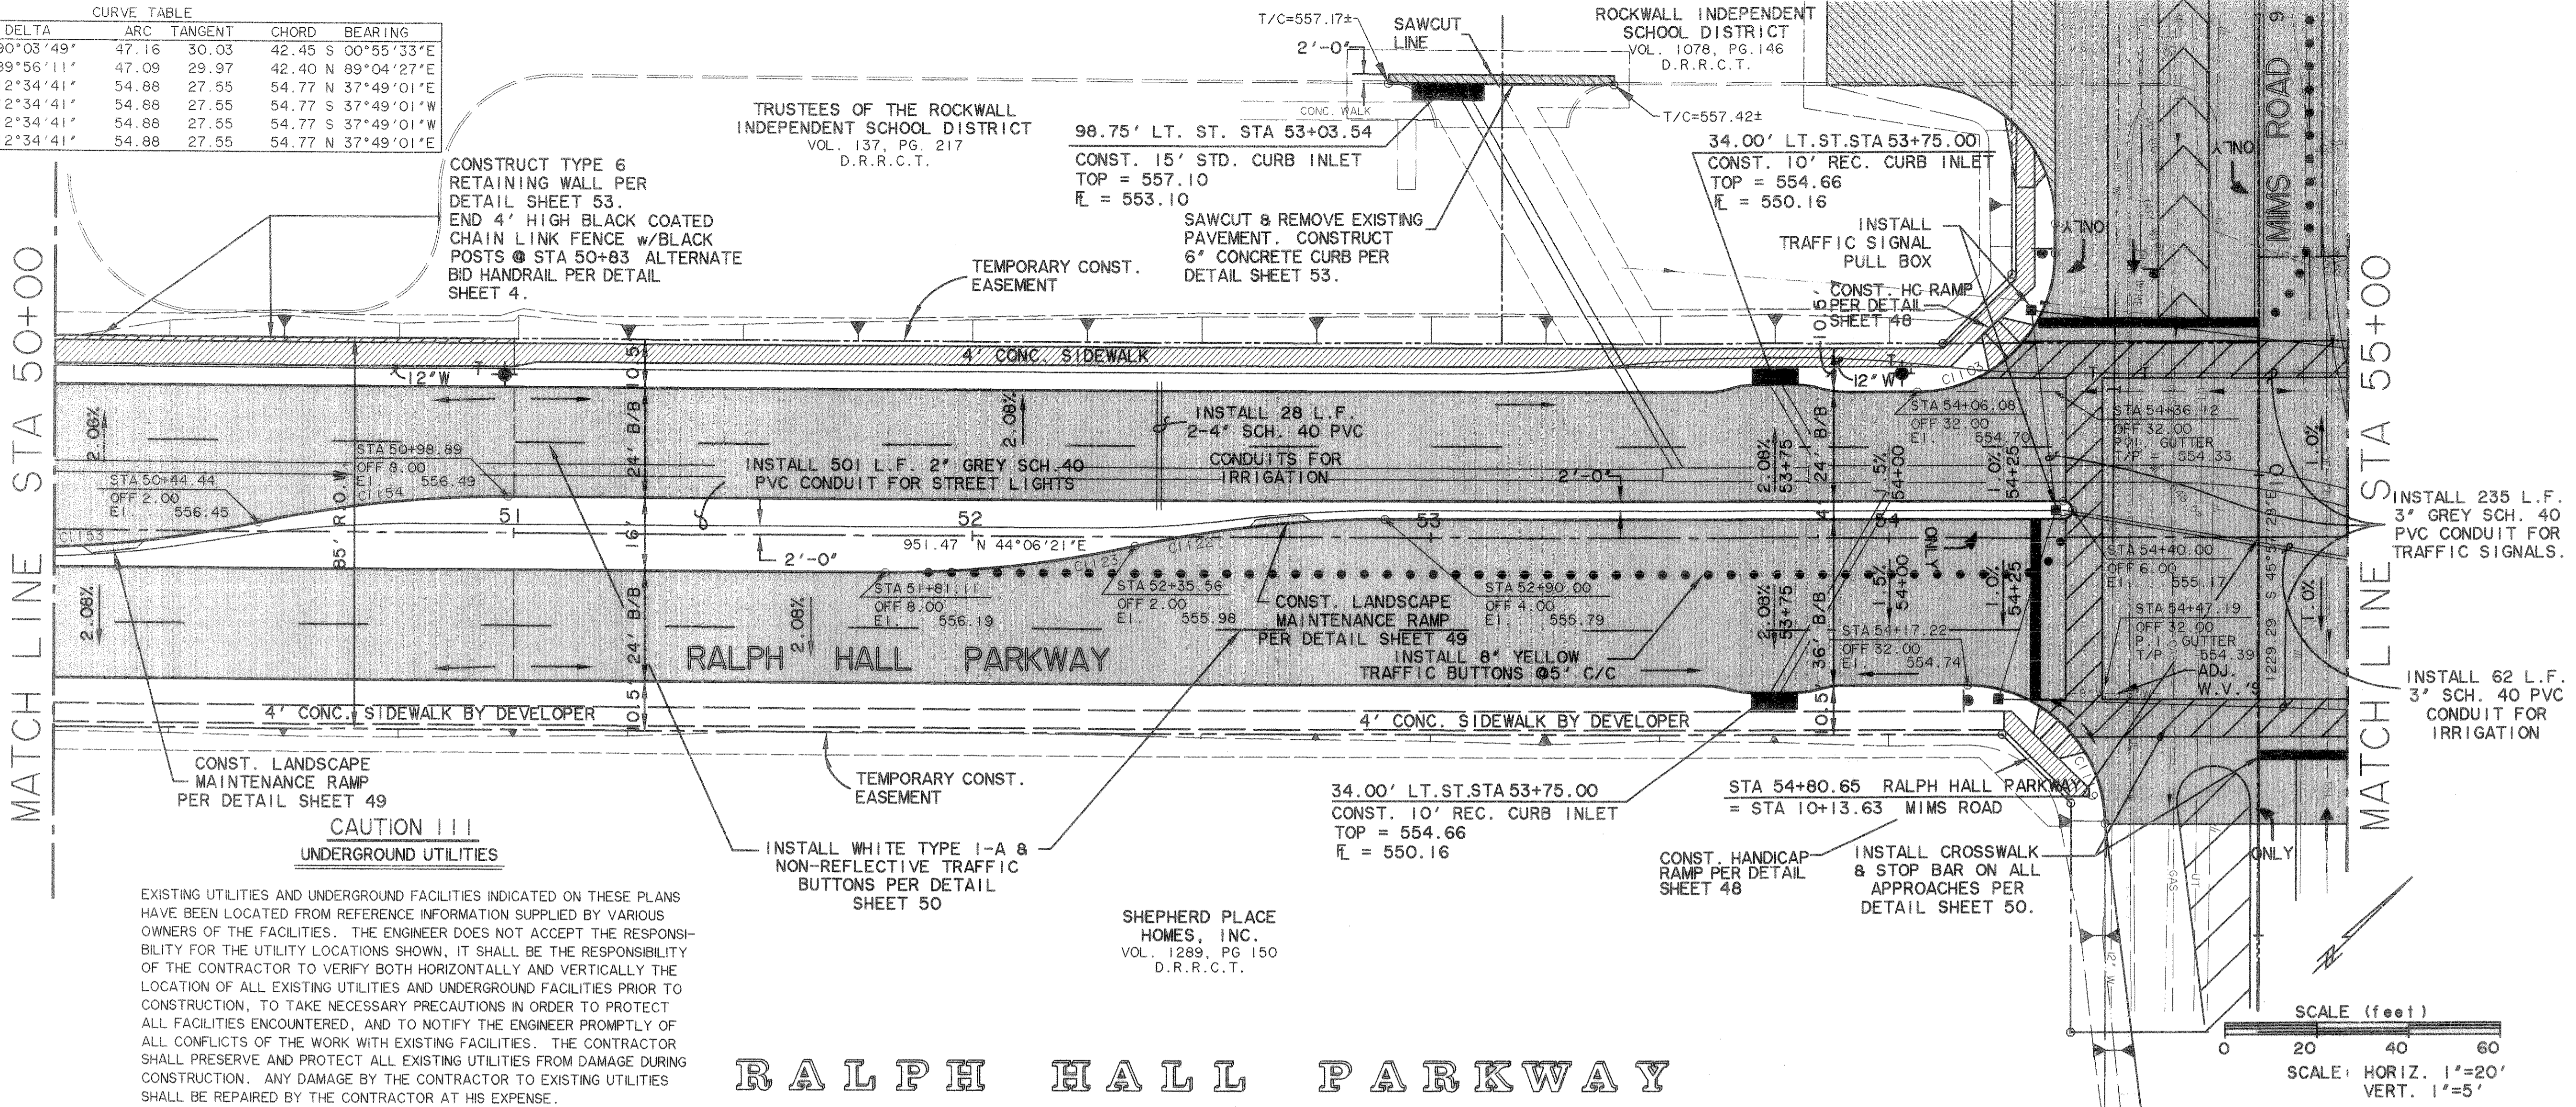


EXISTING UTILITIES AND UNDERGROUND FACILITIES INDICATED ON THESE PLANS HAVE BEEN LOCATED FROM REFERENCE INFORMATION SUPPLIED BY VARIOUS OWNERS OF THE FACILITIES. THE ENGINEER DOES NOT ACCEPT THE RESPONSIBILITY FOR THE UTILITY LOCATIONS SHOWN, IT SHALL BE THE RESPONSIBILITY OF THE CONTRACTOR TO VERIFY BOTH HORIZONTALLY AND VERTICALLY THE LOCATION OF ALL EXISTING UTILITIES AND UNDERGROUND FACILITIES PRIOR TO CONSTRUCTION, TO TAKE NECESSARY PRECAUTIONS IN ORDER TO PROTECT ALL FACILITIES ENCOUNTERED, AND TO NOTIFY THE ENGINEER PROMPTLY OF ALL CONFLICTS OF THE WORK WITH EXISTING FACILITIES. THE CONTRACTOR SHALL PRESERVE AND PROTECT ALL EXISTING UTILITIES FROM DAMAGE DURING CONSTRUCTION. ANY DAMAGE BY THE CONTRACTOR TO EXISTING UTILITIES SHALL BE REPAIRED BY THE CONTRACTOR AT HIS EXPENSE.


RALPH HALL PARKWAY

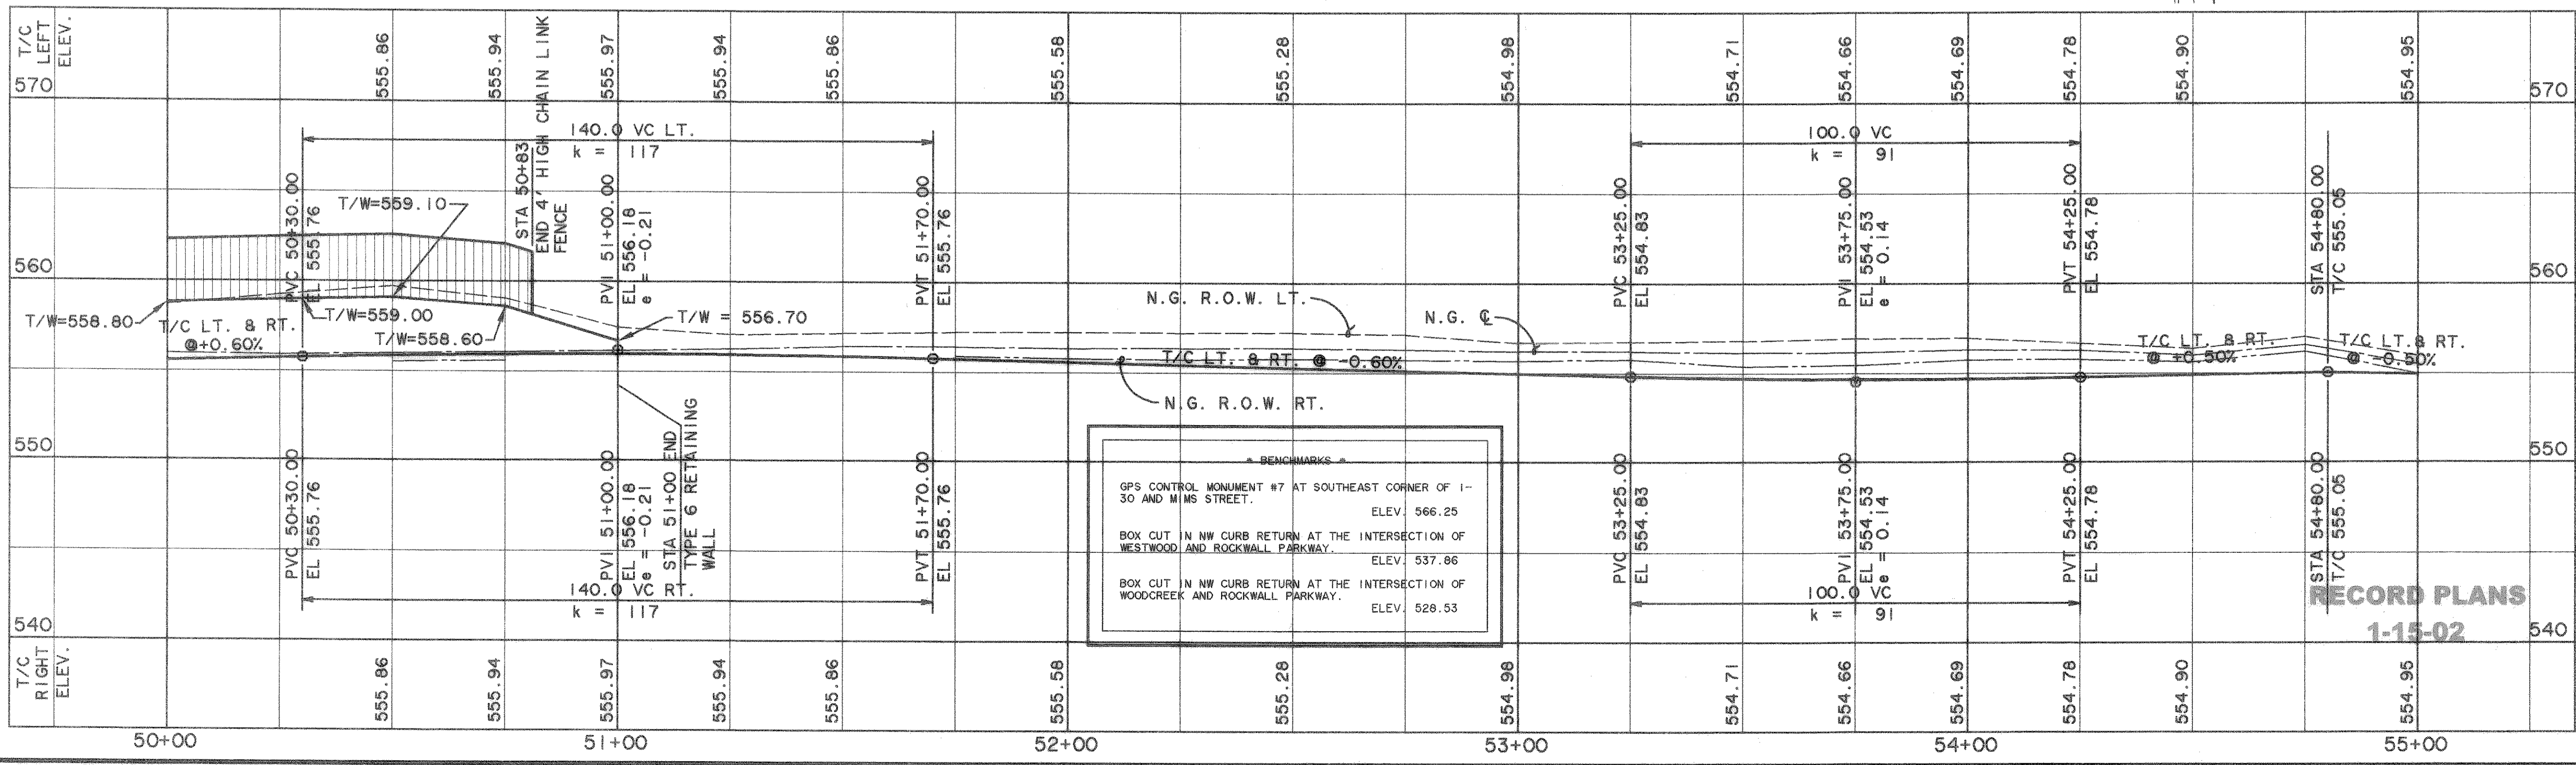

PREPARED BY:
VIA WIER & ASSOCIATES, INC.
 ENGINEERS SURVEYORS LAND PLANNERS
 4300 BELWAY PLACE SUITE 130 ARLINGTON, TEXAS 76010 METRO (817)461-7700
 4108 AMON CREEK ROAD, SUITE 200 FORT WORTH, TEXAS 76155 METRO (817)355-4437

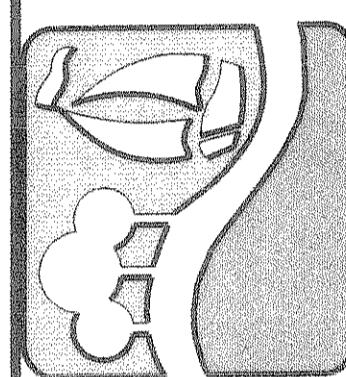

RALPH HALL PARKWAY
 PAVING PLAN & PROFILE
 STA 50+00 TO 55+00

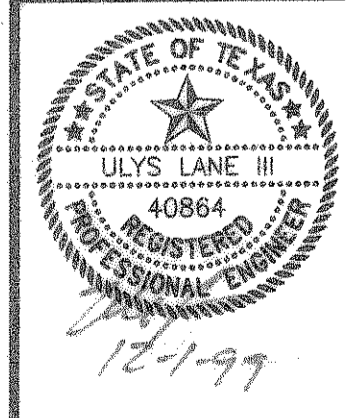

COPYRIGHT ©
 WIER & ASSOCIATES, INC.
 LAST SHEET EDIT
 DATE 11-29-98
 W.A.# 97057
SHEET NO.
 16

TIME 14.44 FILE: PAVE21.dwg

RECORD PLANS
 1-15-02