
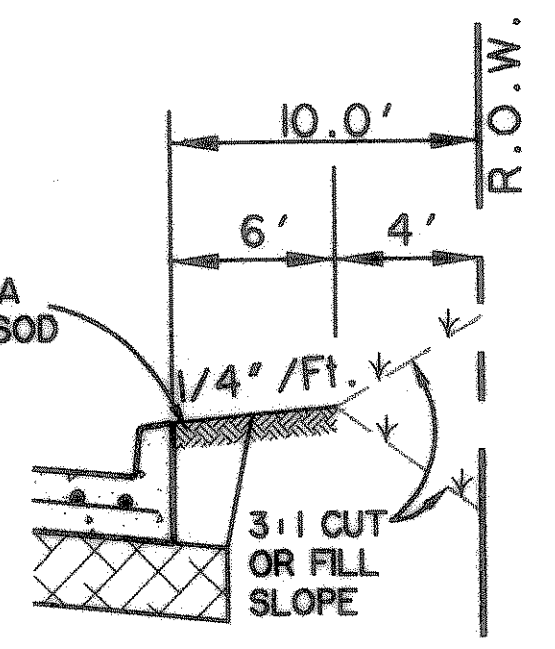


F.M. 3097 - HORIZON ROAD

• BENCHMARKS •
 GPS CONTROL MONUMENT #7 AT SOUTHEAST CORNER OF 1-30 AND MIMS STREET. ELEV. 566.25
 BOX CUT IN NW CURB RETURN AT THE INTERSECTION OF WESTWOOD AND ROCKWALL PARKWAY. ELEV. 537.86
 BOX CUT IN NW CURB RETURN AT THE INTERSECTION OF WOODCREEK AND ROCKWALL PARKWAY. ELEV. 528.53

CURVE	RADIUS	LENGTH	TANGENT	CHORD	BEARING	DELTA
C5	30.00'	47.09'	29.96'	42.40'	N00°48'56"W	89°55'38"
C8	471.75'	75.32'	37.74'	75.24'	N39°34'27"E	09°08'52"
C9	471.75'	75.32'	37.74'	75.24'	N39°34'27"E	09°08'52"
C30	50.00'	26.12'	13.36'	25.82'	N59°06'40"E	29°55'36"
C31	50.00'	26.12'	13.36'	25.82'	S29°11'05"W	29°55'36"

740/3099 LIMITED PARTNERSHIP
 VOL. 620, PG. 69
 D.R.R.C.T.

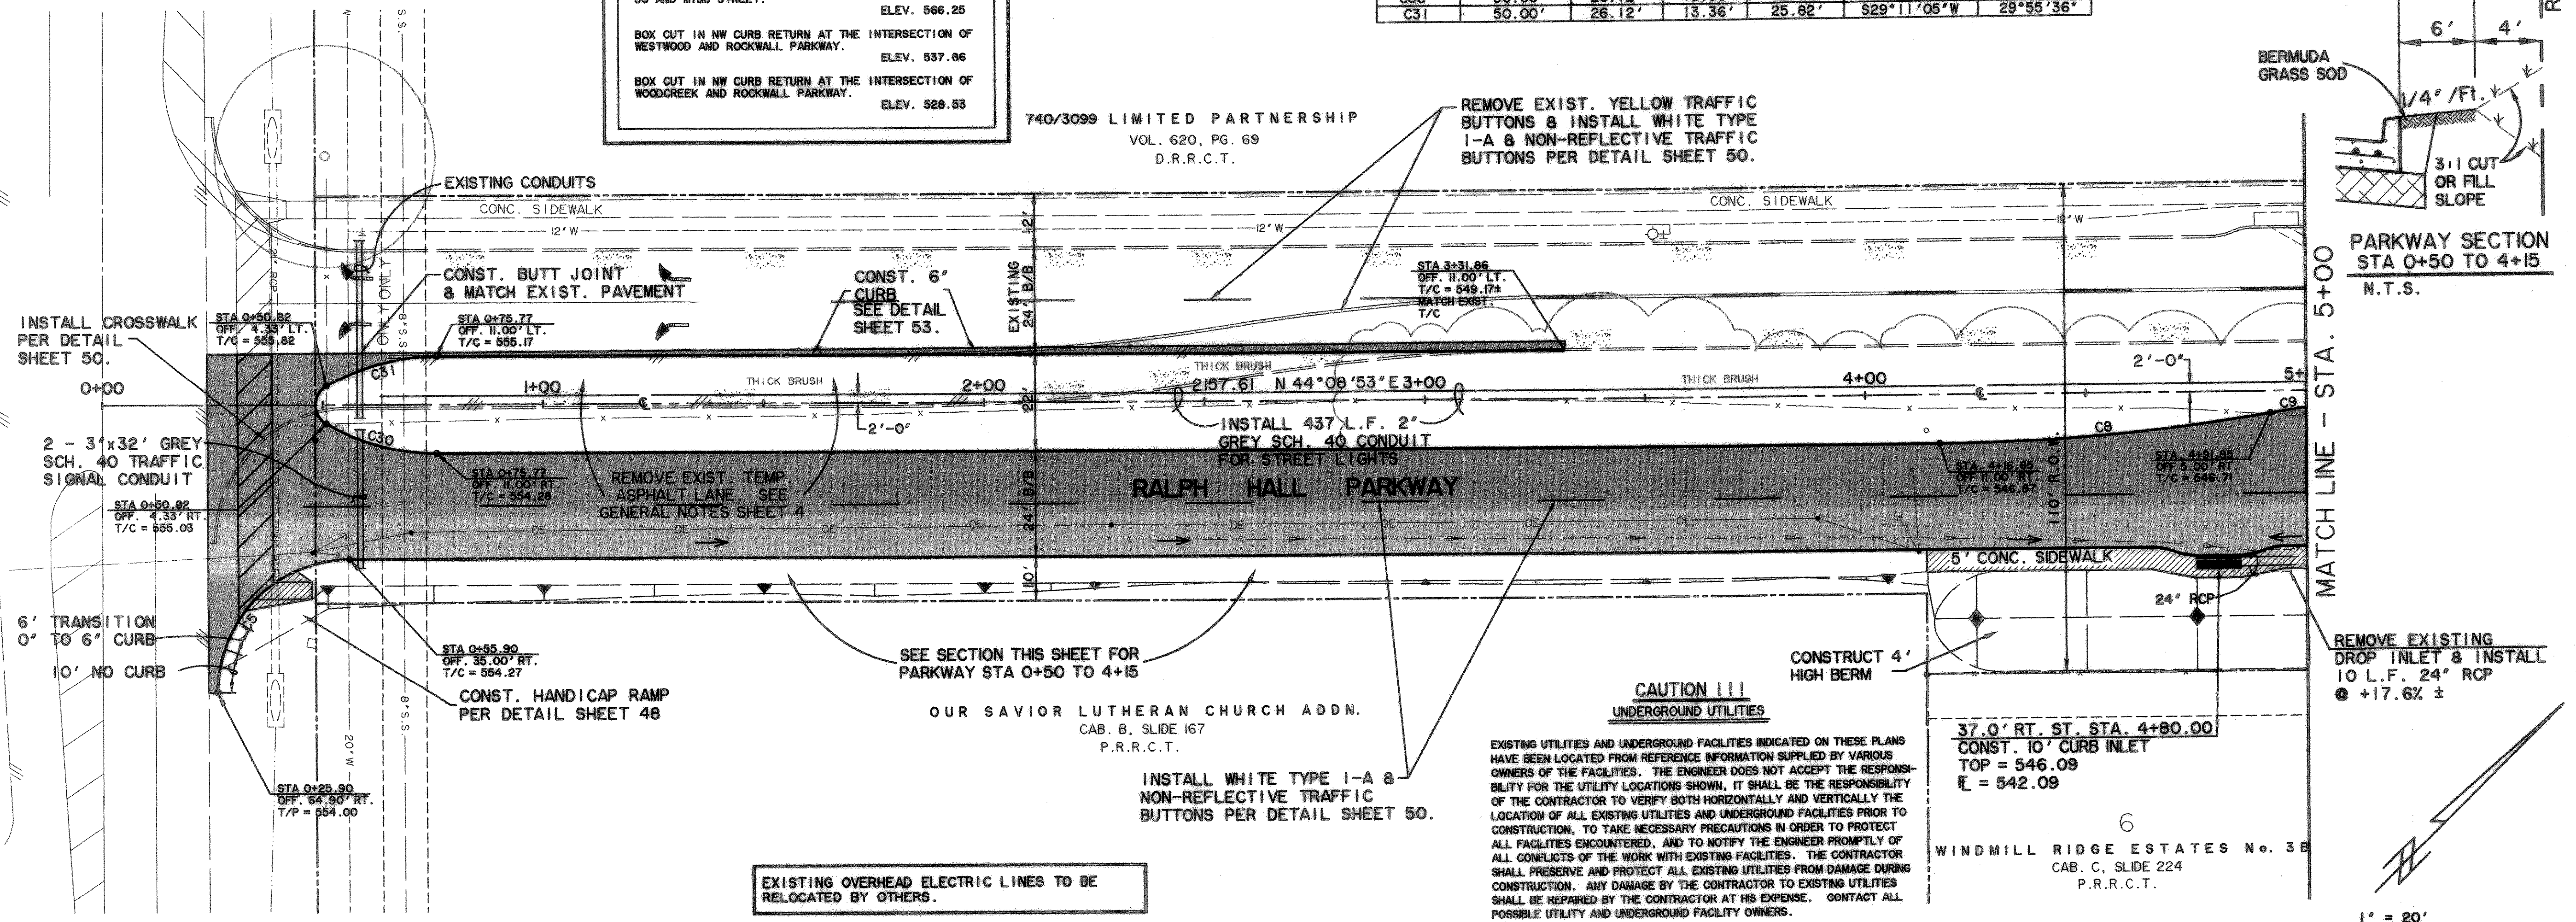

PARKWAY SECTION
 STA 0+50 TO 4+15
 N.T.S.


REMOVE EXIST. YELLOW TRAFFIC BUTTONS & INSTALL WHITE TYPE 1-A & NON-REFLECTIVE TRAFFIC BUTTONS PER DETAIL SHEET 50.

OUR SAVIOR LUTHERAN CHURCH ADDN.
 CAB. B. SLIDE 167
 P.R.R.C.T.

CAUTION !!!
 UNDERGROUND UTILITIES
 EXISTING UTILITIES AND UNDERGROUND FACILITIES INDICATED ON THESE PLANS HAVE BEEN LOCATED FROM REFERENCE INFORMATION SUPPLIED BY VARIOUS OWNERS OF THE FACILITIES. THE ENGINEER DOES NOT ACCEPT THE RESPONSIBILITY FOR THE UTILITY LOCATIONS SHOWN, IT SHALL BE THE RESPONSIBILITY OF THE CONTRACTOR TO VERIFY BOTH HORIZONTALLY AND VERTICALLY THE LOCATION OF ALL EXISTING UTILITIES AND UNDERGROUND FACILITIES PRIOR TO CONSTRUCTION, TO TAKE NECESSARY PRECAUTIONS IN ORDER TO PROTECT ALL FACILITIES ENCOUNTERED, AND TO NOTIFY THE ENGINEER PROMPTLY OF ALL CONFLICTS OF THE WORK WITH EXISTING FACILITIES. THE CONTRACTOR SHALL PRESERVE AND PROTECT ALL EXISTING UTILITIES FROM DAMAGE DURING CONSTRUCTION. ANY DAMAGE BY THE CONTRACTOR TO EXISTING UTILITIES SHALL BE REPAIRED BY THE CONTRACTOR AT HIS EXPENSE. CONTACT ALL POSSIBLE UTILITY AND UNDERGROUND FACILITY OWNERS.

EXISTING OVERHEAD ELECTRIC LINES TO BE RELOCATED BY OTHERS.


RALPH HALL PARKWAY

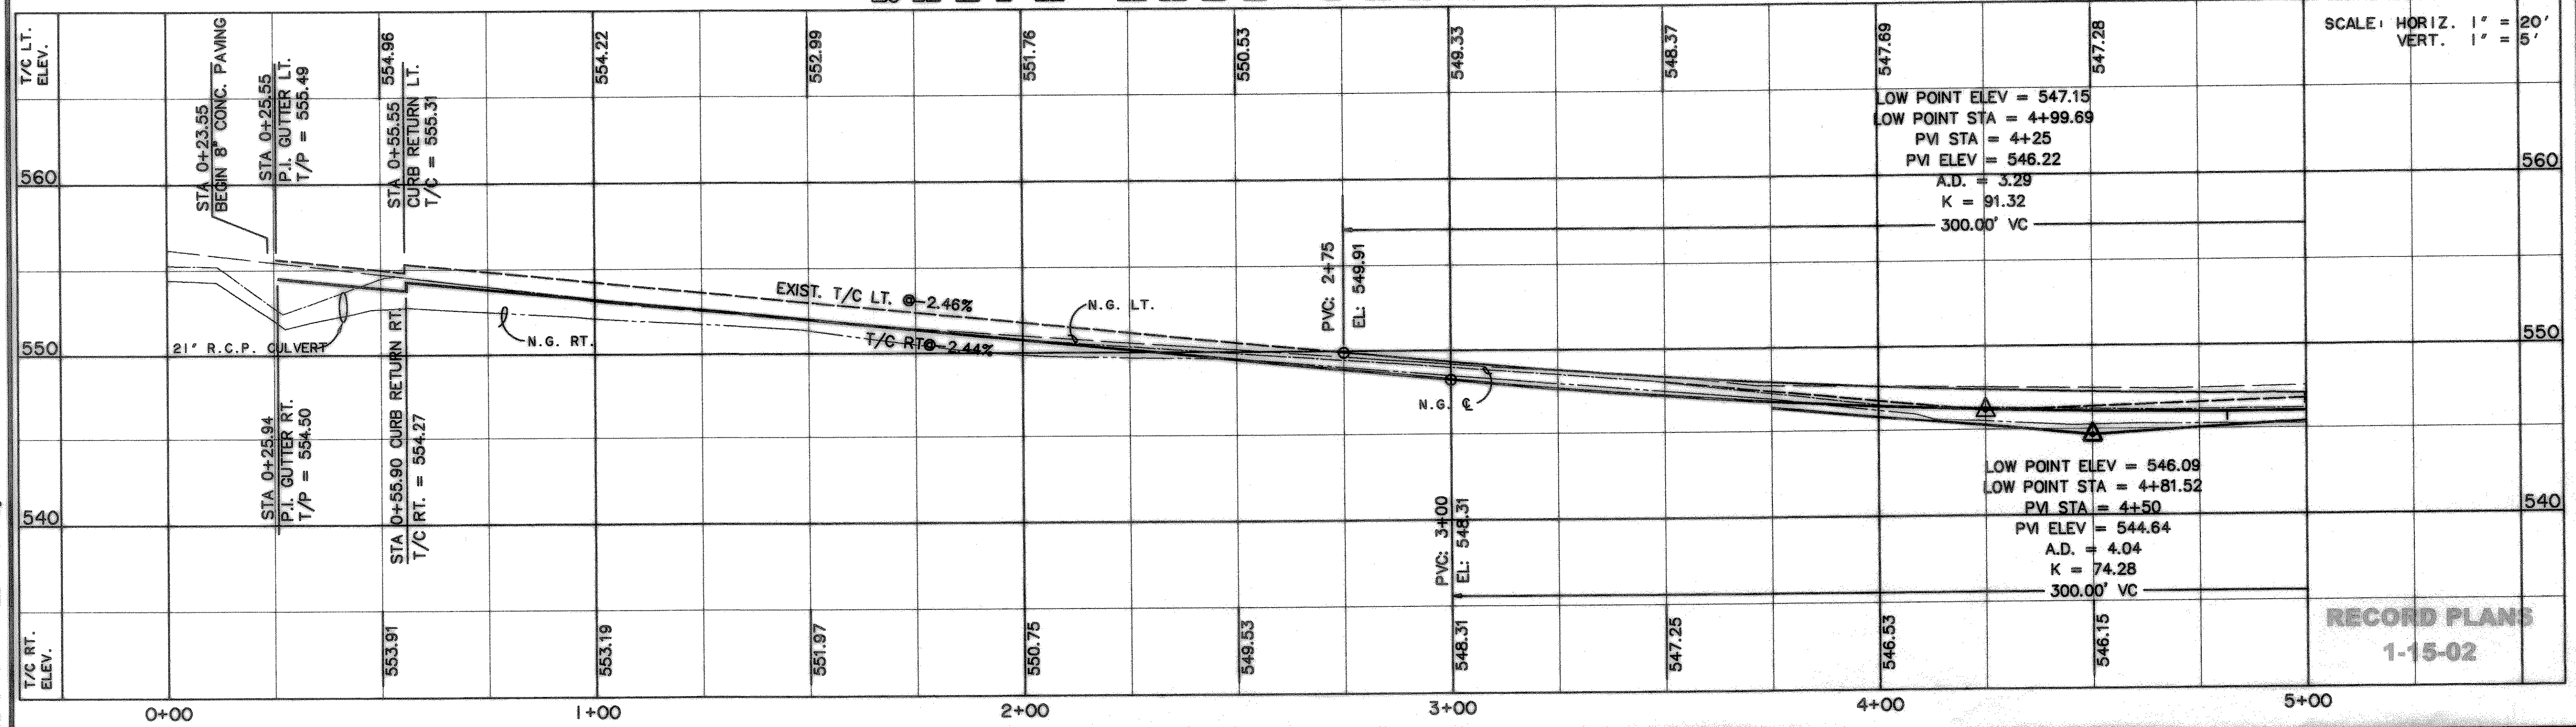


SCALE: HORIZ. 1" = 20'
 VERT. 1" = 5'

RECORD PLANS
 1-15-02

PREPARED BY:
WIER & ASSOCIATES, INC.
 ENGINEERS SURVEYORS LAND PLANNERS
 4300 BELLEVUE PLACE SUITE 130 ARLINGTON, TEXAS 76010 METRO (817)467-7700
 4100 AMAR CARRIER BLVD. SUITE 200 FORT WORTH, TEXAS 76155 METRO (817)365-4637

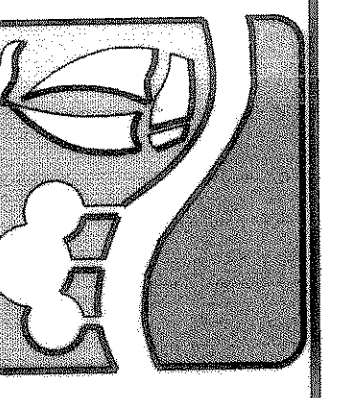

RALPH HALL PARKWAY
 PAVING PLAN & PROFILE
 STA 0+00 TO 5+00

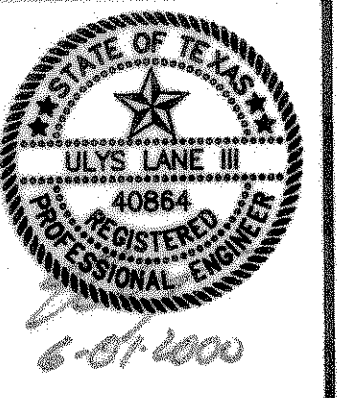

COPYRIGHT ©
 WIER & ASSOCIATES, INC.
 LAST SHEET EDIT
 DATE 06-01-2000
 WA# 97057
SHEET NO. 6