



ROCKWALL INDEPENDANT
SCHOOL DISTRICT
VOL. 1074, PG. 214
D.R.R.C.T.


LOT 4, BLOCK "A"
ROCKWALL MARKET
CENTER EAST

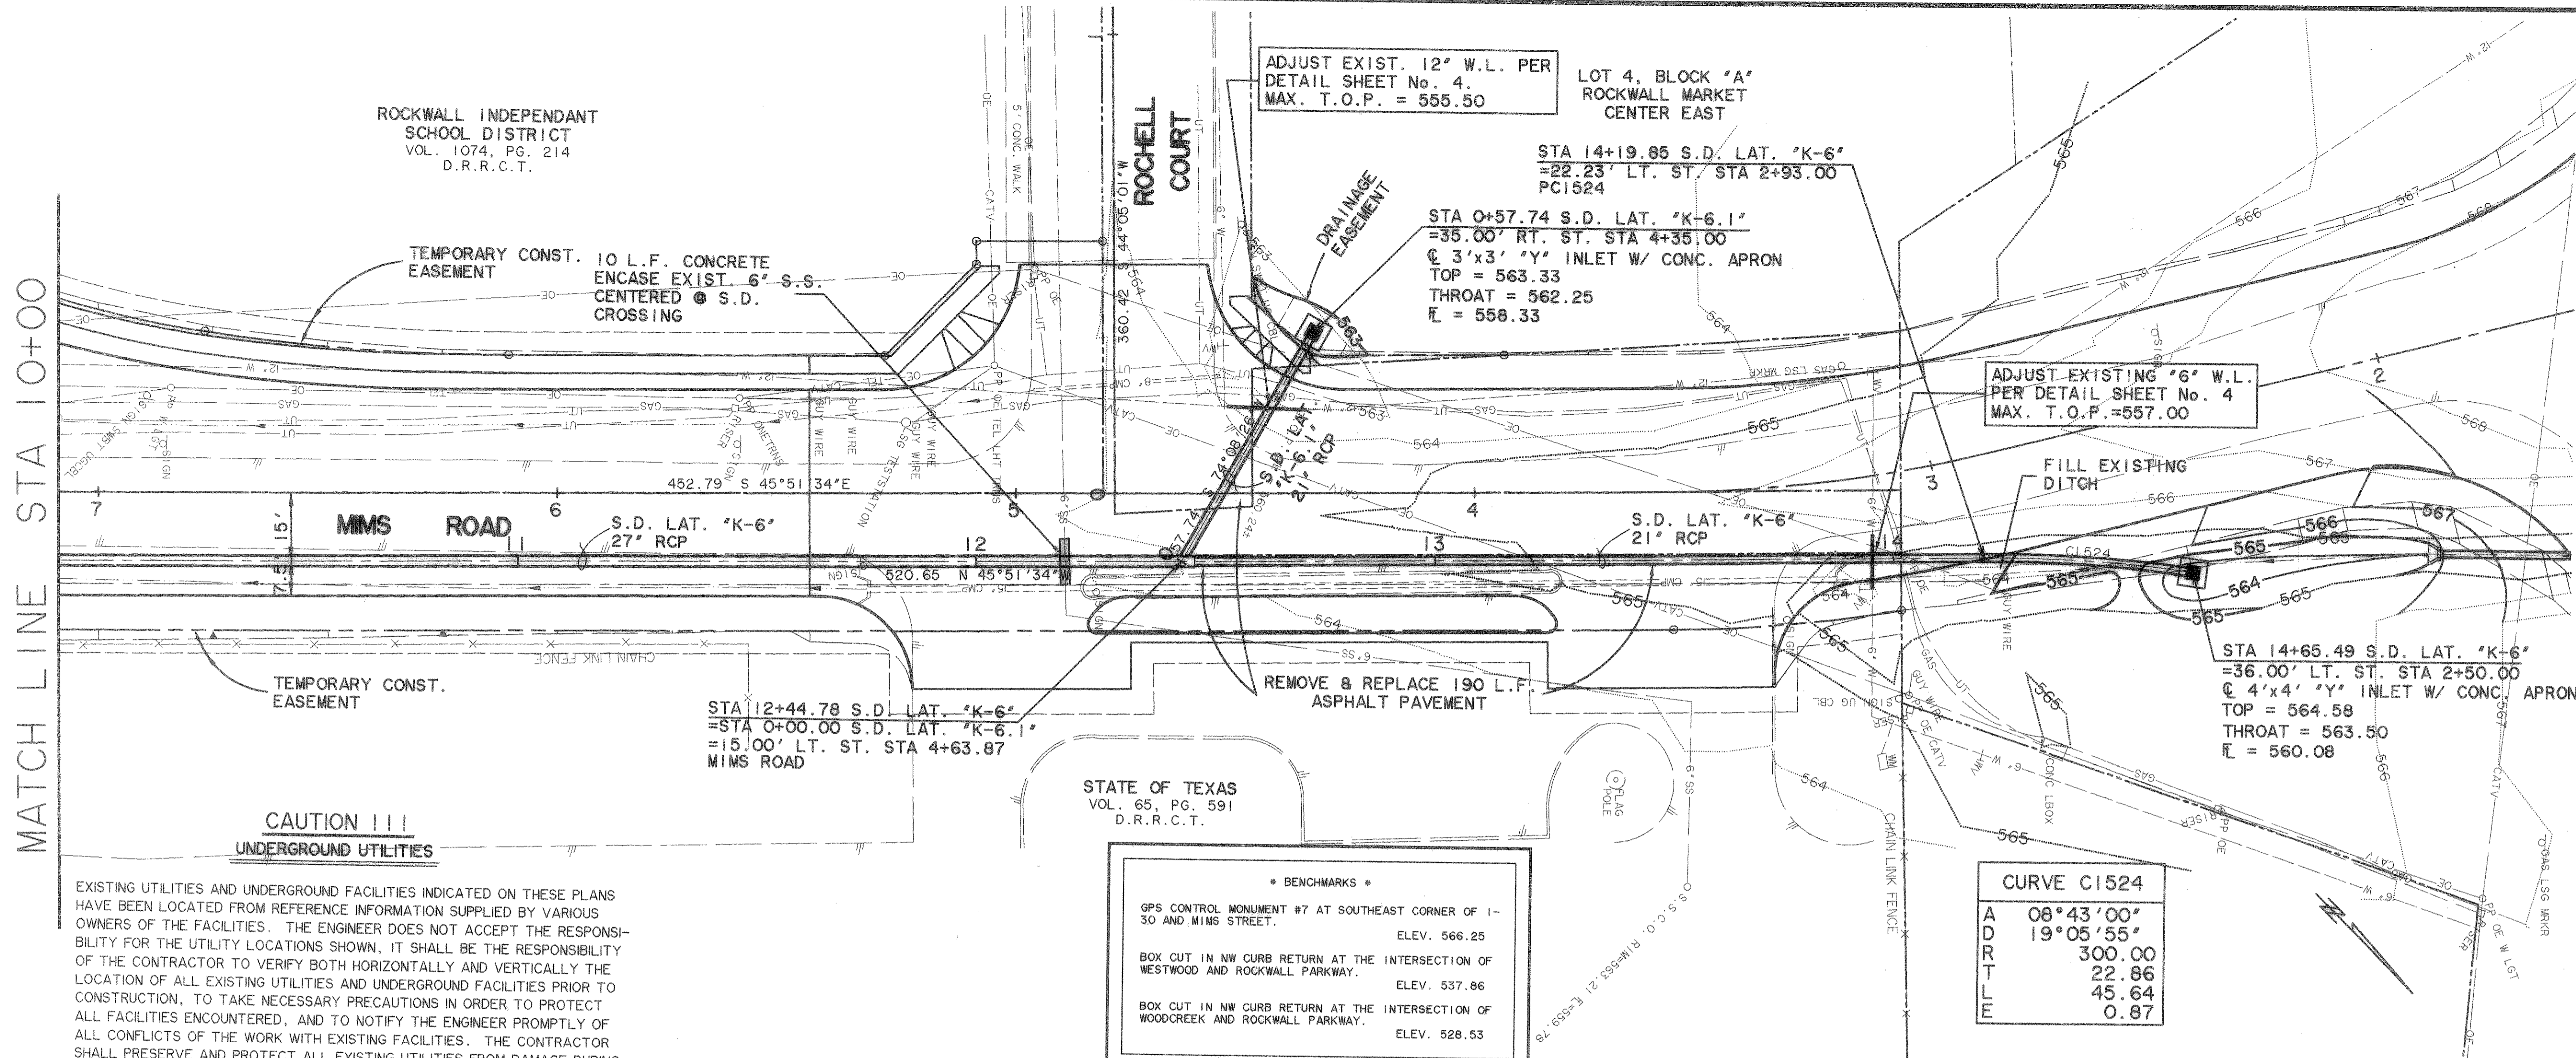


STORM DRAIN LATERAL "K-6"

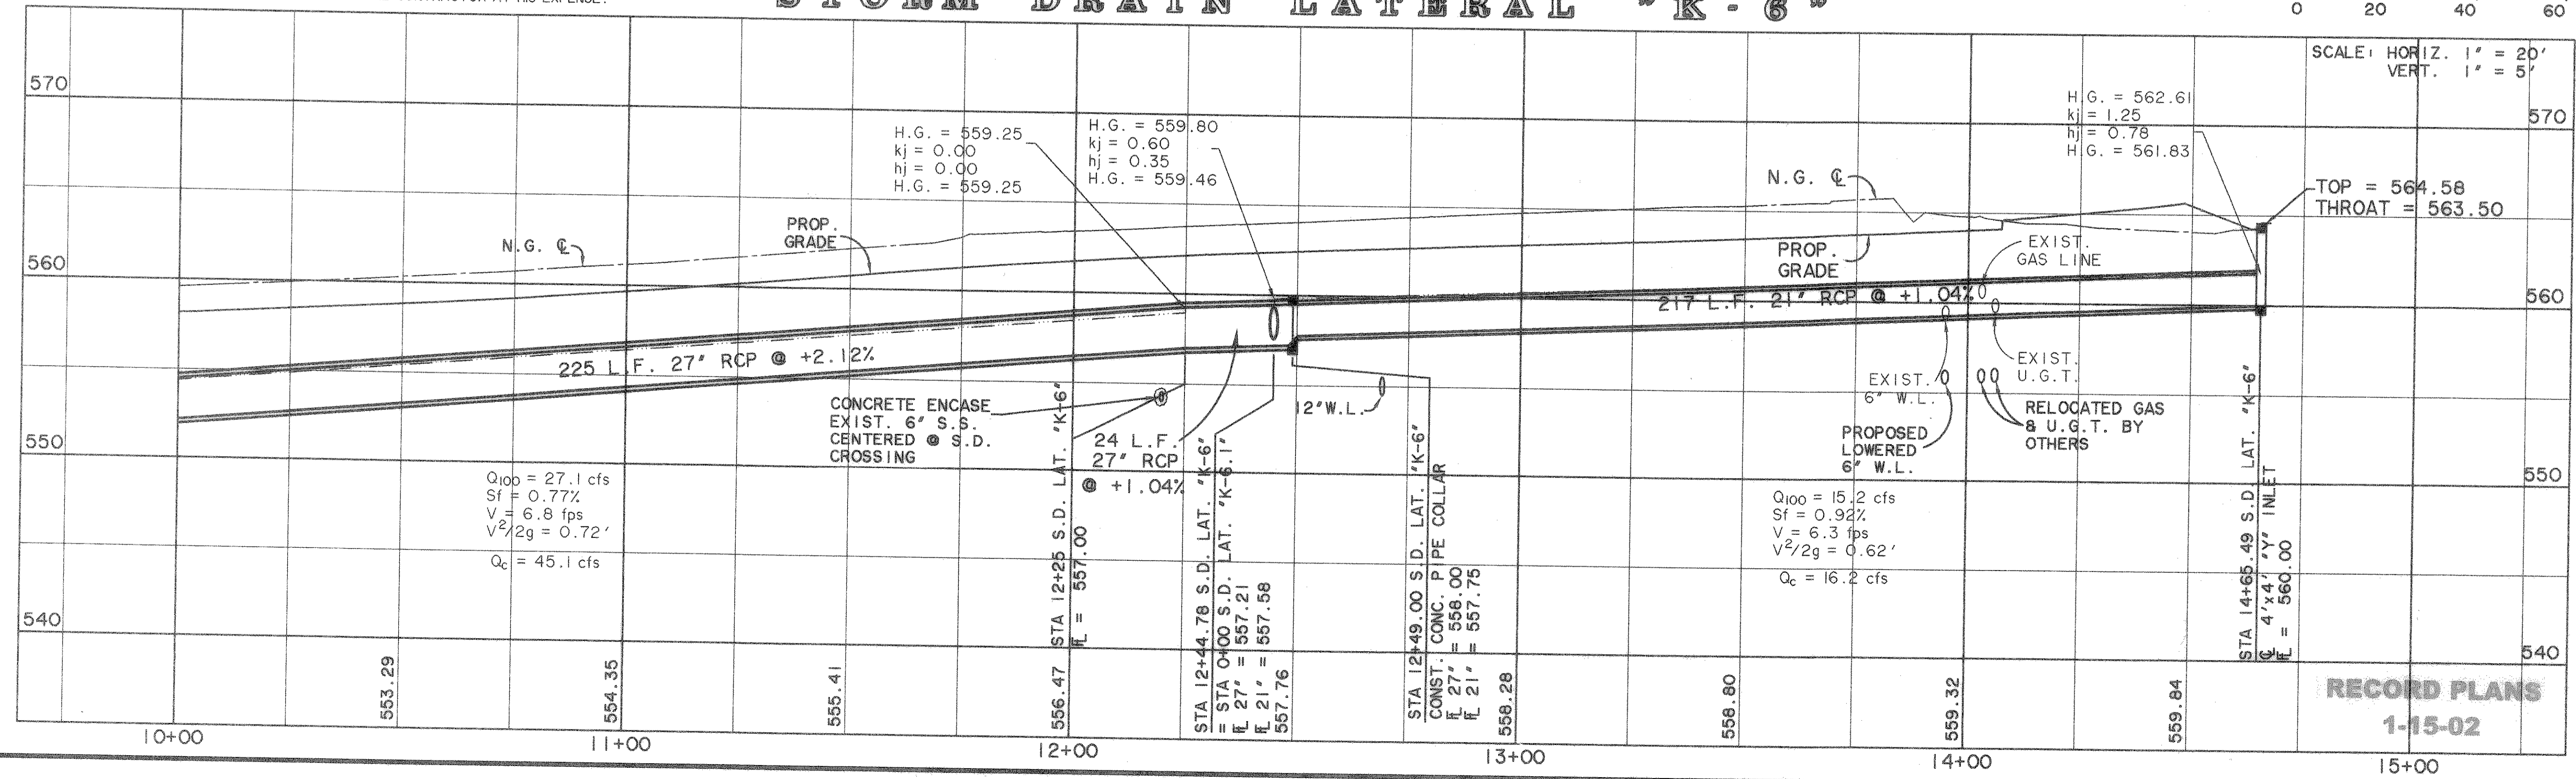

PREPARED BY:
VIA WIER & ASSOCIATES, INC.
ENGINEERS SURVEYORS LAND PLANNERS
4300 BELWAY PLACE, SUITE 130 ARLINGTON, TEXAS 76010 METRO (817)467-7700
4100 AMON CENTER BLVD. SUITE 200 FORT WORTH, TEXAS 76155 METRO (817)355-9437

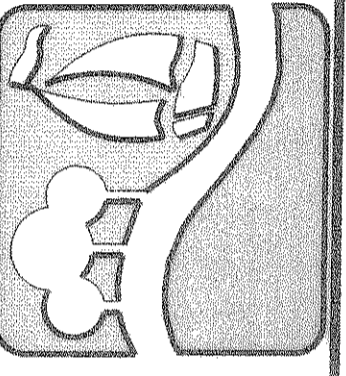

**STORM DRAIN
LATERAL "K-6" PLAN & PROFILE**
STA 10+00 TO END

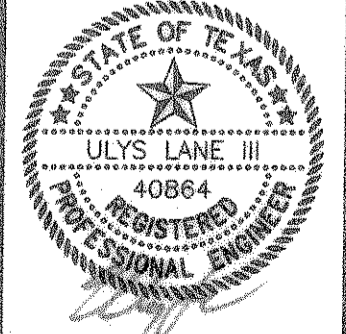

COPYRIGHT ©
WIER & ASSOCIATES, INC.
LAST SHEET EDIT
DATE 11-23-99
WA# 97057
SHEET NO.
33

TIME 1:16:32 FILE: SDPP16.dwg