

*NOTE: ALL PVC WATER LINE SHALL BE C-900 CLASS 200 PIPE. ALL CHANGES IN WATER LINE DIRECTION (BENDS) SHALL BE RESTRAINED (MEGA-LUG OR EQUAL) AND CONCRETE BLOCKED. THE NEXT JOINT EITHER SIDE OF THE CHANGE OF DIRECTION SHALL ALSO BE RESTRAINED.

CURVE C1500		CURVE C1501		CURVE C1502		CURVE C1503		CURVE C1504	
A	28°09'41"	A	34°47'42"	A	03°08'14"	A	10°13'49"	A	04°29'38"
D	08°58'26"	D	10°06'52"	D	08°55'29"	D	22°55'06"	D	22°55'06"
R	638.48	R	566.48	R	641.98	R	250.00	R	250.00
T	160.15	T	177.50	T	17.58	T	22.38	T	9.81
L	313.82	L	344.02	L	35.15	L	44.64	L	19.61
E	19.78	E	27.16	E	0.24	E	1.00	E	0.19


CAUTION !!!
UNDERGROUND UTILITIES

EXISTING UTILITIES AND UNDERGROUND FACILITIES INDICATED ON THESE PLANS HAVE BEEN LOCATED FROM REFERENCE INFORMATION SUPPLIED BY VARIOUS OWNERS OF THE FACILITIES. THE ENGINEER DOES NOT ACCEPT THE RESPONSIBILITY OF THE CONTRACTOR TO VERIFY BOTH HORIZONTALLY AND VERTICALLY THE LOCATION OF ALL EXISTING UTILITIES AND UNDERGROUND FACILITIES PRIOR TO CONSTRUCTION, TO TAKE NECESSARY PRECAUTIONS IN ORDER TO PROTECT ALL FACILITIES ENCOUNTERED, AND TO NOTIFY THE ENGINEER PROMPTLY OF ALL CONFLICTS OF THE WORK WITH EXISTING FACILITIES. THE CONTRACTOR SHALL PRESERVE AND PROTECT ALL EXISTING UTILITIES FROM DAMAGE DURING CONSTRUCTION. ANY DAMAGE BY THE CONTRACTOR TO EXISTING UTILITIES SHALL BE REPAIRED BY THE CONTRACTOR AT HIS EXPENSE.


• BENCHMARKS •

GPS CONTROL MONUMENT #7 AT SOUTHEAST CORNER OF 1-30 AND MIMS STREET.	ELEV. 566.25
BOX CUT IN NW CURB RETURN AT THE INTERSECTION OF WESTWOOD AND ROCKWALL PARKWAY.	ELEV. 537.86
BOX CUT IN NW CURB RETURN AT THE INTERSECTION OF WOODCREEK AND ROCKWALL PARKWAY.	ELEV. 528.53

RW MARKETCENTER ASSOCIATES, LTD.
VOL. 1395, PG. 71
D.R.R.C.T.

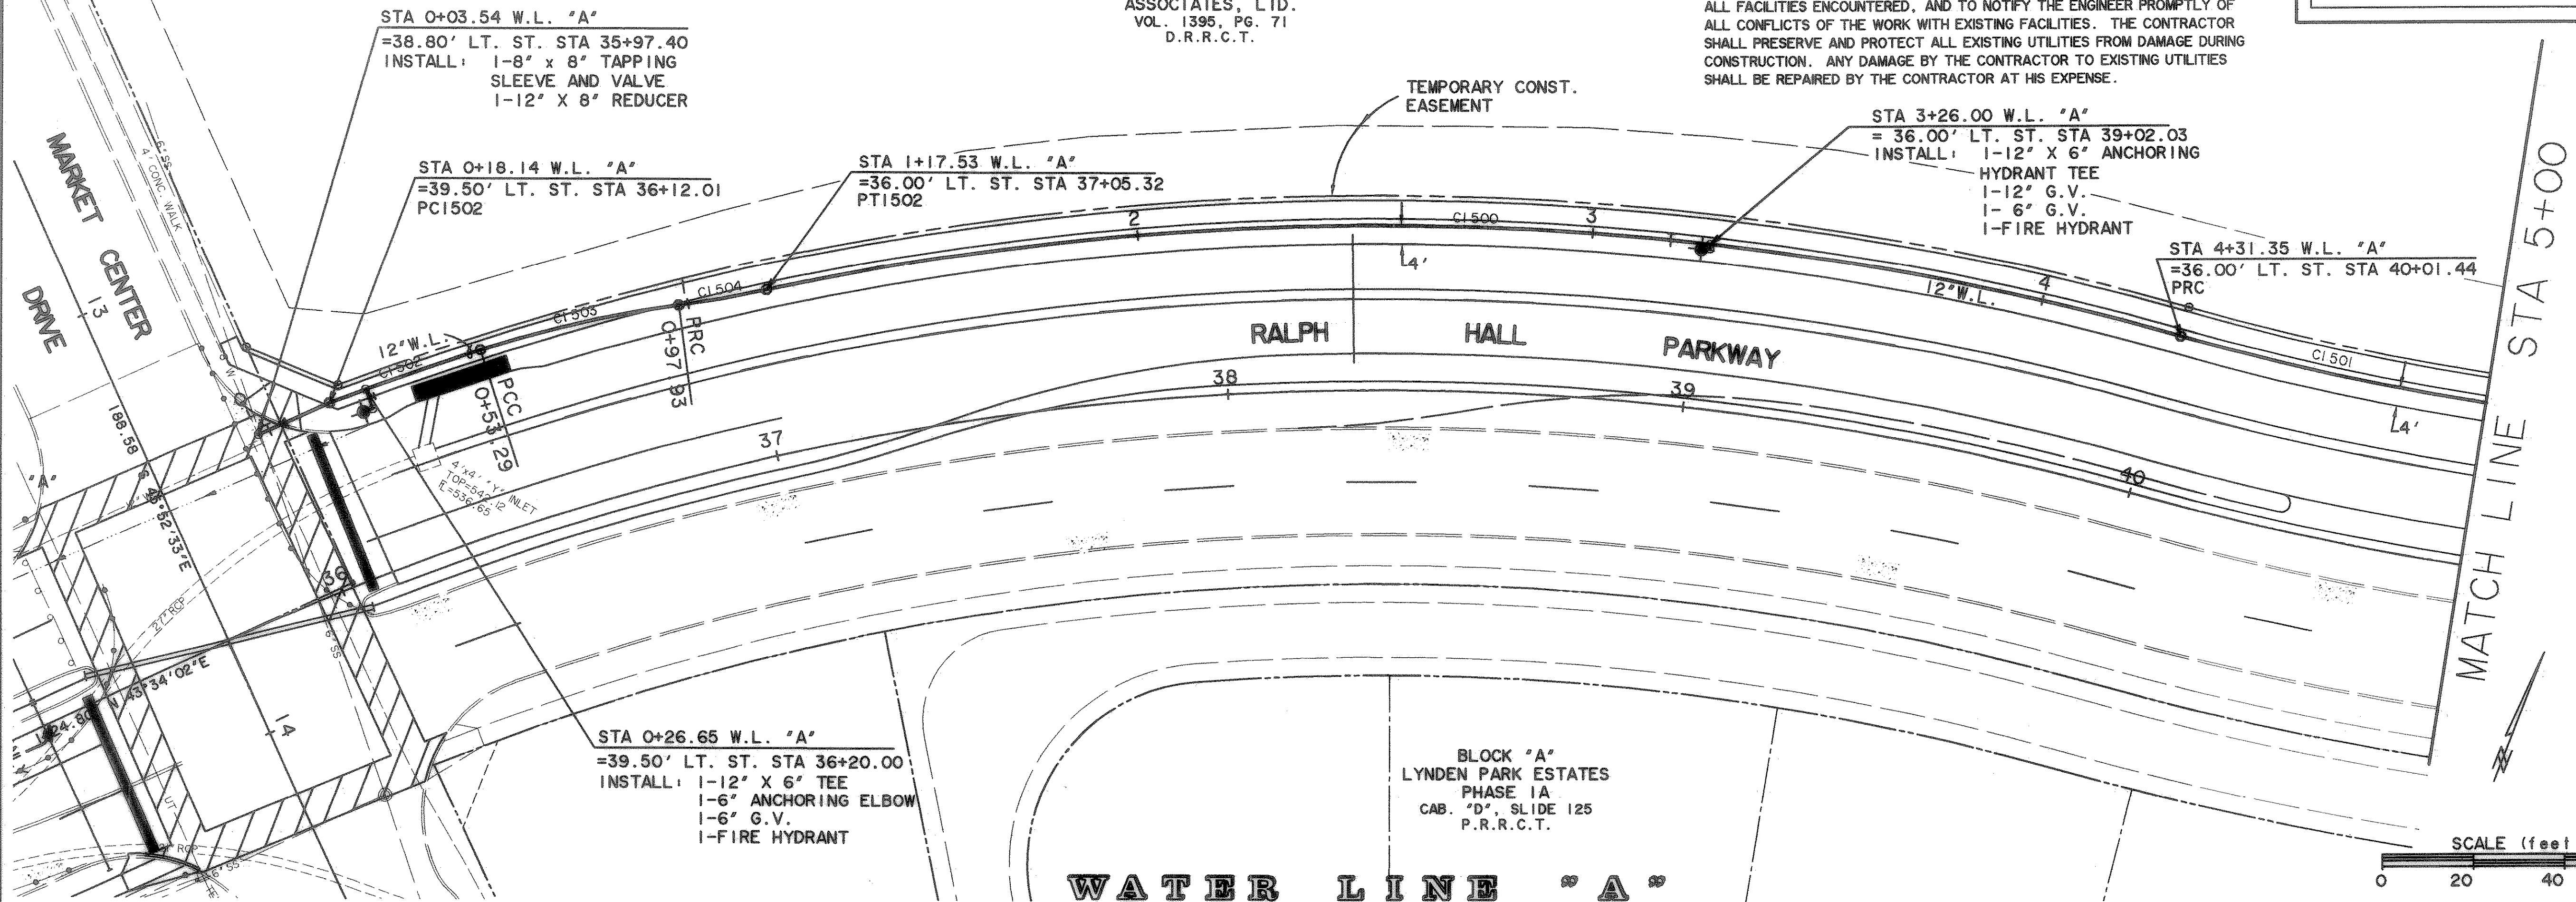


WATER LINE "A"

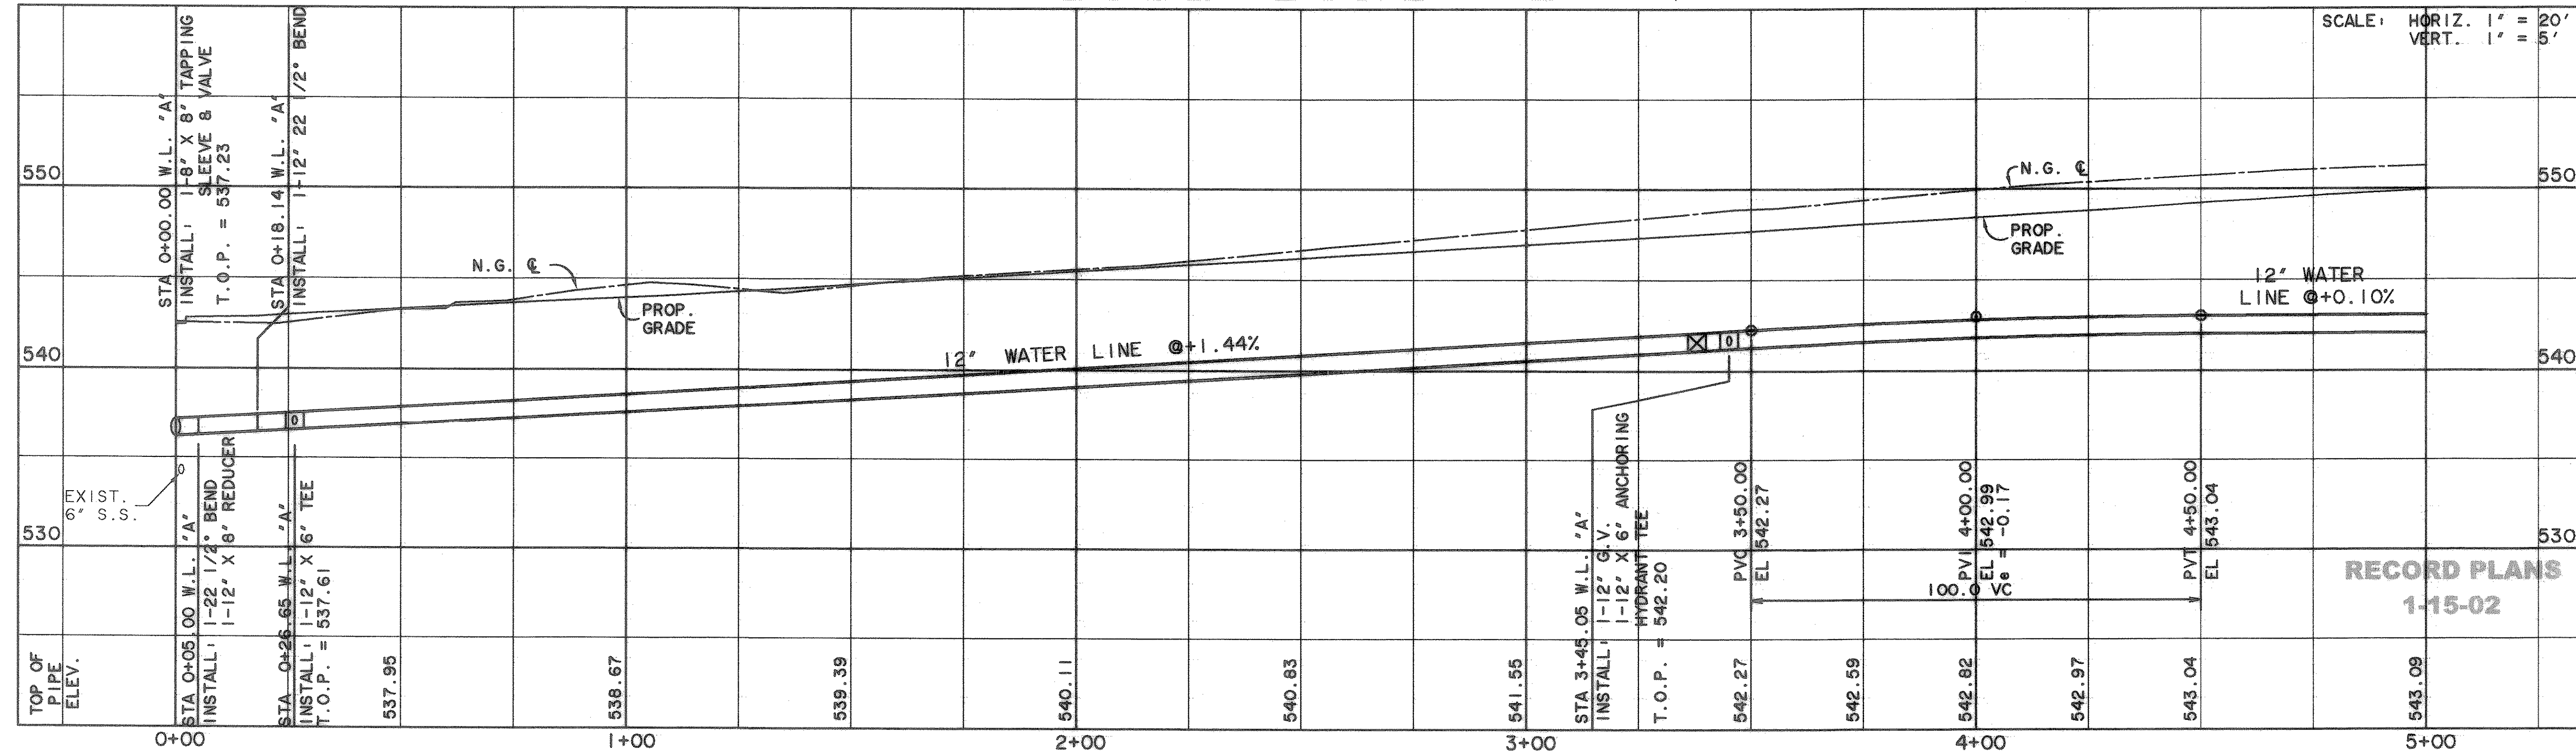

SCALE: HORIZ. 1" = 20'
VERT. 1" = 5'

RECORD PLANS
1-15-02

PREPARED BY:
VIA WIER & ASSOCIATES, INC.
ENGINEERS SURVEYORS LAND PLANNERS
4300 DELWAY PLACE SUITE 130 ARLINGTON, TEXAS 76010 METRO (817)467-7700
4100 AMAN CENTER BLVD. SUITE 200 FORT WORTH, TEXAS 76155 METRO (817)355-9457

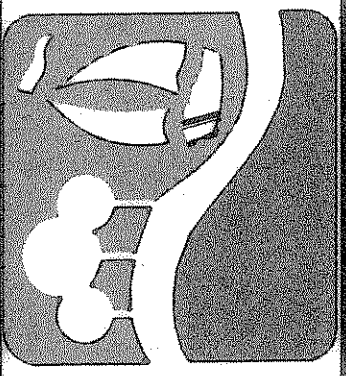

**WATER LINE
PLAN & PROFILE**
STA 0+00 TO 5+00



COPYRIGHT ©
WIER & ASSOCIATES, INC.
LAST SHEET EDIT
DATE 01-15-2002
WA# 97057

SHEET NO.
35

TIME: 8:57 FILE: WLPP8.dwg