


CURVE C1505		CURVE C1506		CURVE C1507		CURVE C1508		CURVE C1509		CURVE C1510		CURVE C1511		CURVE C1512	
A	06°47'00"	A	06°47'00"	A	06°47'00"	A	06°47'00"	A	06°47'00"	A	06°47'00"	A	06°47'00"	A	06°47'00"
D	22°55'06"	D	22°55'06"	D	22°55'06"	D	22°55'06"	D	22°55'06"	D	22°55'06"	D	22°55'06"	D	22°55'06"
R	250.00	R	250.00	R	250.00	R	250.00	R	250.00	R	250.00	R	250.00	R	250.00
T	14.82	T	14.82	T	14.82	T	14.82	T	14.82	T	14.82	T	14.82	T	14.82
L	29.60	L	29.60	L	29.60	L	29.60	L	29.60	L	29.60	L	29.60	L	29.60
E	0.44	E	0.44	E	0.44	E	0.44	E	0.44	E	0.44	E	0.44	E	0.44

TRUSTEES OF THE  
ROCKWALL INDEPENDENT  
SCHOOL DISTRICT  
VOL. 137, PG. 217  
D.R.R.C.T.

MATCH LINE STA 10+00

MATCH LINE STA 15+00

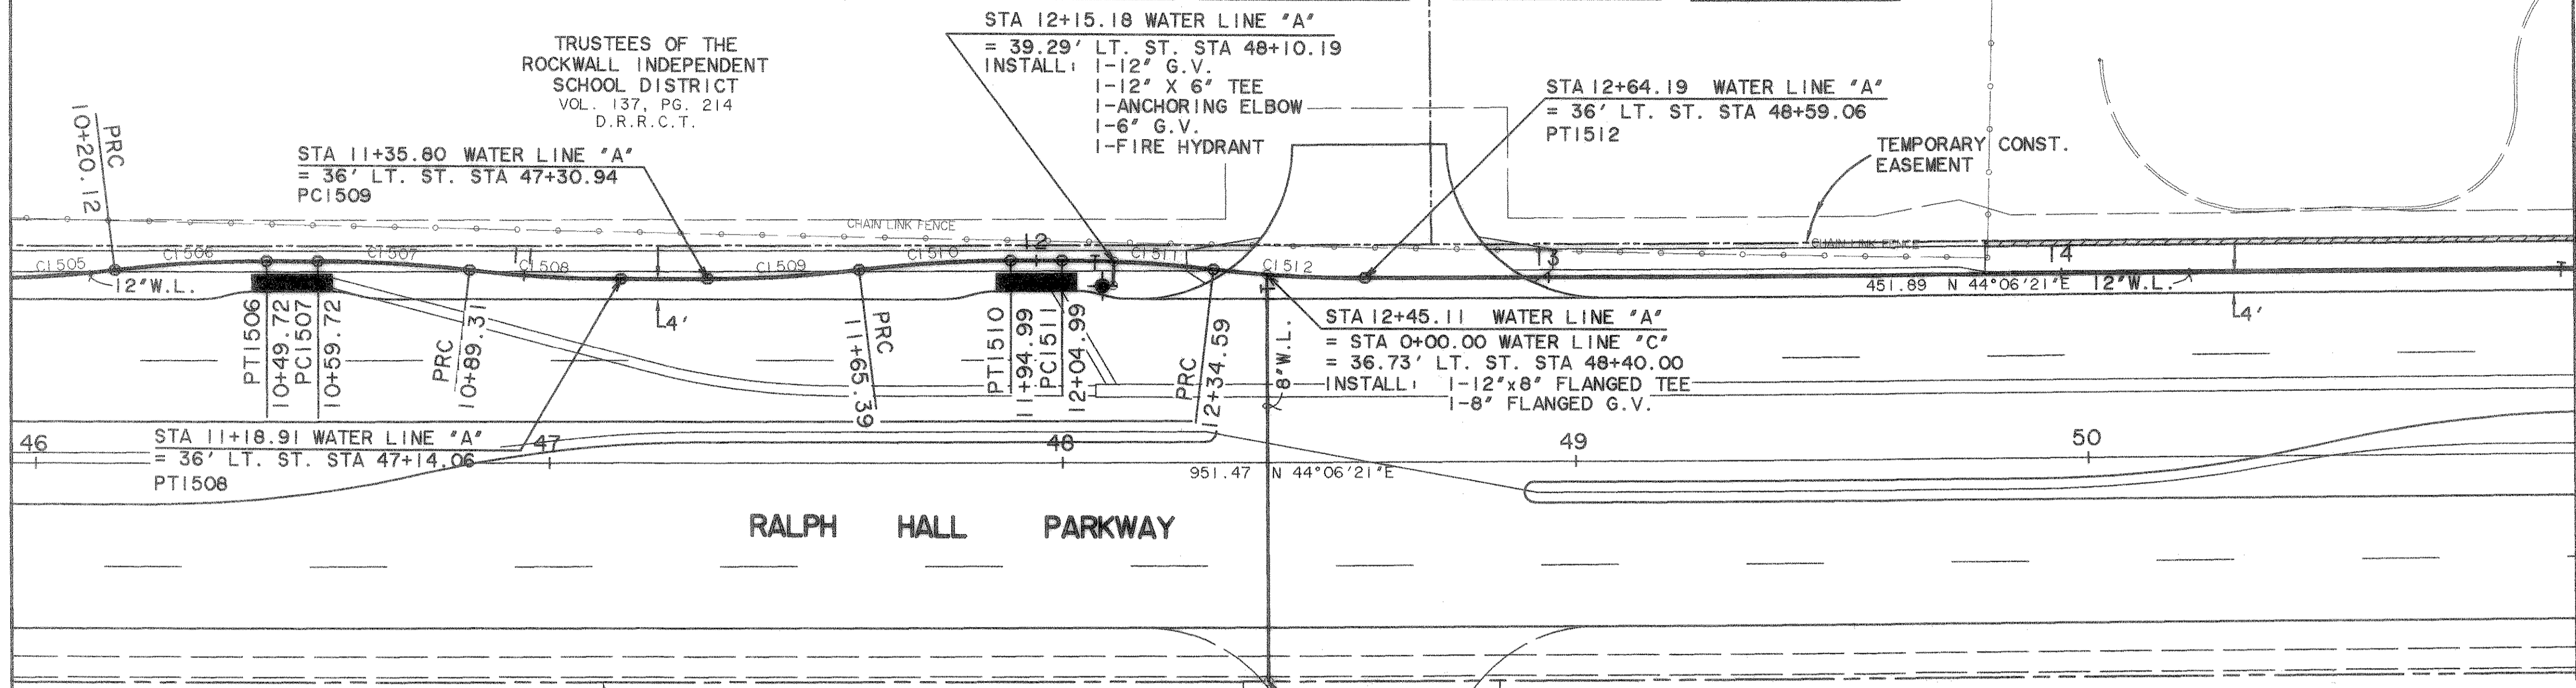

RALPH HALL PARKWAY

SHEPHERD PLACE  
HOMES, INC.  
VOL. 1289, PG. 150  
D.R.R.C.T.

CAUTION !!!  
UNDERGROUND UTILITIES



\*NOTE: ALL PVC WATER LINE SHALL BE C-900 CLASS 200 PIPE. ALL CHANGES IN WATER LINE DIRECTION (BENDS) SHALL BE RESTRAINED (MEGA-LUG OR EQUAL) AND CONCRETE BLOCKED. THE NEXT JOINT EITHER SIDE OF THE CHANGE OF DIRECTION SHALL ALSO BE RESTRAINED.

EXISTING UTILITIES AND UNDERGROUND FACILITIES INDICATED ON THESE PLANS HAVE BEEN LOCATED FROM REFERENCE INFORMATION SUPPLIED BY VARIOUS OWNERS OF THE FACILITIES. THE ENGINEER DOES NOT ACCEPT THE RESPONSIBILITY FOR THE UTILITY LOCATIONS SHOWN. IT SHALL BE THE RESPONSIBILITY OF THE CONTRACTOR TO VERIFY BOTH HORIZONTALLY AND VERTICALLY THE LOCATION OF ALL EXISTING UTILITIES AND UNDERGROUND FACILITIES PRIOR TO CONSTRUCTION, TO TAKE NECESSARY PRECAUTIONS IN ORDER TO PROTECT ALL FACILITIES ENCOUNTERED, AND TO NOTIFY THE ENGINEER PROMPTLY OF ALL CONFLICTS OF THE WORK WITH EXISTING FACILITIES. THE CONTRACTOR SHALL PRESERVE AND PROTECT ALL EXISTING UTILITIES FROM DAMAGE DURING CONSTRUCTION. ANY DAMAGE BY THE CONTRACTOR TO EXISTING UTILITIES SHALL BE REPAIRED BY THE CONTRACTOR AT HIS EXPENSE.

\* BENCHMARKS \*


GPS CONTROL MONUMENT #7 AT SOUTHEAST CORNER OF 1-30 AND MIMS STREET.	ELEV. 566.25
BOX CUT IN NW CURB RETURN AT THE INTERSECTION OF WESTWOOD AND ROCKWALL PARKWAY.	ELEV. 537.86
BOX CUT IN NW CURB RETURN AT THE INTERSECTION OF WOODCREEK AND ROCKWALL PARKWAY.	ELEV. 528.53

WATER LINE "A"

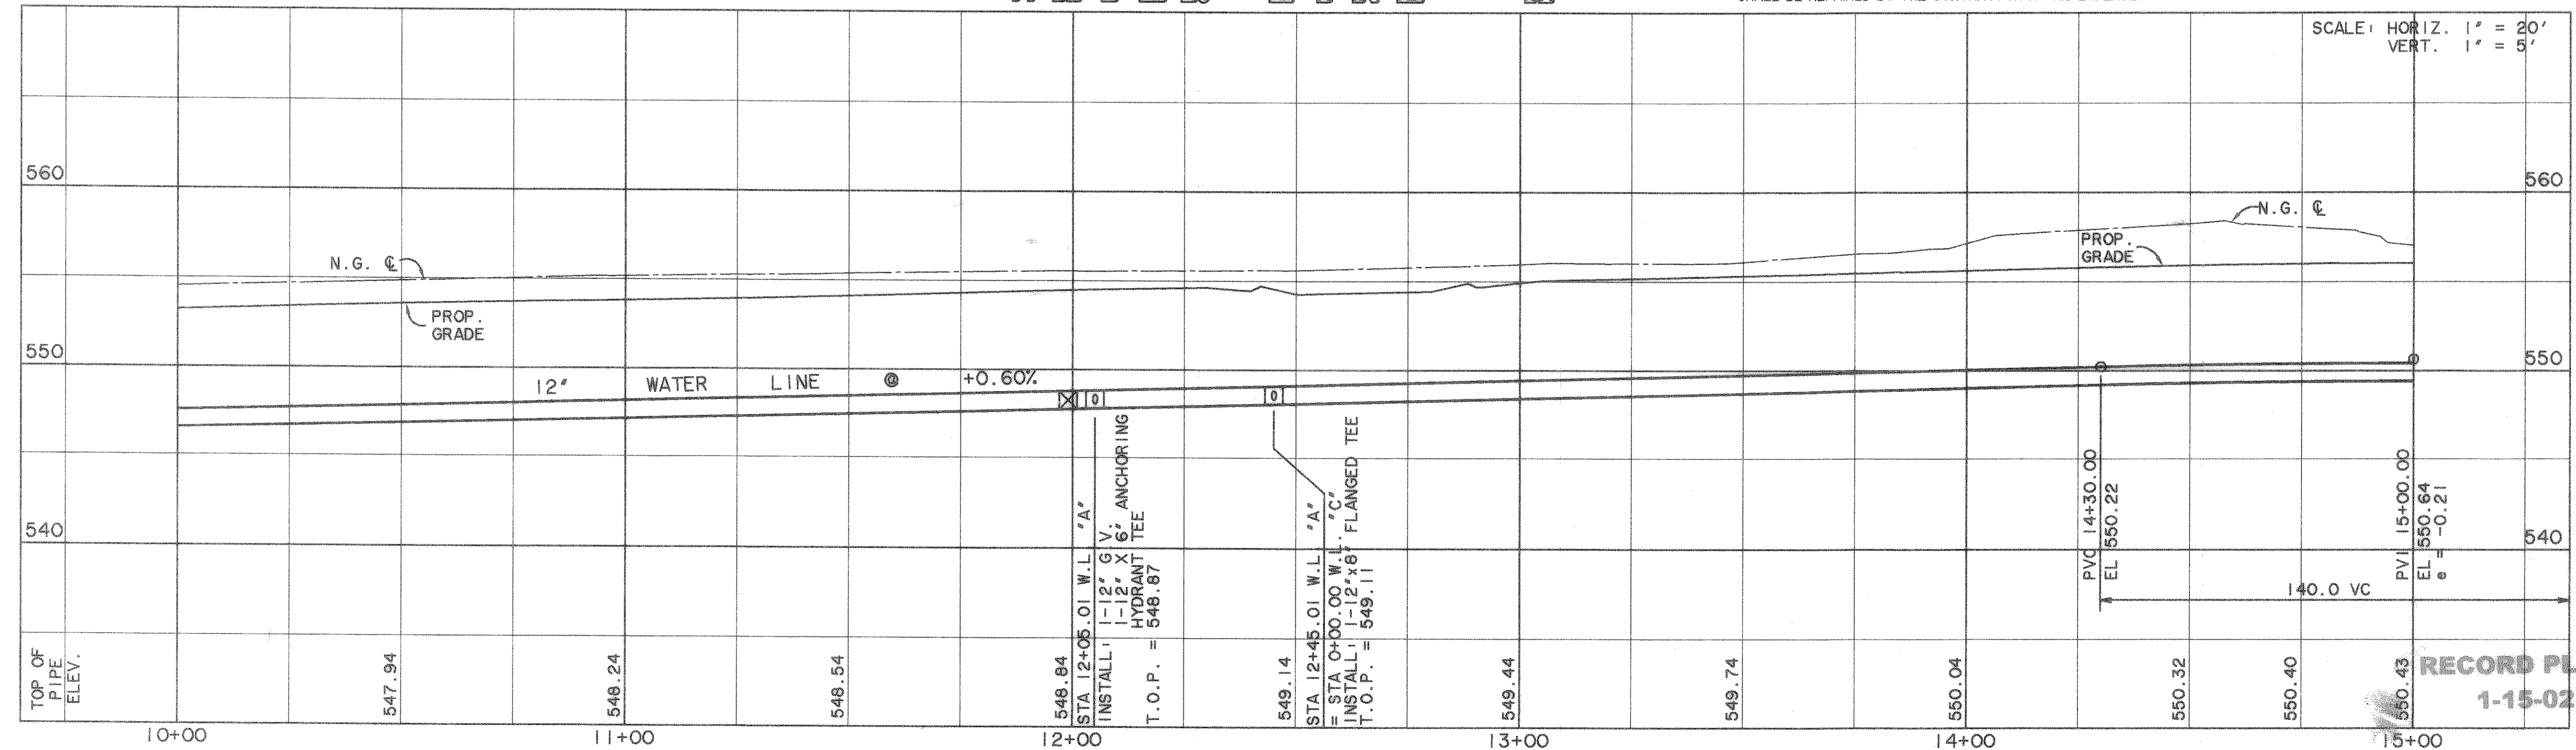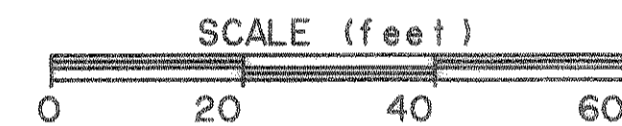


RECORD PLANS  
1-15-02

PREPARED BY:  
**VIA WIER & ASSOCIATES, INC.**  
ENGINEERS SURVEYORS LAND PLANNERS  
4300 BELWAY PLACE SUITE 130 ARLINGTON, TEXAS 76018 METRO (817)467-7700  
4108 AMON CARTER BLVD. SUITE 200 FORT WORTH, TEXAS 76155 METRO (817)355-9437

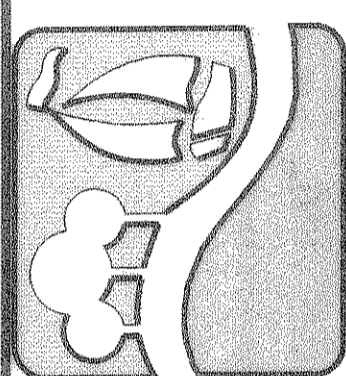

WATER LINE  
PLAN & PROFILE  
STA 10+00 TO 15+00

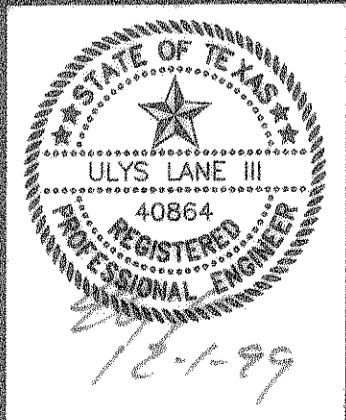

COPYRIGHT ©  
WIER & ASSOCIATES, INC.  
LAST SHEET EDIT  
DATE 11-26-99  
WA# 97057  
SHEET NO.  
37