


MATCH LINE STA 15+00

CURVE C1515		CURVE C1514		CURVE C1513		CURVE C1516	
A	06°47'00"	A	06°47'00"	A	06°47'00"	A	06°47'00"
D	22°55'06"	D	22°55'06"	D	22°55'06"	D	22°55'06"
R	250.00	R	250.00	R	250.00	R	250.00
T	14.82	T	14.82	T	14.82	T	14.82
E	29.60	E	29.60	E	29.60	E	29.60
	0.44		0.44		0.44		0.44

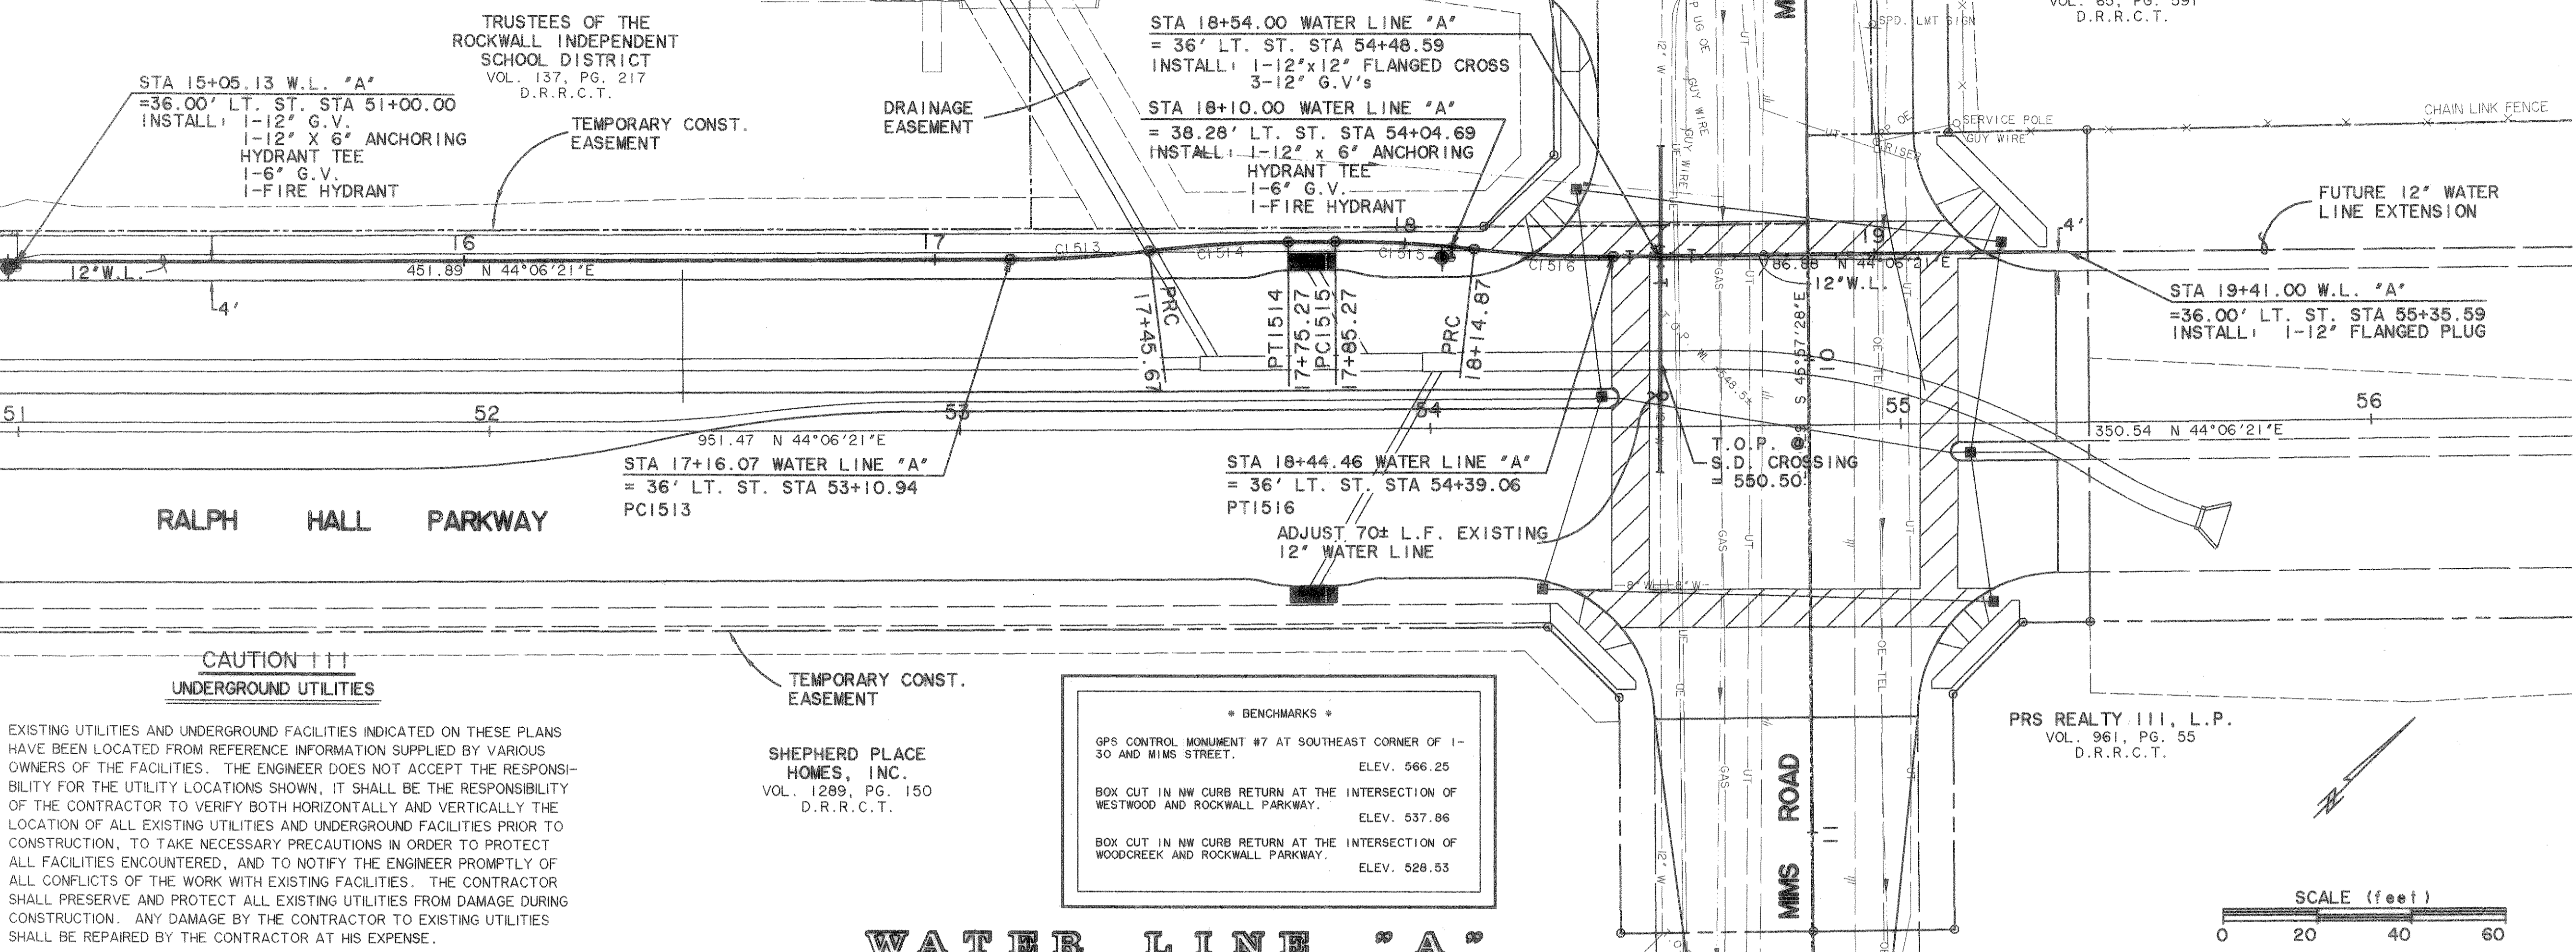


CAUTION !!!
UNDERGROUND UTILITIES

EXISTING UTILITIES AND UNDERGROUND FACILITIES INDICATED ON THESE PLANS HAVE BEEN LOCATED FROM REFERENCE INFORMATION SUPPLIED BY VARIOUS OWNERS OF THE FACILITIES. THE ENGINEER DOES NOT ACCEPT THE RESPONSIBILITY FOR THE UTILITY LOCATIONS SHOWN, IT SHALL BE THE RESPONSIBILITY OF THE CONTRACTOR TO VERIFY BOTH HORIZONTALLY AND VERTICALLY THE LOCATION OF ALL EXISTING UTILITIES AND UNDERGROUND FACILITIES PRIOR TO CONSTRUCTION, TO TAKE NECESSARY PRECAUTIONS IN ORDER TO PROTECT ALL FACILITIES ENCOUNTERED, AND TO NOTIFY THE ENGINEER PROMPTLY OF ALL CONFLICTS OF THE WORK WITH EXISTING FACILITIES. THE CONTRACTOR SHALL PRESERVE AND PROTECT ALL EXISTING UTILITIES FROM DAMAGE DURING CONSTRUCTION. ANY DAMAGE BY THE CONTRACTOR TO EXISTING UTILITIES SHALL BE REPAIRED BY THE CONTRACTOR AT HIS EXPENSE.

BENCHMARKS

GPS CONTROL MONUMENT #7 AT SOUTHEAST CORNER OF 1-30 AND MIMS STREET.	ELEV. 566.25
BOX CUT IN NW CURB RETURN AT THE INTERSECTION OF WESTWOOD AND ROCKWALL PARKWAY.	ELEV. 537.96
BOX CUT IN NW CURB RETURN AT THE INTERSECTION OF WOODCREEK AND ROCKWALL PARKWAY.	ELEV. 528.53

WATER LINE "A"

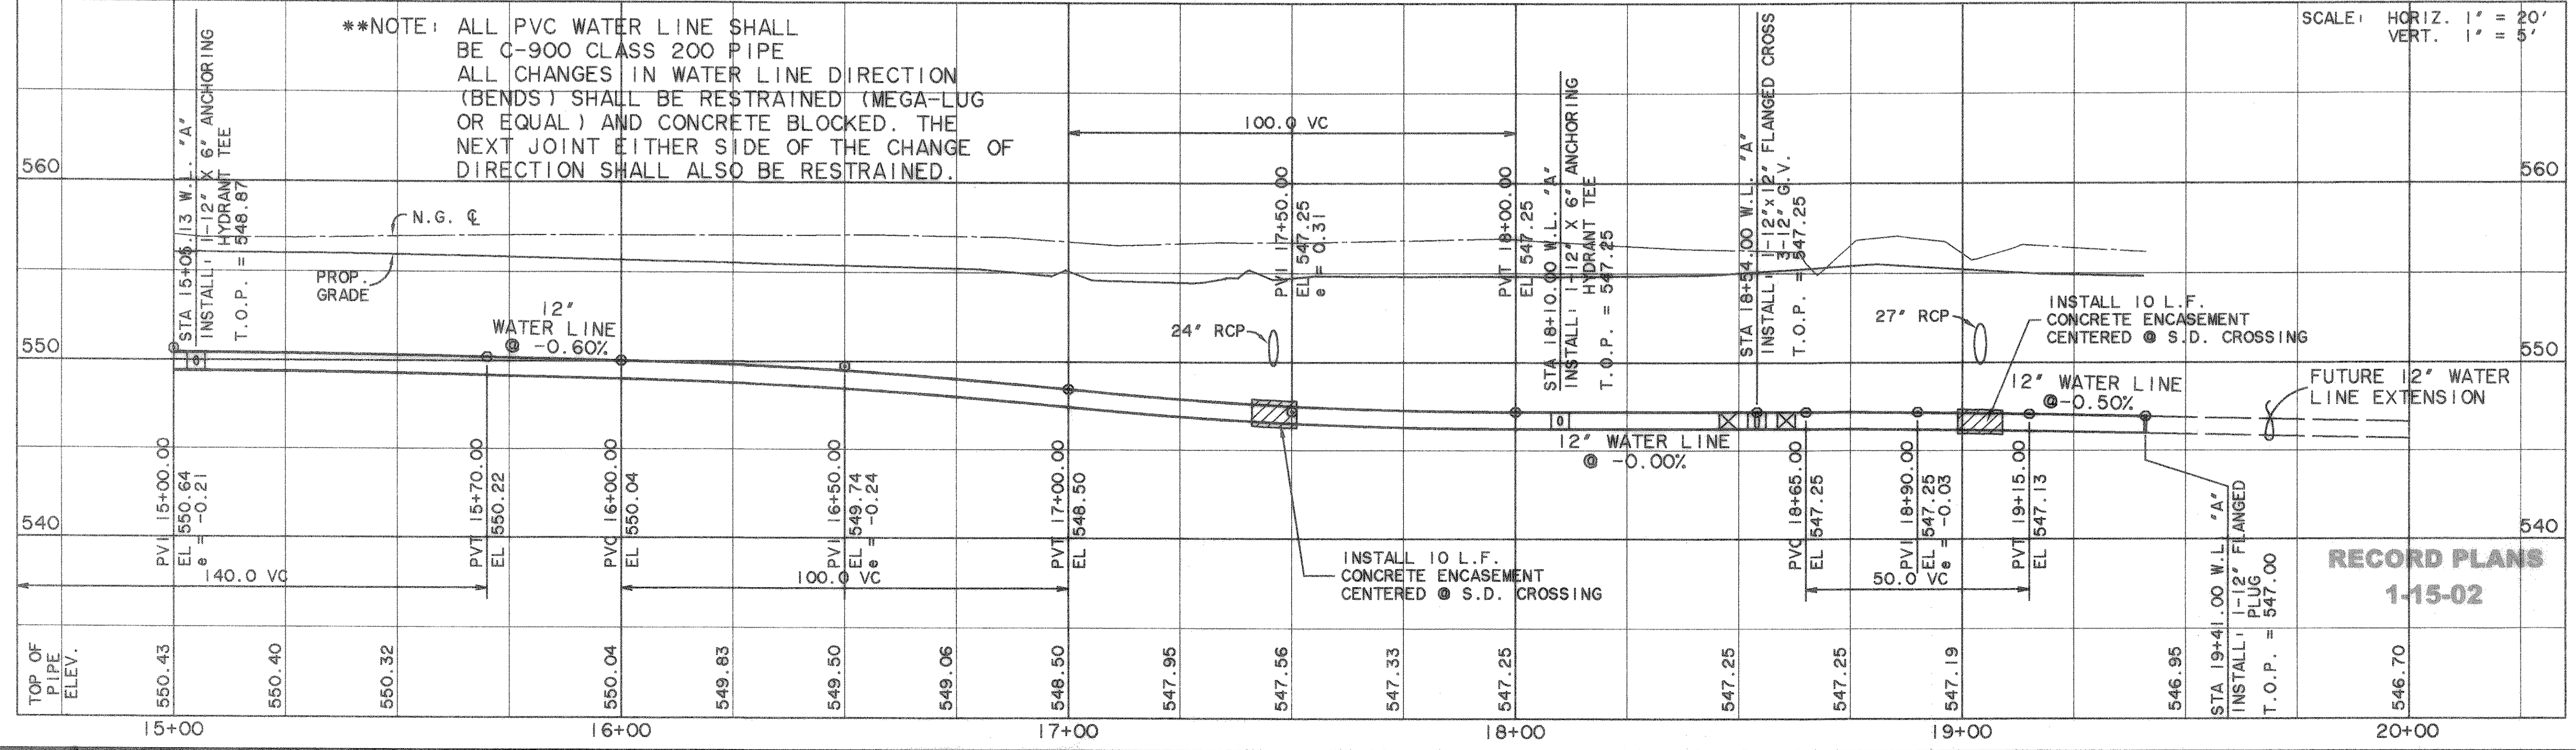


****NOTE: ALL PVC WATER LINE SHALL BE C-900 CLASS 200 PIPE ALL CHANGES IN WATER LINE DIRECTION (BENDS) SHALL BE RESTRAINED (MEGA-LUG OR EQUAL) AND CONCRETE BLOCKED. THE NEXT JOINT EITHER SIDE OF THE CHANGE OF DIRECTION SHALL ALSO BE RESTRAINED.**

SCALE: HORIZ. 1" = 20'
 VERT. 1" = 5'

RECORD PLANS
1-15-02

PREPARED BY:
VIA WIER & ASSOCIATES, INC.
 ENGINEERS SURVEYORS LAND PLANNERS
 4300 BELLEVUE PLACE SUITE 130 ARLINGTON, TEXAS 76018 METRO (817)467-7700
 4108 AMON CORDER BLVD. SUITE 200 FORT WORTH, TEXAS 76155 METRO (817)355-9437

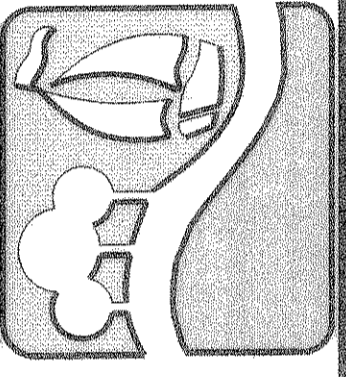

WATER LINE
PLAN & PROFILE
 STA 15+00 TO END



COPYRIGHT ©
 WIER & ASSOCIATES, INC.
 LAST SHEET EDIT
 DATE 11-28-99
 WA# 97057
SHEET NO.
38

TIME 14:10 FILE: WLPPII.dwg