


FILE: RALPH2B.dwg  
TIME: 11:48

SCALE = 5' VERT.  
= 10' HORIZ.


RECORD PLANS  
12-17-2002

STA 55+33 TO 56+25

PREPARED BY:  
**VIA WIER & ASSOCIATES, INC.**  
ENGINEERS SURVEYORS LAND PLANNERS  
430 BELTWAY PLACE SUITE 130 ARLINGTON, TEXAS 76010 METRO (817)467-7700  
4100 AMON CENTER BLVD. SUITE 200 FORT WORTH, TEXAS 76155 METRO (817)355-9457

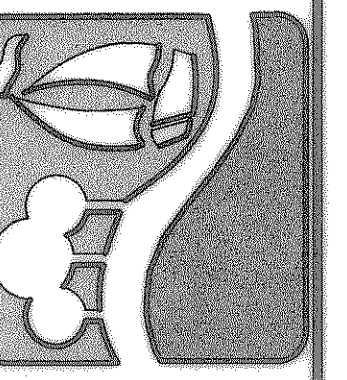

**RALPH HALL PARKWAY  
CROSS-SECTIONS**

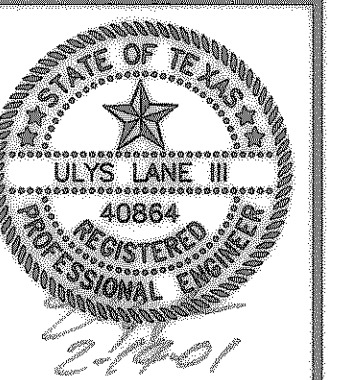

COPYRIGHT © WIER & ASSOCIATES, INC.  
LAST SHEET EDIT  
DATE 01-31-2001  
WA# 97057  
**SHEET NO. 58**