


TIME: 14:49  
FILE: RALPH2B.dwg

SCALE: " = 5' VERT.  
" = 10' HORIZ.


RECORD PLANS  
12-17-2002

STA 56+50 TO 58+00

PREPARED BY:  
**WIA WIER & ASSOCIATES, INC.**  
ENGINEERS SURVEYORS LAND PLANNERS  
4300 BELTWAY PLACE SUITE 130 ARLINGTON, TEXAS 76018 METRO (817)467-7700  
4100 AMAR CARRIER BLVD. SUITE 200 FORT WORTH, TEXAS 76105 METRO (817)355-9657

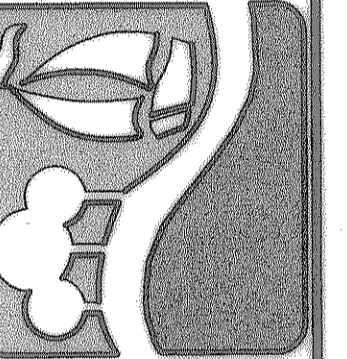

**RALPH HALL PARKWAY  
CROSS-SECTIONS**

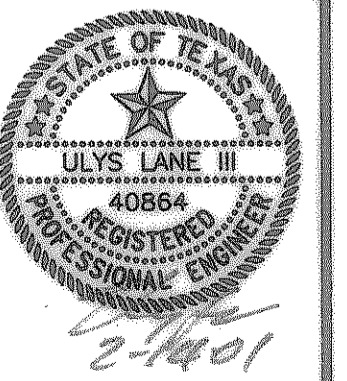

COPYRIGHT ©  
WIER & ASSOCIATES, INC.  
LAST SHEET EDIT  
DATE 01-31-2001  
WA# 97087  
**SHEET NO. 59**