



PREPARED BY:
VIA WIER & ASSOCIATES, INC.
 ENGINEERS SURVEYORS LAND PLANNERS
 4300 BELLEVUE PLACE SUITE 130 ARLINGTON, TEXAS 76010 METRO (817)467-7700
 4108 AUBURN CANTER BLVD. SUITE 200 FORT WORTH, TEXAS 76165 METRO (817)355-9457

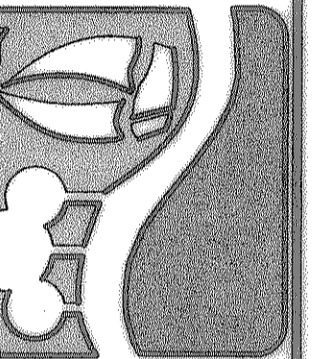

**RALPH HALL PARKWAY
 CROSS-SECTIONS**

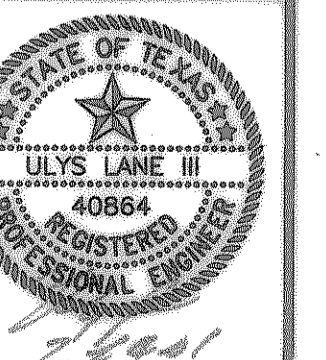

STATE OF TEXAS
 JULY LANE III
 40864
 REGISTERED PROFESSIONAL ENGINEER
 COPYRIGHT ©
 WIER & ASSOCIATES, INC.
 LAST SHEET EDIT
 DATE 01-31-2001
 WAA 97087
SHEET NO. 60