



FILE: STRIPA.dwg
TIME: 14:42

PREPARED BY:
VIA WIER & ASSOCIATES, INC.
ENGINEERS SURVEYORS LAND PLANNERS
4300 BELTWAY PLACE SUITE 130 ARLINGTON, TEXAS 76010 METRO (817) 467-7700
4108 AUBURN CREEK ROAD, SUITE 200 FORT WORTH, TEXAS 76165 METRO (817) 365-9437

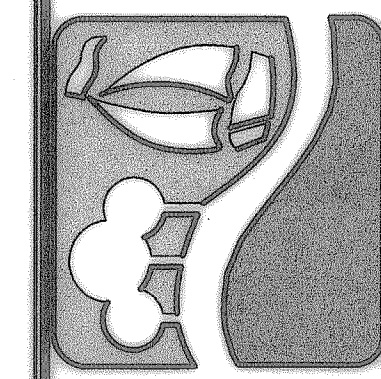

STRIPING LAYOUT
DETAIL

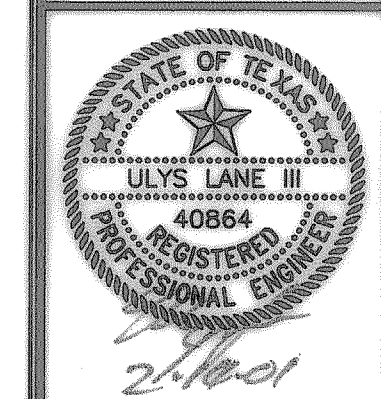

COPYRIGHT ©
WIER & ASSOCIATES, INC.
LAST SHEET EDIT
DATE 01-23-2001
WA# 97057
SHEET NO.
49