


FILE:RALPH2B.dwg
TIME:14:48

SCALE =5' VERT.
=10' HORIZ.


RECORD PLANS
12-17-2002

STA 60+50 TO 62+50

PREPARED BY:
VIA WIER & ASSOCIATES, INC.
ENGINEERS SURVEYORS & LAND PLANNERS
430 BELTWAY PLACE SUITE 130 ARLINGTON, TEXAS 76010 METRO (817)467-7700
4108 AMON CENTER BLVD. SUITE 200 FORT WORTH, TEXAS 76155 METRO (817)355-0457

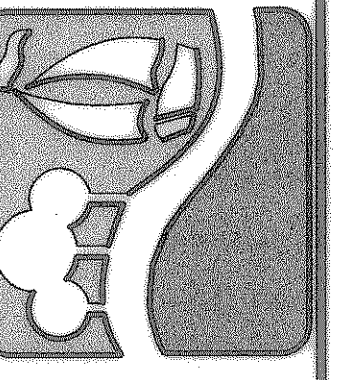

**RALPH HALL PARKWAY
CROSS-SECTIONS**

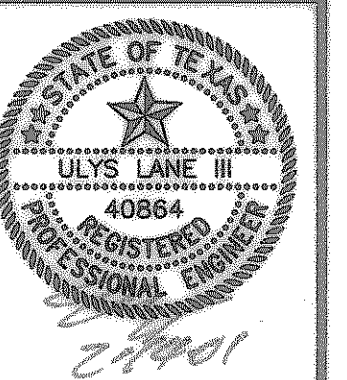

COPYRIGHT ©
WIER & ASSOCIATES, INC.
LAST SHEET EDIT
DATE 01-31-2001
WAW 97057
SHEET NO. 61