


FILE:RALPH2B.dwg
TIME:14:48

SCALE
" = 5' VERT.
" = 10' HORIZ.

RECORD PLANS
12-17-2002

PREPARED BY:
VIA WIER & ASSOCIATES, INC.
ENGINEERS SURVEYORS LAND PLANNERS
4300 BELLEVUE PLACE SUITE 130 ARLINGTON, TEXAS 76018 METRO (817)467-7700
4108 AMAR CENTER BLVD. SUITE 200 FORT WORTH, TEXAS 76105 METRO (817)350-947

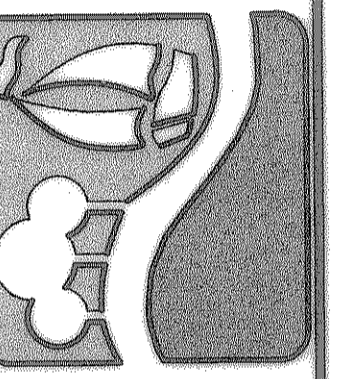

**RALPH HALL PARKWAY
CROSS-SECTIONS**

STATE OF TEXAS
JULYS LANE III
40864
REGISTERED
PROFESSIONAL ENGINEER
2-1401
COPYRIGHT ©
WIER & ASSOCIATES, INC.
LAST SHEET EDIT
DATE: 01-31-2001
W/A# 97087
SHEET NO.
62