


FILE:RALPH2B.dwg
TIME:14:48

SCALE
"=5' VERT.
"=10' HORIZ.


RECORD PLANS
12-17-2002

STA 65+25 TO 67+00

PREPARED BY:
VIA WIER & ASSOCIATES, INC.
ENGINEERS SURVEYORS LAND PLANNERS
4300 BELLEVUE PLACE SUITE 130 ARLINGTON, TEXAS 76010 METRO (817)467-7700
4108 MAJOR CARTER BLVD. SUITE 200 FORT WORTH, TEXAS 76105 METRO (817)355-9437

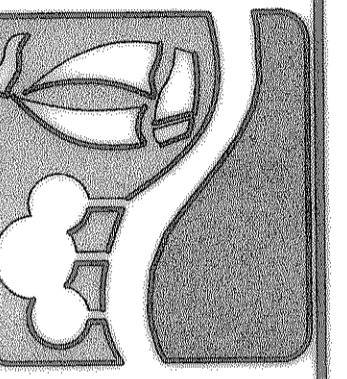

**RALPH HALL PARKWAY
CROSS-SECTIONS**

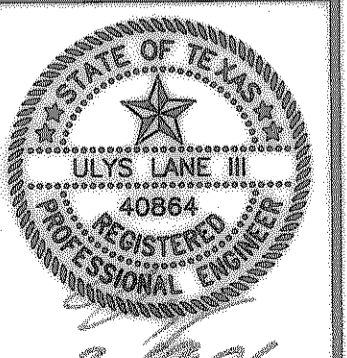

COPYRIGHT ©
WIER & ASSOCIATES, INC.
LAST SHEET EDIT
DATE 01-31-2001
WA# 97057
SHEET NO. 63