


TIME 14:48  
FILE:RALPH2B.dwg

SCALE =5' VERT.  
=10' HORIZ.


RECORD PLANS  
12-17-2002

STA 67+25 TO 69+00

PREPARED BY:  
**VIA WIER & ASSOCIATES, INC.**  
ENGINEERS SURVEYORS LAND PLANNERS  
4300 BELLEVUE PLACE SUITE 130 ARLINGTON, TEXAS 76010 METRO (817)467-7700  
4108 MAJOR CARTER BLVD. SUITE 200 FORT WORTH, TEXAS 76105 METRO (817)355-9437

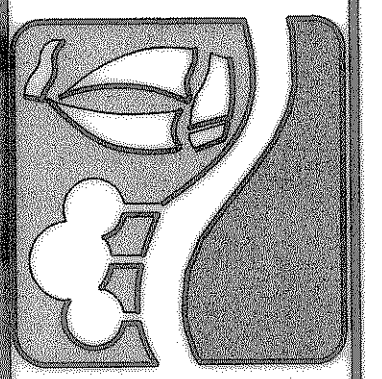

**RALPH HALL PARKWAY  
CROSS-SECTIONS**

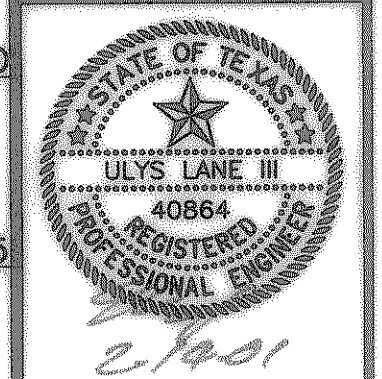

COPYRIGHT ©  
WIER & ASSOCIATES, INC.  
LAST SHEET EDIT  
DATE 01-31-2001  
WA# 97057  
**SHEET NO. 64**