


FILE:RALPH2B.dwg
TIME:14.48

SCALE "5' VERT.
"10' HORIZ.


RECORD PLANS
12-17-2002

STA 69+25 TO 71+50

PREPARED BY:
VIA WIER & ASSOCIATES, INC.
ENGINEERS SURVEYORS LAND PLANNERS
4300 BELTWAY PLACE SUITE 130 ARLINGTON, TEXAS 76018 METRO (817)467-7700
4100 AMON CENTER BLVD. SUITE 200 FORT WORTH, TEXAS 76165 METRO (817)352-9457

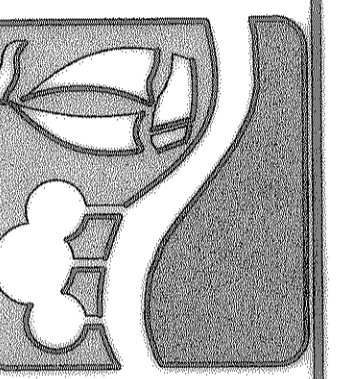

**RALPH HALL PARKWAY
CROSS-SECTIONS**

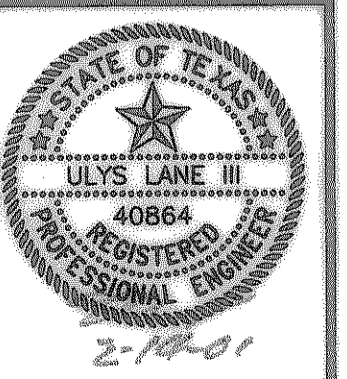

COPYRIGHT ©
WIER & ASSOCIATES, INC.
LAST SHEET EDIT
DATE 01-31-2001
WAS 97087

SHEET NO.
65