


FILE: RALPH2B.dwg  
TIME: 14.48


SCALE = 5' VERT.  
= 10' HORIZ.

RECORD PLANS  
12-17-2002

PREPARED BY:  
**VIA WIER & ASSOCIATES, INC.**  
ENGINEERS SURVEYORS & ASSOCIATES LAND PLANNERS  
4300 BELTWAY PLACE SUITE 130 ARLINGTON, TEXAS 76018 METRO (817)467-7700  
4408 AMON CREEK ROAD, SUITE 200 FORT WORTH, TEXAS 76165 METRO (817)355-4457

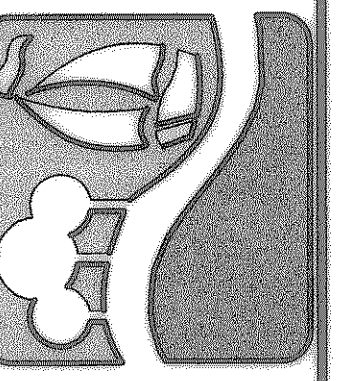

**RALPH HALL PARKWAY  
CROSS-SECTIONS**

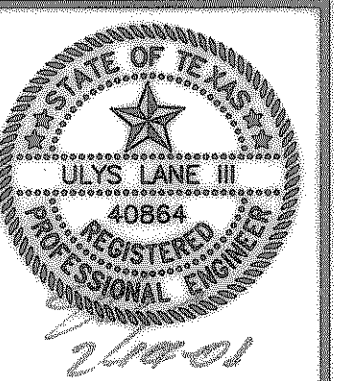

COPYRIGHT ©  
WIER & ASSOCIATES, INC.  
LAST SHEET EDIT  
DATE 01-31-2001  
WA# 97057  
**SHEET NO. 66**