


FILE: RALPH2B.dwg
TIME: 14.48


SCALE 1"=5' VERT.
1"=10' HORIZ.

RECORD PLANS
12-17-2002

PREPARED BY:
VIA WIER & ASSOCIATES, INC.
ENGINEERS SURVEYORS LAND PLANNERS
4300 BELTWAY PLACE SUITE 130 ARLINGTON, TEXAS 76016 METRO (817)467-7700
4105 AMON CENTER BLDG. SUITE 200 FORT WORTH, TEXAS 76165 METRO (817)335-4437

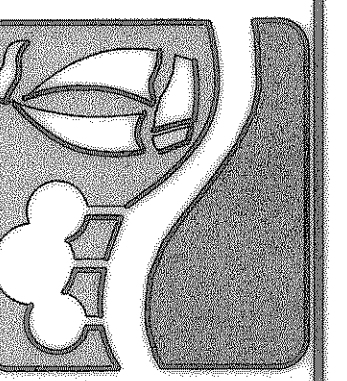

**RALPH HALL PARKWAY
CROSS-SECTIONS**

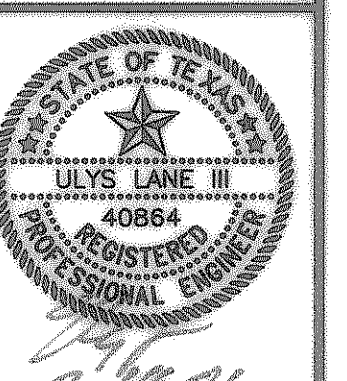

COPYRIGHT ©
WIER & ASSOCIATES, INC.
LAST SHEET EDIT
DATE 01-31-2001
WA# 97057
SHEET NO. 67